

APPLICATION

FOR PERCOLATION TESTING AND SITE EVALUATION

TEST DATE(S) _____ TEST TIME _____

AP 520897

AGENCY REVIEW: _____

DATE 9/9/04

DO NOT WRITE ABOVE THIS LINE

I HEREBY APPLY FOR THE NECESSARY TESTING/EVALUATION PRIOR TO ISSUANCE OF SEWAGE DISPOSAL SYSTEM PERMIT(S) TO:

CHECK AS NEEDED:

- CONSTRUCT NEW SEPTIC SYSTEM(S)
- REPAIR/ADD TO AN EXISTING SEPTIC SYSTEM
- REPLACE AN EXISTING SEPTIC SYSTEM

CHECK AS NEEDED:

- NEW STRUCTURE(S)
- ADDITION TO AN EXISTING STRUCTURE
- REPLACE AN EXISTING STRUCTURE

CHECK ONE:

- CREATE NEW LOT(S)
- BUILD ON AN EXISTING LOT IN A SUBDIVISION
- BUILD ON AN EXISTING PARCEL OF RECORD

IS THE PROPERTY WITHIN 2500' OF ANY RESERVOIR?

- YES
- NO

THE TYPE OF STRUCTURE IS:

- RESIDENTIAL WITH 4 PROPOSED BEDROOMS IN THE COMPLETED STRUCTURE (NOTE UNKNOWN IF APPROPRIATE)
- COMMERCIAL (PROVIDE DETAIL OF NUMBERS AND TYPES OF EMPLOYEES/ CUSTOMERS ON ACCOMPANYING PLAN)
- INSTITUTIONAL/GOVERNMENT (PROVIDE DETAIL OF NUMBERS AND TYPES OF EMPLOYEES/USERS ON ACCOMPANYING PLAN)

PROPERTY OWNER(S) OTHA UPGURCH

DAYTIME PHONE: _____ CELL _____ FAX _____

MAILING ADDRESS 457 OLD ORCHARD CIRCLE MILLEERSVILLE MD 21108
STREET CITY/TOWN STATE ZIP

APPLICANT FISHER COLLINS & CARTER, INC.

DAYTIME PHONE 410-461-2855 CELL _____ FAX 410-750-3784

MAILING ADDRESS 10272 BALTIMORE NAT'L AVE ELLCOTT CITY MD 21042
STREET CITY/TOWN STATE ZIP

APPLICANT'S ROLE: DEVELOPER BUILDER BUYER RELATIVE/FRIEND REALTOR CONSULTANT

PROPERTY LOCATION
SUBDIVISION/PROPERTY NAME FULTON MANOR II LOT NO. NEW LOT 2

PROPERTY ADDRESS PLEASANT VIEW DRIVE HIGHLAND
STREET TOWN/POST OFFICE


TAX MAP PAGE(S) 40 GRID 6 PARCEL(S) P/B 205 PROPOSED LOT SIZE 3.01 ac ±

AS APPLICANT, I UNDERSTAND THE FOLLOWING: THE SYSTEM INSTALLED SUBSEQUENT TO THIS APPLICATION IS ACCEPTABLE ONLY UNTIL PUBLIC SEWERAGE IS AVAILABLE. THIS APPLICATION IS COMPLETE WHEN ALL APPLICABLE FEES AND A SUITABLE SITE PLAN HAVE BEEN RECEIVED. I ACCEPT THE RESPONSIBILITY FOR COMPLIANCE WITH ALL M.O.S.H.A. AND "MISS UTILITY" REQUIREMENTS. APPROVAL IS BASED UPON SATISFACTORY REVIEW OF A PERG CERTIFICATION PLAN.

TEST RESULTS WILL BE MAILED TO APPLICANT. [Signature]
SIGNATURE OF APPLICANT

HOWARD COUNTY HEALTH DEPARTMENT, BUREAU OF ENVIRONMENTAL HEALTH, WELL AND SEPTIC PROGRAM
3525-H ELLICOTT MILLS DRIVE, ELLICOTT CITY, MARYLAND 21043-4544 (410) 313-1771 FAX (410) 313-2648
TDD (410) 313-2323 TOLL FREE 1-877-4MD-DHMH

A/P 2758
 2pl Trace Rx
 2'
 Dense rd CL
 Trace Rx
 6'
 Hbrn LS-S
 Trace Rx
 Bottom
 12'

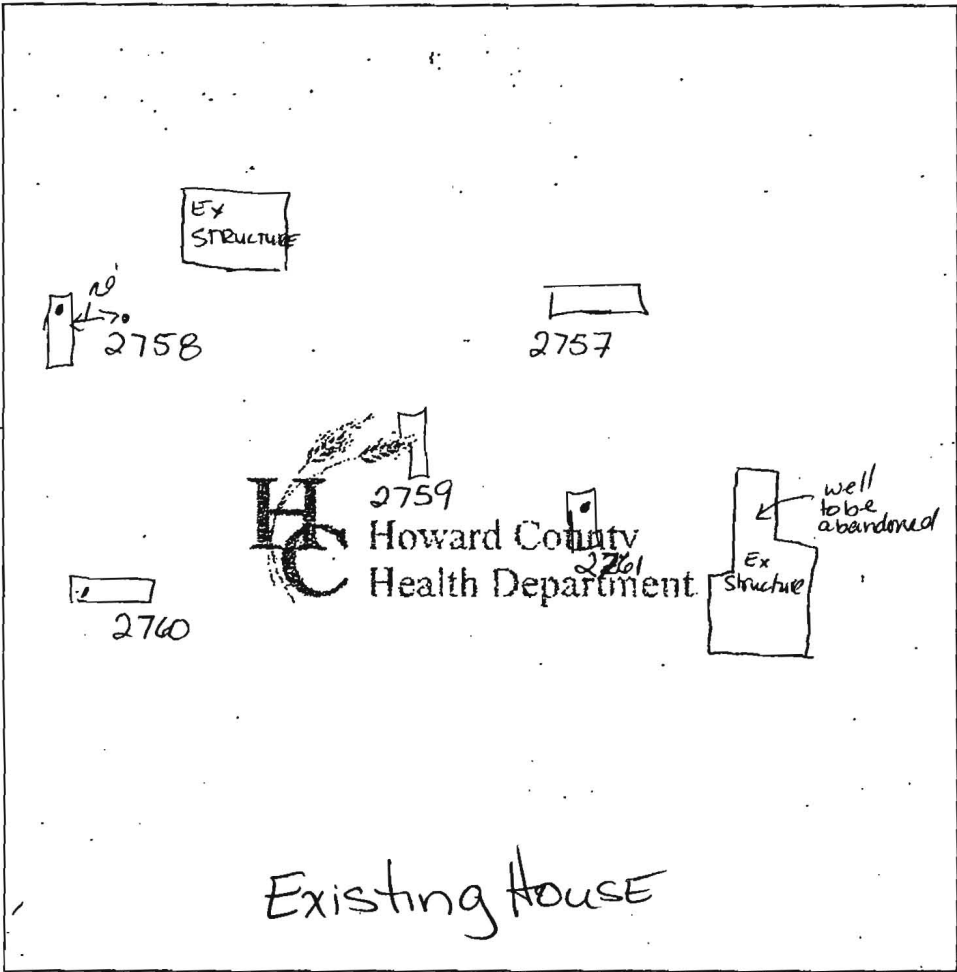


2757
 Str red CL
 5'
 RED L pocket
 6'
 Hbrn f.S
 Trace Rx
 Bottom
 12 1/2'

2760
 STR RED CL
 4'
 TRANSITION CLAY & SAND
 5 1/2 - 6'
 Hbrn f SAND
 v. fr. smpolete frag 27006
 Bottom
 12 1/2'

2761
 Str red CL
 Gtz frag 5% pockets of SiL in Clay L
 5'
 Hbrn fine SAND w/ few pockets LS
 - 9' Schist (chert) pocket
 Bottom
 12 1/2'

DATE	TEST #	DEPTH	START	BREAK 1" DROP	STOP 2" DROP	TIME OF 2nd INCH	P/F/H
11-23-04	2758	6' S / 12V	2:27	2:30	2:34	4	P
	2760	6' M / 12 1/2	2:38 ⁵⁰	2:42	2:51	9	P
	2759	Visual					OK
	2761	6 1/2' / 12 1/2 V	2:45	2:50	2:55	5	P
	2757	5 1/2 S / 12 1/2	2:55 ³⁰	2:59	3:04	5	P

2759
 Str. rd clay loam
 Trace Rx
 rd SiCL
 7'
 Hbrn f SAND
 Bottom
 13'

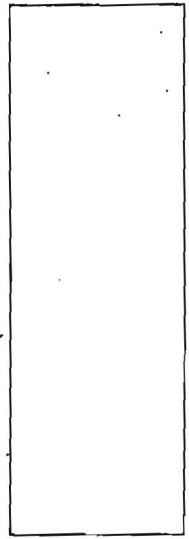

REMARKS Holes dug per plan
 SANITARIAN KN BACKHÖE Kettmanns OTHERS _____
 TEST HOLES USED IN SDA _____ AVG. PERC TIME 7 SQ. FT/BR 180
 TRENCH WIDTH 3 INLET DEPTH 5 MAX. BOT DEPTH 7 EFFECTIVE SW 2'



FOREST CONSERVATION EASEMENT No. 3
 0.80 AC.±
 (PLANTING) FOR HAMMOND'S PROMISE OVERLOOK (SDP 06-158)

HALL SHOP ROAD
 (MAJOR COLLECTOR ROADWAY)

PLEASANT VIEW DRIVE
 (50' R/W) (LOCAL ROAD)
 (COUNTY MAINTAINED)

Rev. PC
 Signed 12/19/06

PLAN

SCALE: 1" = 100'