

APPLICATION

PERCOLATION TESTING

A 43244
P _____

HOWARD COUNTY HEALTH DEPARTMENT
BUREAU OF ENVIRONMENTAL HEALTH
P.O. BOX 476 ELLICOTT CITY, MARYLAND 21043
TELEPHONE: 461-9933

DISTRICT _____

DATE _____

TO: THE COUNTY HEALTH OFFICER
ELLICOTT CITY, MARYLAND

I, HEREBY, APPLY FOR THE NECESSARY TEST IN ORDER TO CONSTRUCT (OR RECONSTRUCT) A SEWAGE DISPOSAL SYSTEM.

PROPERTY OWNER _____

ADDRESS _____ PHONE _____

PROSPECTIVE BUYER _____

ADDRESS _____ PHONE _____

PROPERTY LOCATION:

SUBDIVISION SYCAMORE VALLEY LOT NO. #4

ROAD AND DESCRIPTION _____

TAX MAP 21 PARCEL # 6

SIZE OF LOT _____ TYPE BLDG. _____
(SINGLE FAMILY DWELLING OR COMMERCIAL)

THE SYSTEM INSTALLED UNDER THIS APPLICATION IS ACCEPTABLE ONLY UNTIL PUBLIC FACILITIES BECOME AVAILABLE. I FULLY UNDERSTAND THE FEE CONNECTED WITH THE FILING OF THIS PERC TEST APPLICATION IS NON-REFUNDABLE UNDER ANY CIRCUMSTANCES. I ALSO AGREE TO COMPLY WITH ALL M.O.S.H.A. REQUIREMENTS IN TESTING THIS LOT.

(SIGNATURE OF APPLICANT)

APPROVED BY _____ FOR _____ DATE _____

REJECTED BY _____ FOR _____ DATE _____

HOLD PENDING FURTHER TESTS _____ DATE _____

REASONS FOR REJECTION OR HOLDING _____

HD-216

THIS IS NOT A PERMIT

(MORE-TESTS)

SYCAMORE VALLEY


AFTER WATER WELL SYSTEM FIRST

FOR VISUALS

#4 NEW

A# 43244

SOIL PROFILE

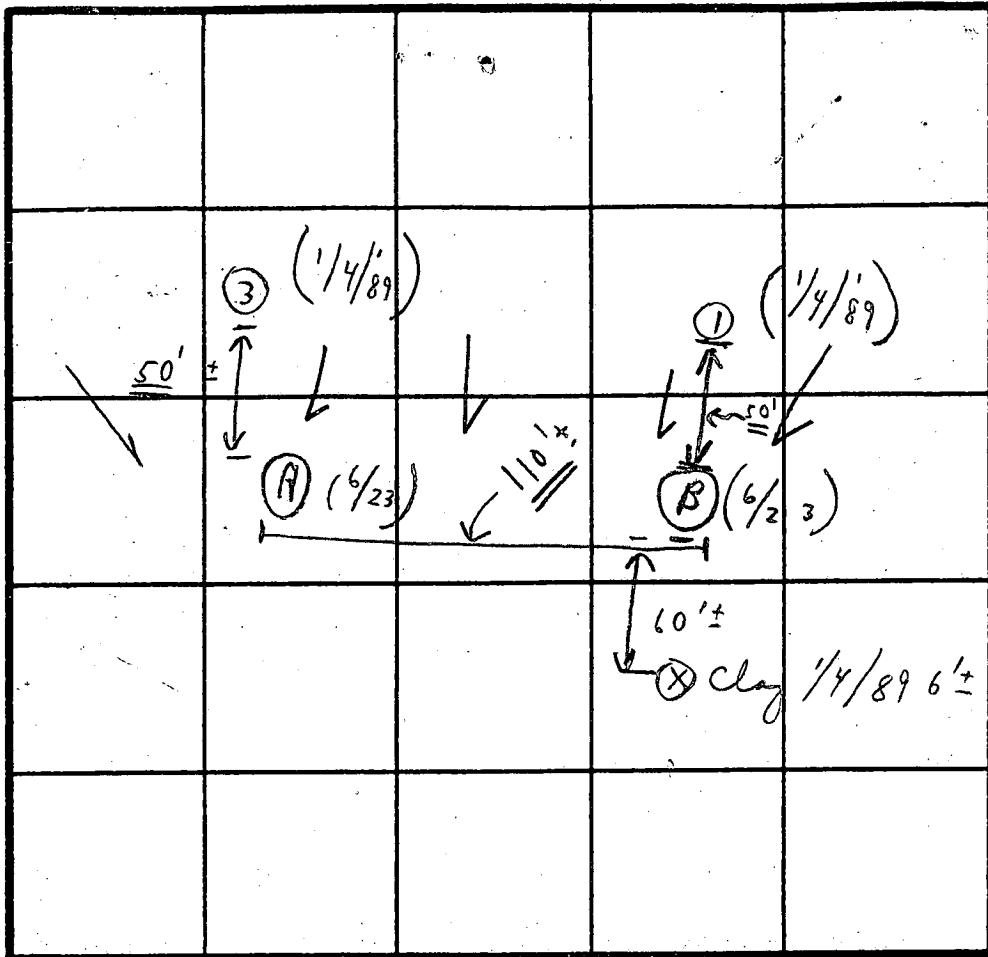

12,000+
(Sewage Easement area)
7/6
C. Williams
+ 6 Bd

INDICATE NORTH - NAME ADJOINING ROADWAY AS BASE LINE.

RT 97

DATE	TEST NO.	DEPTH	PRE-WET		TEST - 1" DROP		TIME
			START	STOP	START	STOP	
6/23/89	(A)	1' to 5'±	Clay	:	:	X	X
#LOT		5' to 2'	"	LOA	M	Water @ 2'	X to 12' / 2 holes
THIS DRY	(B)	1' to 5'±	Clay			X	X
1'		(5'± to 8'±)	"	LOA	M	X	Water @ 8'± to 12' Water
6/23/89	(No other holes dug)						
	(4)						

REMARKS 6/23 Tests in field; tests per 50'± from other
Hole (B) 50'± from #1

TYPE OF SOIL

TESTED BY

C. B. J.

ALSO PRESENT

{O. Ketterman} Pg 2 of 2

+ son + helper

APPLICATION

New 4

PERCOLATION TESTING

A 43244

P _____

HOWARD COUNTY HEALTH DEPARTMENT
BUREAU OF ENVIRONMENTAL HEALTH
P.O. BOX 476 ELLICOTT CITY, MARYLAND 21043
TELEPHONE: 461-9933

DISTRICT 4

DATE 12/9/88

TO THE COUNTY HEALTH OFFICER
ELLICOTT CITY, MARYLAND

I HEREBY APPLY FOR THE NECESSARY TEST IN ORDER TO CONSTRUCT (OR RECONSTRUCT) A SEWAGE DISPOSAL SYSTEM.

PROPERTY OWNER John/JAMIE Buork
Egwood Farm Inc c/o Land Design + Development

ADDRESS 8307 Main St PHONE 461-4620

PROSPECTIVE BUYER N/A

ADDRESS _____ PHONE _____

PROPERTY LOCATION:
SUBDIVISION Stark Sycamore Valley LOT NO. 7 New #
~~4~~

ROAD AND DESCRIPTION Roxbury + Dorsey Mill (3620 Broadleaf Creek Rd)

TAX MAP 21 PARCEL # 6
SIZE OF LOT - 3.0 AC. TYPE BLDG. SFD - 4Brm
(SINGLE FAMILY DWELLING OR COMMERCIAL)

BLDG. PERMIT SIGNED
AND RETURNED 9/20/96
Senath B 0010145-7

THE SYSTEM INSTALLED UNDER THIS APPLICATION IS ACCEPTABLE ONLY UNTIL PUBLIC FACILITIES BECOME AVAILABLE. I FULLY UNDERSTAND THE FEE CONNECTED WITH THE FILING OF THIS PERC TEST APPLICATION IS NON-REFUNDABLE UNDER ANY CIRCUMSTANCES. I ALSO AGREE TO COMPLY WITH ALL M.O.S.H.A. REQUIREMENTS IN TESTING THIS LOT.

Mal D. Ken
(SIGNATURE OF APPLICANT)

APPROVED BY _____ FOR _____ DATE _____

REJECTED BY _____ FOR _____ DATE _____

HOLD PENDING FURTHER TESTS _____ DATE _____

REASONS FOR REJECTION OR HOLDING _____

HD-216

THIS IS NOT A PERMIT

