

SITE INSPECTION SHEET

OWNER: _____ PHONE #: _____


ADDRESS: 8390 Park Dr CONTRACTOR: _____

WELL TAG #: _____

SUBDIVISION: _____ LOT: _____ COUNTY #: _____

PROPOSAL: _____

LOCATION DIAGRAM

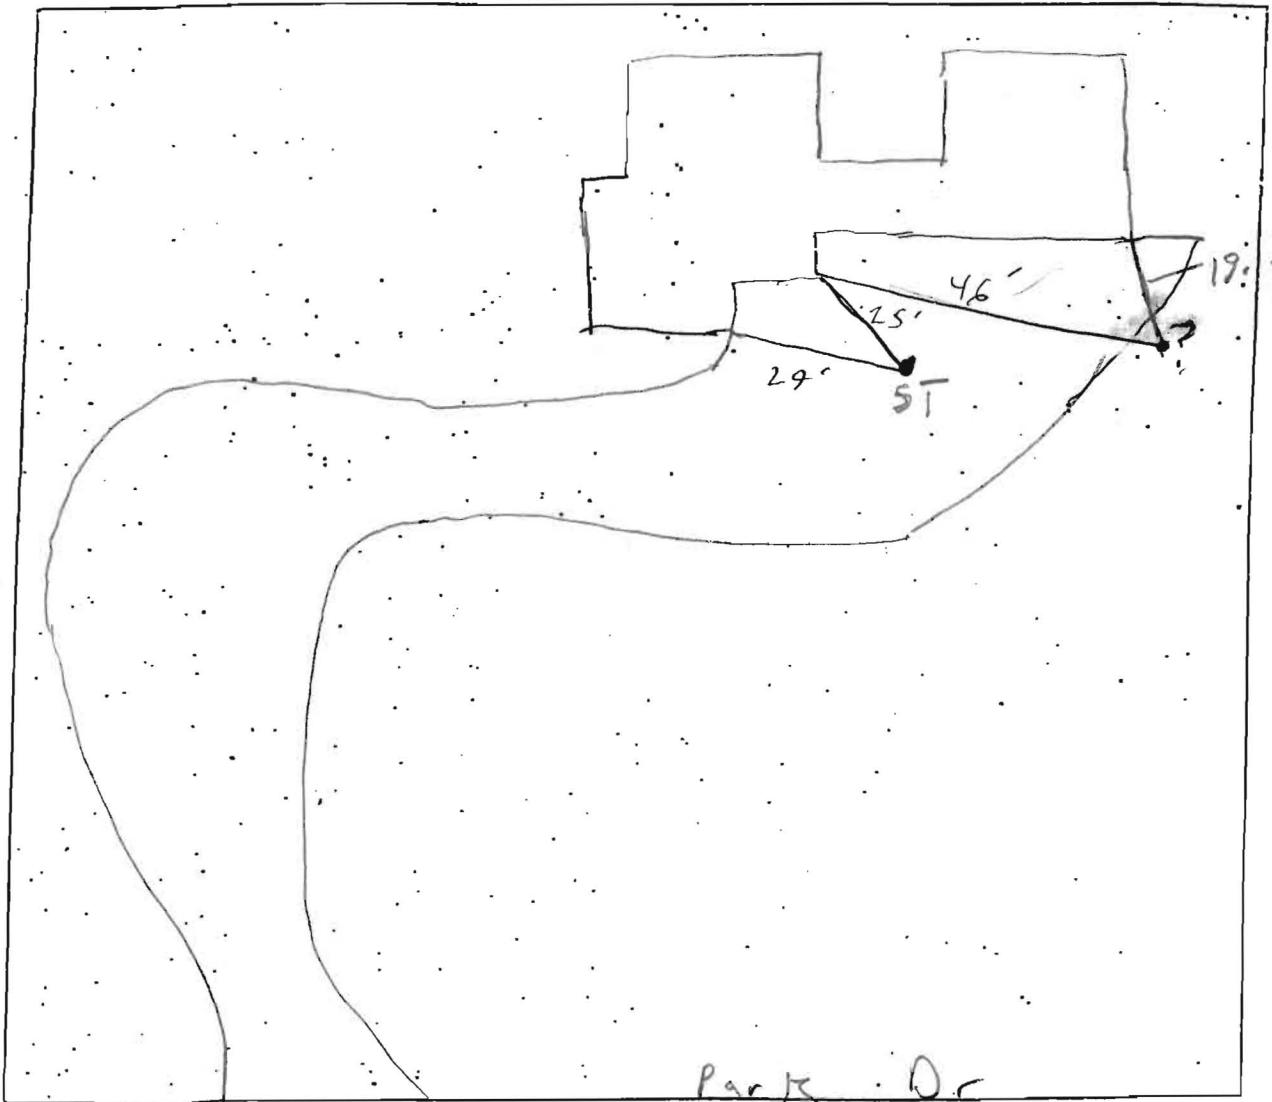

COMMENTS: _____
