

SITE INSPECTION SHEET

OWNER: _____ PHONE #: _____


ADDRESS: 8380 Park Dr. CONTRACTOR: _____

_____ WELL TAG #: _____

SUBDIVISION: _____ LOT: _____ COUNTY #: _____

PROPOSAL: _____

LOCATION DIAGRAM

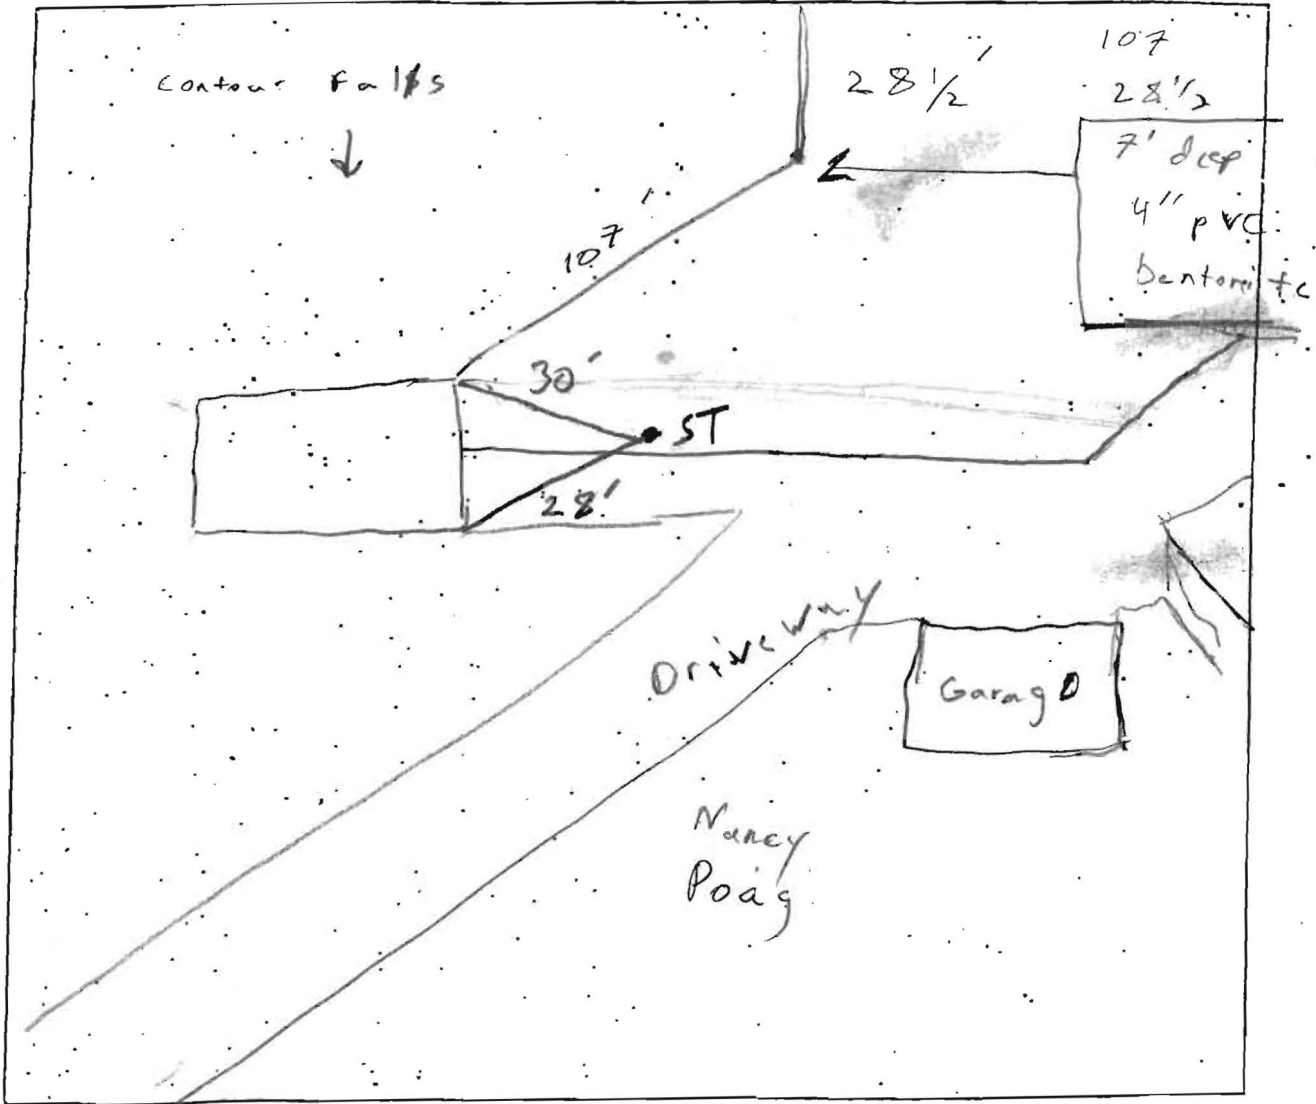

COMMENTS: _____
