

16109 Frederick Road
SITE INSPECTION SHEET Well Location

OWNER: _____ PHONE #: _____


ADDRESS: 16109 Frederick Road CONTRACTOR: _____

Lisbon 21765 WELL TAG #: No Tag

SUBDIVISION: _____ LOT: _____ COUNTY #: _____

PROPOSAL: Well location at 'liquor store' on Rte 144
in relation to development across Rte 144.

LOCATION DIAGRAM

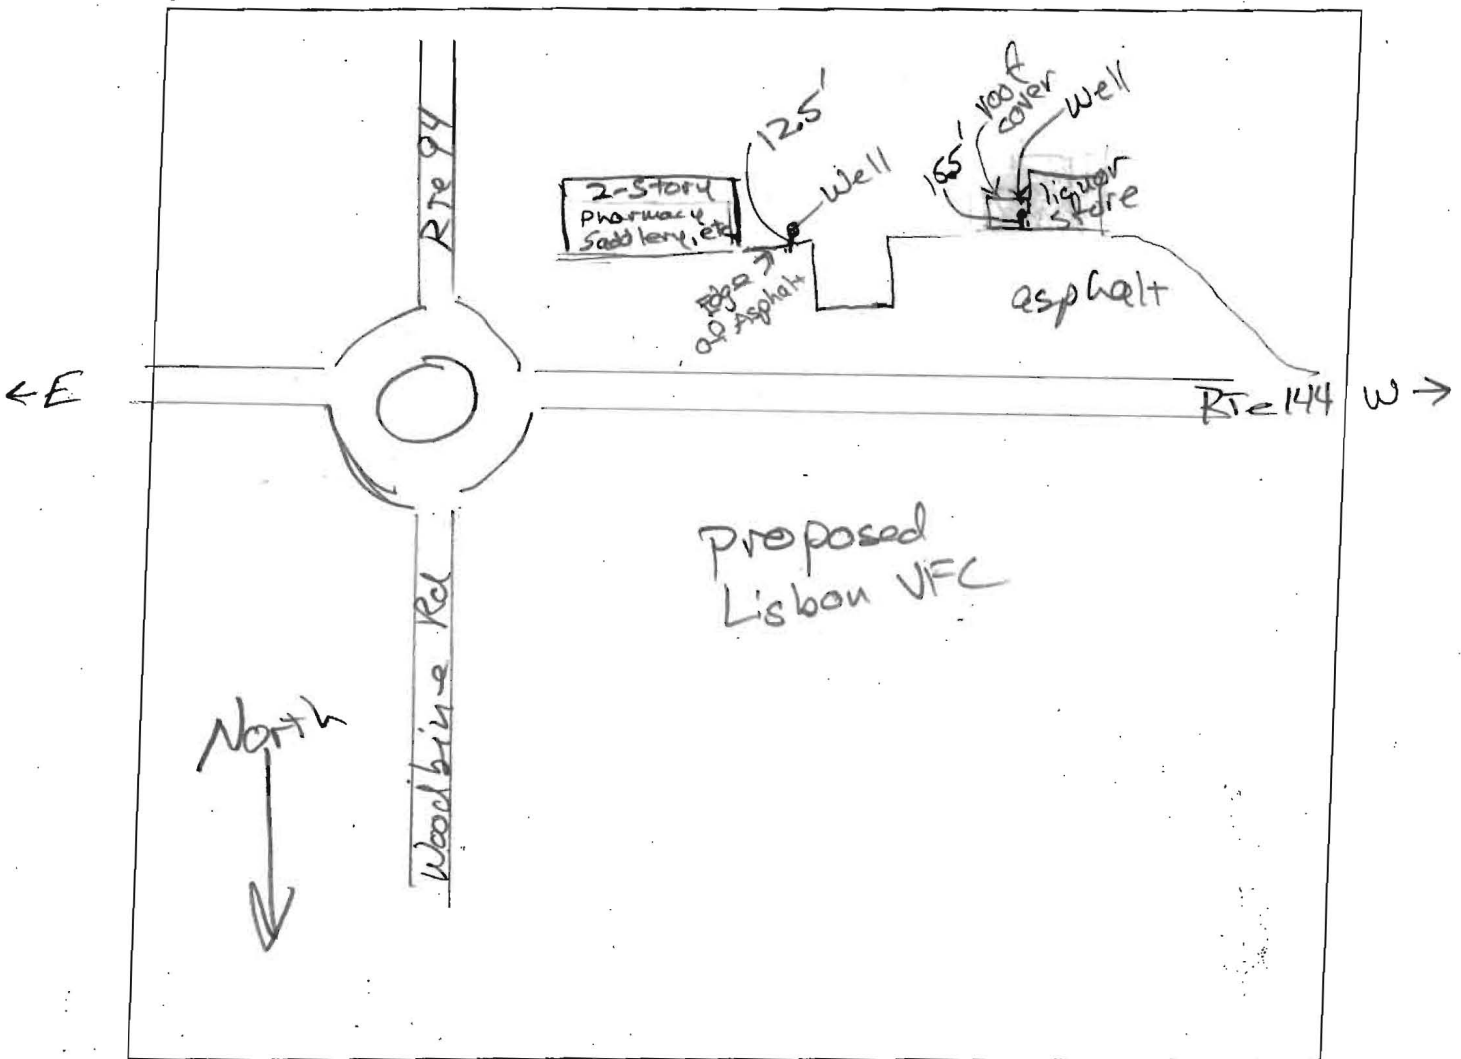

COMMENTS: Well at 'liquor store' and well on adjacent
property are both more than 100' from proposed
bio retention facility on opposite side of
Rte 144 (Frederick Road).

DATE: 6/14/17 INSPECTOR: R Bricker