
WATER WELL ABANDONMENT-SEALING REPORT FORM

SUBMIT COPIES OF COMPLETED FORM TO:

- * COUNTY ENVIRONMENTAL AGENCY (contact MDE, WMA if address needed)
- * WELL OWNER
- * MDE, WATER MANAGEMENT ADMINISTRATION, WELL PROGRAM

* No well completion form
Approved (Signature)
4/13/17

DATE WELL ABANDONED: 2/27/17 (month/day/year)

- * PERMIT NUMBER OF ABANDONED WELL (if any)
- * PERMIT NUMBER OF REPLACEMENT WELL:

HD - 73 - 2248

PERSON ABANDONING WELL: Michael Bartow


WELL DRILLER'S LICENSE NUMBER: 355

OWNER'S NAME: Development Partners LLC

CIRCLE: MWD / MSD / MGD

WELL LOCATION:
COUNTY: Howard
NEAREST TOWN: LAUREL
TAX MAP 50 BLOCK 2 PARCEL 257
SUBDIVISION:
SECTION: LOT:
STREET ADDRESS: 9801 Baltimore Avenue

SITE LOCATION MAP

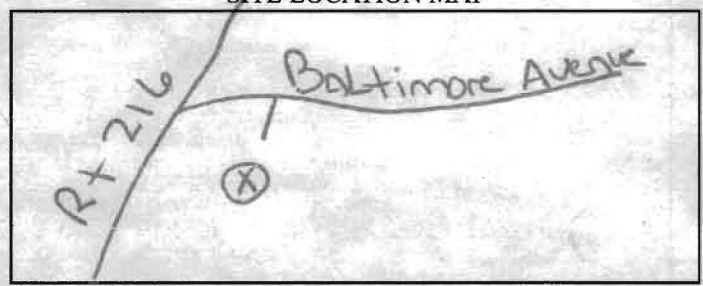

LATITUDE 3 9 . 1 1 0 50 _
LONGITUDE 7 6 . 8 5 2 3 2 _

LOG OF SEALING MATERIAL

MATERIAL	FEET	
	FROM	TO
Bentonite CLAY	180	0

- * TYPE OF WELL BEING ABANDONED:
 DRILLED JETTED
 BORED HAND DUG
 OTHER (specify) _____

- * USE CODE:
 DOMESTIC MUNICIPAL/PUBLIC
 IRRIGATION INDUSTRIAL
 TEST/OBSERVATION GEOTHERMAL

VOLUME OF MATERIAL USED

1750 lbs Bentonite / 250 Bentonite
1 Hole PLUG / Grout w/ 12.5 gal water

- * TYPE OF CASING:
 STEEL PLASTIC
 CONCRETE OTHER (specify) _____

SIZE OF CASING: 6 INCHES IN DIAMETER

DEPTH OF WELL: 180 FEET DEEP

WAS ANY CASING REMOVED? YES NO
If yes, length removed, in feet: _____

WAS CASING RIPPED OR PERFORATED? YES NO

SIGNATURE-MASTER WELL DRILLER OR SUPERVISING SANITARIAN LICENSE#

355

MWD / MSD / MGS
CIRCLE ONE

2/28/17 DATE

COUNTY

Pursuant to § 10-624 of the State Govt. Article of the Maryland Code, personal info requested on this form is used in processing this form pursuant to COMAR 26.04.04. Failure to provide the info may result in this form not being processed. You have the right to inspect, amend, or correct this form. The Maryland Department of the Environment is subject to the Maryland Public Information Act. This form may be made available on the Internet via MDE's website and is subject to inspection or copying, in whole or in part, by the public and other governmental agencies, if not protected by federal or State Law.



Bureau of Environmental Health
7178 Columbia Gateway Drive, Columbia, MD 21046-2147
Main: 410-313-2640 | Fax: 410-313-2648
TDD 410-313-2323 | Toll Free 1-866-313-6300
www.hchealth.org
Facebook: www.facebook.com/hocohealth
Twitter: HowardCoHealthDep

Maura J. Rossman, M.D., Health Officer

MEMORANDUM

Sent via email to theresa@cornerstone-homes.com 7/8/2014

TO: Cornerstone Homes, Inc.
ATTN: Theresa Chevery

FROM: Kevin M. Wolf, R.E.H.S./R.S., LEHS
HCHD, Well & Septic Program
Groundwater Mgmt. Sec.

DATE: July 7th, 2014

RE: **9801 Baltimore Ave**
Laurel, MD 20723
M. 50, G.2 P. 257– 4.87AC
(Demolition of existing structure – rebuild new subdivision)

This is to advise that the Howard County Health Department recommends issuance of the demolition permit for the above referenced property.

No wells or septic components were found on the subject property. According to public utility records, this parcel is currently connected to public water and will remain so. Current utility records show this parcel has both water and sewer access. Public water was connected on 8/22/1984 and public sewer was connected on 11/23/1979 respectively. If plans to re-build on this parcel, you will need to reconnect to public water and sewer per Howard County code.

If any wells or septic systems are found during site work, you must notify this office immediately!

KMW
Cc: File