

\*\*\*\*\*  
WATER WELL ABANDONMENT-SEALING REPORT FORM  
\*\*\*\*\*

SUBMIT COPIES OF COMPLETED FORM TO:

- \* COUNTY ENVIRONMENTAL AGENCY (contact MDE, WMA if address needed)
- \* WELL OWNER
- \* MDE, WATER MANAGEMENT ADMINISTRATION, WELL PROGRAM

OK  
J  
4/13/17

DATE WELL ABANDONED: 3/08/17 (month/day/year)

\* PERMIT NUMBER OF ABANDONED WELL (if any) \_\_\_\_\_

\* PERMIT NUMBER OF REPLACEMENT WELL: \_\_\_\_\_


\* PERSON ABANDONING WELL: ROBERT COPSEY WELL DRILLER'S LICENSE NUMBER: \_\_\_\_\_

CIRCLE: MWD / MSD / MGD

\* OWNER'S NAME: DAVID FRANKLIN

SITE LOCATION MAP

\* WELL LOCATION:  
COUNTY: HOWARD  
NEAREST TOWN: COLUMBIA  
TAX MAP 0041 BLOCK \_\_\_\_\_ PARCEL 0174  
SUBDIVISION: 0000  
SECTION: \_\_\_\_\_ LOT: 12  
STREET ADDRESS: 10622 HUNTING LAKE

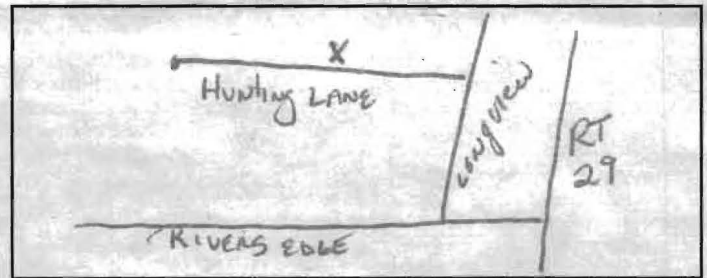

LATITUDE 3 9 . 1 0 4 1 2 9

LONGITUDE 7 6 . 5 2 5 4 7 1

LOG OF SEALING MATERIAL

\* TYPE OF WELL BEING ABANDONED:  
 DRILLED \_\_\_\_\_ JETTED  
 BORED \_\_\_\_\_ HAND DUG  
 OTHER (specify) \_\_\_\_\_

MATERIAL	FEET	
	FROM	TO
Bentonite clay	91	5
clean fill	5	0

\* USE CODE:  
 DOMESTIC \_\_\_\_\_ MUNICIPAL/PUBLIC  
 IRRIGATION \_\_\_\_\_ INDUSTRIAL  
 TEST/OBSERVATION \_\_\_\_\_ GEOTHERMAL

VOLUME OF MATERIAL USED

\* TYPE OF CASING:  
 STEEL \_\_\_\_\_ PLASTIC  
 CONCRETE \_\_\_\_\_ OTHER (specify) \_\_\_\_\_

110 lbs bentonite clay

SIZE OF CASING: 6" INCHES IN DIAMETER

DEPTH OF WELL: 91 FEET DEEP

WAS ANY CASING REMOVED?  YES \_\_\_\_\_ NO  
If yes, length removed, in feet: 5

WAS CASING RIPPED OR PERFORATED? \_\_\_\_\_ YES  NO

Pursuant to § 10-624 of the State Govt. Article of the Maryland Code, personal info requested on this form is used in processing this form pursuant to COMAR 26.04.04. Failure to provide the info may result in this form not being processed. You have the right to inspect, amend, or correct this form. The Maryland Department of the Environment is subject to the Maryland Public Information Act. This form may be made available on the Internet via MDE's website and is subject to inspection or copying, in whole or in part, by the public and other governmental agencies, if not protected by federal or State Law.

SIGNATURE-MASTER WELL DRILLER OR SUPERVISING SANITARIAN LICENSE#

Robert P. Copsey

MWD / MSD / MGS

CIRCLE ONE

DATE

3/08/17

COUNTY