

\*\*\*\*\*  
WATER WELL ABANDONMENT-SEALING REPORT FORM  
\*\*\*\*\*

SUBMIT COPIES OF COMPLETED FORM TO:

- \* COUNTY ENVIRONMENTAL AGENCY (contact MDE, WMA if address needed)
- \* WELL OWNER
- \* MDE, WATER MANAGEMENT ADMINISTRATION, WELL PROGRAM

*Approved*  
*07/10/2017*  
*(Signature)*

DATE WELL ABANDONED: 5-3-2017 (month/day/year)

\* PERMIT NUMBER OF ABANDONED WELL (if any) none

Ho - 73 - 1307

\* PERMIT NUMBER OF REPLACEMENT WELL: \_\_\_\_\_


\* PERSON ABANDONING WELL: Larry Mayne WELL DRILLER'S LICENSE NUMBER: MSD 027

CIRCLE: MWD / MSD / MGD

\* OWNER'S NAME: Sharon Hollman

SITE LOCATION MAP

\* WELL LOCATION:  
COUNTY: Howard  
NEAREST TOWN: Ellicott City  
TAX MAP 0017 BLOCK 0008 PARCEL 0028  
SUBDIVISION: \_\_\_\_\_  
SECTION: \_\_\_\_\_ LOT: \_\_\_\_\_  
STREET ADDRESS: 7930 Old Mill Rd

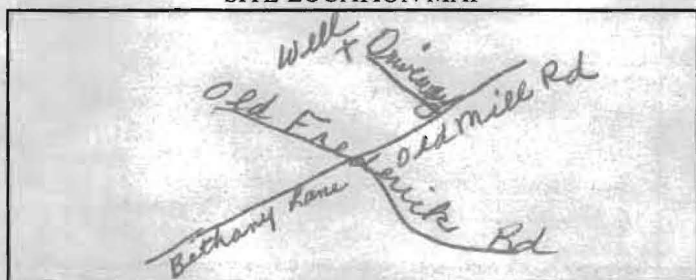

LATITUDE 3 9.302938  
LONGITUDE 7 6.856604

LOG OF SEALING MATERIAL

MATERIAL	FEET	
	FROM	TO
<u>Cement &amp; gravel</u>	<u>0</u>	<u>162</u>
VOLUME OF MATERIAL USED		
<u>21 Bags cement 300 lbs gravel</u>		

\* TYPE OF WELL BEING ABANDONED:  
 DRILLED                       JETTED  
 BORED                           HAND DUG  
 OTHER (specify) \_\_\_\_\_

\* USE CODE:  
 DOMESTIC                       MUNICIPAL/PUBLIC  
 IRRIGATION                       INDUSTRIAL  
 TEST/OBSERVATION               GEOTHERMAL

\* TYPE OF CASING:  
 STEEL                               PLASTIC  
 CONCRETE                       OTHER (specify) \_\_\_\_\_

SIZE OF CASING: 6 5/8 INCHES IN DIAMETER

DEPTH OF WELL: 162 FEET DEEP

WAS ANY CASING REMOVED?  YES  NO  
If yes, length removed, in feet: 2

WAS CASING RIPPED OR PERFORATED?  YES  NO

Larry Mayne  
SIGNATURE-MASTER WELL DRILLER OR SUPERVISING SANITARIAN LICENSE# MSD027

CIRCLE ONE MWD / MSD / MGS DATE 6-28-2017

Pursuant to § 10-624 of the State Govt. Article of the Maryland Code, personal info requested on this form is used in processing this form pursuant to COMAR 26.04.04. Failure to provide the info may result in this form not being processed. You have the right to inspect, amend, or correct this form. The Maryland Department of the Environment is subject to the Maryland Public Information Act. This form may be made available on the Internet via MDE's website and is subject to inspection or copying, in whole or in part, by the public and other governmental agencies, if not protected by federal or State Law.

Real Property Data Search

Search Result for HOWARD COUNTY

View Map		View GroundRent Redemption				View GroundRent Registration			
<b>Account Identifier:</b>		<b>District - 02 Account Number - 264129</b>							
Owner Information									
<b>Owner Name:</b>		HOLLOMAN GEORGE M HOLLOMAN SHARON				<b>Use:</b>		RESIDENTIAL	
<b>Mailing Address:</b>		9930 OLD MILL RD ELLCOTT CITY MD 21042-1602				<b>Principal Residence:</b>		YES	
						<b>Deed Reference:</b>		/00836/ 00030	
Location & Structure Information									
<b>Premises Address:</b>		9930 OLD MILL RD ELLCOTT CITY 21042-0000				<b>Legal Description:</b>		1.036A 9930 OLD MILL RD ELLCOTT CITY	
<b>Map:</b>	<b>Grid:</b>	<b>Parcel:</b>	<b>Sub District:</b>	<b>Subdivision:</b>	<b>Section:</b>	<b>Block:</b>	<b>Lot:</b>	<b>Assessment Year:</b>	<b>Plat No:</b>
0017	0008	0028		0000				2016	Plat Ref:
<b>Special Tax Areas:</b>					<b>Town:</b>		NONE		
					<b>Ad Valorem:</b>		104		
					<b>Tax Class:</b>				
<b>Primary Structure Built</b>		<b>Above Grade Living Area</b>		<b>Finished Basement Area</b>		<b>Property Land Area</b>		<b>County Use</b>	
1976		1,332 SF				1.0300 AC			
<b>Stories</b>	<b>Basement</b>	<b>Type</b>	<b>Exterior</b>	<b>Full/Half Bath</b>	<b>Garage</b>	<b>Last Major Renovation</b>			
1	YES	STANDARD UNIT	SIDING	1 full					
Value Information									
		<b>Base Value</b>		<b>Value</b>		<b>Phase-in Assessments</b>			
				As of		As of		As of	
				01/01/2016		07/01/2016		07/01/2017	
<b>Land:</b>		178,800		178,800					
<b>Improvements</b>		96,300		135,800					
<b>Total:</b>		275,100		314,600		288,267		301,433	
<b>Preferential Land:</b>		0						0	
Transfer Information									
<b>Seller:</b>		<b>Date:</b>		<b>Price:</b>					
<b>Type:</b>		<b>Deed1:</b>		<b>Deed2:</b>					
<b>Seller:</b>		<b>Date:</b>		<b>Price:</b>					
<b>Type:</b>		<b>Deed1:</b>		<b>Deed2:</b>					
<b>Seller:</b>		<b>Date:</b>		<b>Price:</b>					
<b>Type:</b>		<b>Deed1:</b>		<b>Deed2:</b>					
Exemption Information									
<b>Partial Exempt Assessments:</b>		<b>Class</b>				07/01/2016		07/01/2017	
<b>County:</b>		000				0.00			
<b>State:</b>		000				0.00			
<b>Municipal:</b>		000				0.00 0.00		0.00 0.00	
<b>Tax Exempt:</b>				<b>Special Tax Recapture:</b>					
<b>Exempt Class:</b>				NONE					
Homestead Application Information									
<b>Homestead Application Status:</b> Approved 10/16/2012									
Homeowners' Tax Credit Application Information									
<b>Homeowners' Tax Credit Application Status:</b> No Application					<b>Date:</b>				