
 WATER WELL ABANDONMENT-SEALING REPORT FORM

SUBMIT COPIES OF COMPLETED FORM TO:

- * COUNTY ENVIRONMENTAL AGENCY (contact MDE, WMA if address needed)
- * WELL OWNER
- * MDE, WATER MANAGEMENT ADMINISTRATION, WELL PROGRAM

OK
 DW
 9/10/17

DATE WELL ABANDONED: JULY 19, 2017 (month/day/year)


* PERMIT NUMBER OF ABANDONED WELL (if any) NA

* PERMIT NUMBER OF REPLACEMENT WELL: HO-94-2356

* PERSON ABANDONING WELL: George Easterday WELL DRILLER'S LICENSE NUMBER: _____
 CIRCLE: MWD / MSD / MGD

* OWNER'S NAME: DIANE COSGRAY

SITE LOCATION MAP

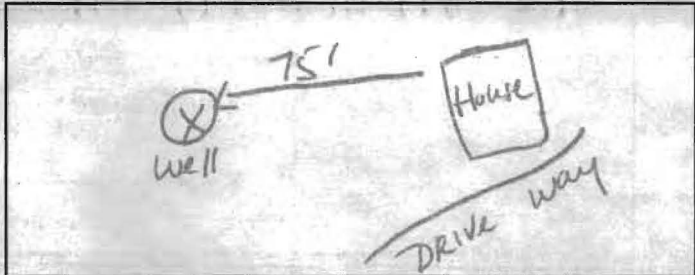

* WELL LOCATION:
 COUNTY: Howard
 NEAREST TOWN: FULTON
 TAX MAP _____ BLOCK _____ PARCEL _____
 SUBDIVISION: _____
 SECTION: _____ LOT: _____
 STREET ADDRESS: 8340 OLD COLUMBIA RD

LATITUDE 3 9.143639

LONGITUDE 7 6.905819

LOG OF SEALING MATERIAL

MATERIAL	FEET	
	FROM	TO
CEMENT	30	2
DIRT	2	0

* TYPE OF WELL BEING ABANDONED:
 DRILLED JETTED
 BORED HAND DUG
 OTHER (specify) _____

* USE CODE:
 DOMESTIC MUNICIPAL/PUBLIC
 IRRIGATION INDUSTRIAL
 TEST/OBSERVATION GEOTHERMAL

VOLUME OF MATERIAL USED

12 YDS CEMENT

* TYPE OF CASING:
 STEEL PLASTIC
 CONCRETE OTHER (specify) STONE

SIZE OF CASING: 3 1/4 INCHES IN DIAMETER

DEPTH OF WELL: 30 FEET DEEP

WAS ANY CASING REMOVED? YES NO
 If yes, length removed, in feet: _____

WAS CASING RIPPED OR PERFORATED? YES NO

George F. Easterday
 SIGNATURE-MASTER WELL DRILLER OR SUPERVISING SANITARIAN LICENSE# 040

Pursuant to § 10-624 of the State Govt. Article of the Maryland Code, personal info requested on this form is used in processing this form pursuant to COMAR 26.04.04. Failure to provide the info may result in this form not being processed. You have the right to inspect, amend, or correct this form. The Maryland Department of the Environment is subject to the Maryland Public Information Act. This form may be made available on the Internet via MDE's website and is subject to inspection or copying, in whole or in part, by the public and other governmental agencies, if not protected by federal or State Law.

MWD / MSD / MGS 7-19-17
 CIRCLE ONE DATE