

PUB. SEWER STATUS VERIFIED BY _____

ISSUE DATE: 08/06/08

P 529513

APPROVAL DATE: 8/11/08

PERMIT
Logged Into Permit Manager
Tax ID # 04-329589

A REPAIR
A529476

**ON-SITE SEWAGE DISPOSAL SYSTEM
HOWARD COUNTY HEALTH DEPARTMENT
BUREAU OF ENVIRONMENTAL HEALTH**

Hatfield's Equipment IS PERMITTED TO INSTALL ALTER

ADDRESS: PO Box 519, Annapolis Junction PHONE NUMBER: 301-854-6172

SUBDIVISION: _____ LOT NUMBER: _____

ADDRESS: 14999 Old Frederick Road PROPERTY OWNER: Heidi Peterson

SEPTIC TANK CAPACITY (GALLONS): _____

PUMP CHAMBER CAPACITY (GALLONS): _____

NUMBER OF BEDROOMS: 4

SQUARE FEET PER BEDROOM: _____

LINEAR FEET OF TRENCH REQUIRED: 180 - 200


TRENCHES:	2 - 90' to 100' trenches on contour where test holes were dug Trenches 2' Wide Inlet 4.5' Bottom 8'
LOCATION:	.
ADDITIONAL NOTES:	Pump out and fill drywell with dirt.

PLANS APPROVED: Brian Baker DATE: 7/16/08

- NOTE: PERMIT VOID AFTER 2 YEARS
- NOTE: CONTRACTOR RESPONSIBLE FOR SCHEDULING A PRE-CONSTRUCTION INSPECTION FOR ALL INSTALLATIONS
- NOTE: WATERTIGHT SEPTIC TANKS REQUIRED
- NOTE: ALL PARTS OF SEPTIC SYSTEM SHALL BE 100 FEET FROM ANY WATER WELL
- NOTE: MANHOLE RISERS REQUIRED ON ALL SEPTIC TANKS AND PUMP CHAMBERS

**NEITHER THE HOWARD COUNTY COUNCIL OR THE HEALTH DEPARTMENT IS
RESPONSIBLE FOR THE SUCCESSFUL OPERATION OF ANY SYSTEM
PERMITTEE RESPONSIBLE FOR OBTAINING FINAL APPROVAL ON THIS PERMIT
CALL 410-313-2640 FOR INSPECTION OF SEPTIC SYSTEM**

NOT TO SCALE

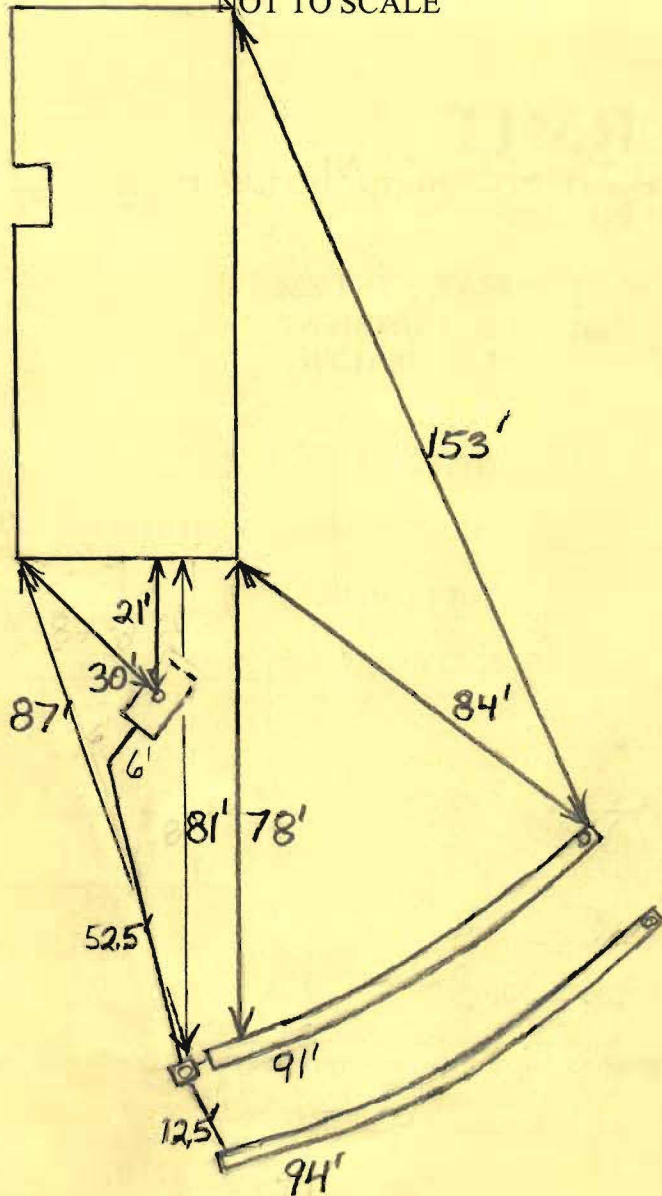

TRENCH/DRAINFIELD DATA		
WIDTH	INLET	BOTTOM
2'	4.5'	8'
NUMBER OF TRENCHES		2
TOTAL LENGTH		185'
ABSORPTION AREA		278
DISTRIBUTION BOX LEVEL		Levellers
DISTRIBUTION BOX BAFFLE		Yes
DISTRIBUTION BOX PORT		Yes

SEPTIC TANK DATA	
SEPTIC TANK 1 LEVEL	Yes
MANUFACTURER	
CAPACITY	GAL
SEAM LOC	Midseam
TANK LID DEPTH	4.5-5'
BAFFLES	Yes
BAFFLE FILTER	No
MANHOLE LOC	None
6" PORT LOC	Middle
WATERTIGHT TEST	No
SLOTTED	No
PUMP/SEPTIC TANK LEVEL N/A	
MANUFACTURER	
CAPACITY	
SEAM LOC	
TANK LID DEPTH	
BAFFLES	
BAFFLE FILTER	
MANHOLE LOC	
6" PORT LOC	
WATERTIGHT TEST	
SLOTTED	

PRE-CONSTRUCTION
 7/16/08 Install
 2 trenches on
 contour in direct
 area of perc. test
 holes. Each trench should be 90'-100' in length. Inlet
 4.5' and bottom 8'. Trenches 2' wide. Pump out and
 fill in existing drywell. (BB) 8/11/08 Repair finished. Dry-
 well pumped out and filled in. (BB)

← Old Frederick Road

INSTALLATION

FINAL INSPECTOR B. Baker DATE OF APPROVAL 8/11/08