

# APPLICATION

PERCOLATION TESTING

A 45335

P \_\_\_\_\_

HOWARD COUNTY HEALTH DEPARTMENT  
BUREAU OF ENVIRONMENTAL HEALTH  
P.O. BOX 476 ELLICOTT CITY, MARYLAND 21043  
TELEPHONE: 461-9933

DISTRICT \_\_\_\_\_

DATE 12/12/89

TO: THE COUNTY HEALTH OFFICER  
ELLICOTT CITY, MARYLAND

I HEREBY APPLY FOR THE NECESSARY TEST IN ORDER TO CONSTRUCT (OR RECONSTRUCT) A SEWAGE DISPOSAL SYSTEM.

PROPERTY OWNER SARAH STOUT

ADDRESS 15802 OLD FREDERICK RD WOODBINE, MD 21797 PHONE (301) 409-4836

PROSPECTIVE BUYER - N/A

ADDRESS \_\_\_\_\_ PHONE \_\_\_\_\_

PROPERTY LOCATION: Hong

SUBDIVISION STOUT PROPERTY LOTS 4-7 LOT NO. \$ 2

ROAD AND DESCRIPTION SOUTH SIDE OF OLD FREDERICK RD 1300' EAST OF ROUTE 94

TAX MAP 7 PARCEL # 3

SIZE OF LOT 3.26 AC. TYPE BLDG. SINGLE  
(SINGLE FAMILY DWELLING OR COMMERCIAL)

THE SYSTEM INSTALLED UNDER THIS APPLICATION IS ACCEPTABLE ONLY UNTIL PUBLIC FACILITIES BECOME AVAILABLE. I FULLY UNDERSTAND THE FEE CONNECTED WITH THE FILING OF THIS PERC TEST APPLICATION IS NON-REFUNDABLE UNDER ANY CIRCUMSTANCES. I ALSO AGREE TO COMPLY WITH ALL M.O.S.H.A. REQUIREMENTS IN TESTING THIS LOT. x Sarah Stout  
(SIGNATURE OF APPLICANT)

APPROVED BY \_\_\_\_\_ FOR \_\_\_\_\_ DATE \_\_\_\_\_

REJECTED BY \_\_\_\_\_ FOR \_\_\_\_\_ DATE \_\_\_\_\_

HOLD PENDING FURTHER TESTS \_\_\_\_\_ DATE \_\_\_\_\_

REASONS FOR REJECTION OR HOLDING PERC OK - HOLD FOR PLAT MR 1/12/90


## THIS IS NOT A PERMIT

Lot 5  
A45335

1/2/3/4  
SOIL PROFILE

07g  
clay  
soam  
07g, 4e/1  
bfg  
red  
11-  
5-10%  
frags

0-11

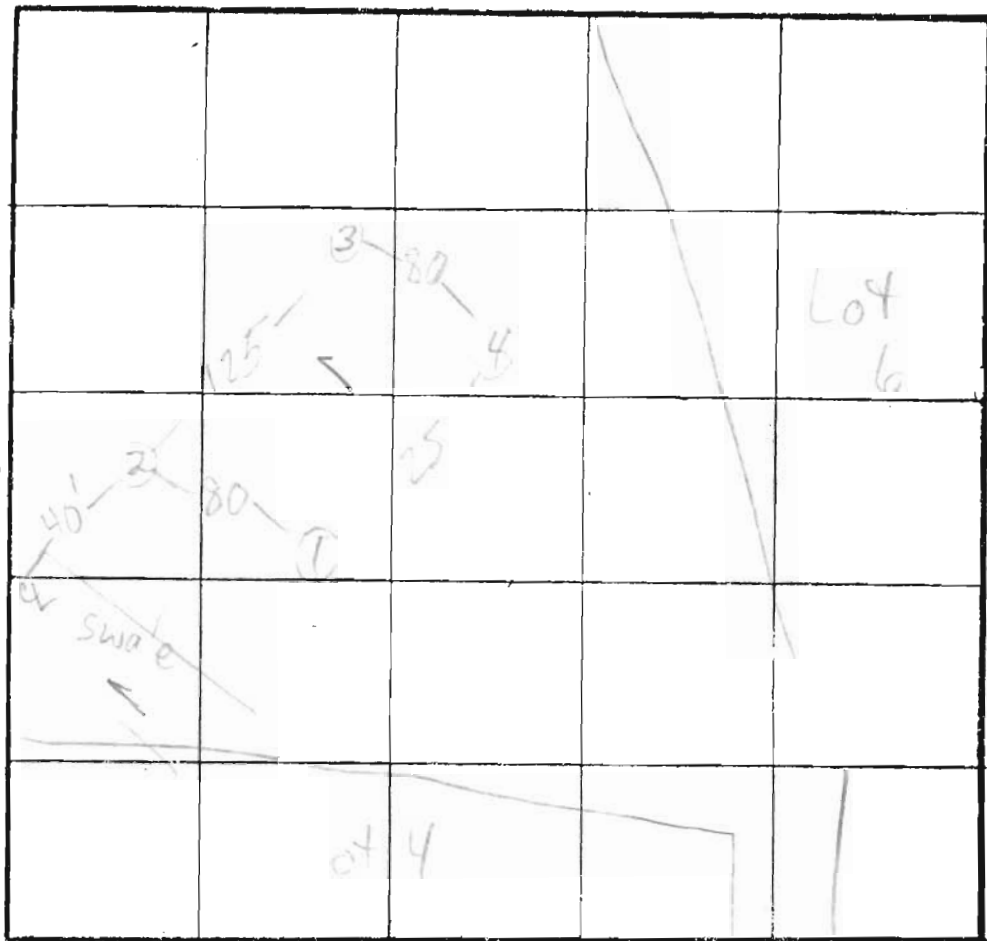

1) 8/11

2) 3/10

X=11  
210 BR  
Inlet 3 1/2'  
Bottom 5'

OLD FRED. RD

INDICATE NORTH - NAME ADJOINING ROADWAY AS BASE LINE.

DATE	TEST NO.	DEPTH	PRE-WET		TEST - 1" DROP		TIME
			START	STOP	START	STOP	
1/12/90	1 S	3 1/2	9:31	10:26			10
	1 V	11	10:21	10:32	10:32	10:56	24
	2 S	5	11:22	10:26	10:26	10:30	4
	2 V	10	sim to 10	10:21	10:21	4' clay	
	3 S	4 1/2	10:32	10:33	10:33	10:38	5
	3 V	11	sim to 10	15% frags		3 1/2' clay	
	4 V	9	OK sim to 10	20% frags		3' clay	

HARD  
SOIL

REMARKS: FILL - DUG PER 2" IT - SHALLOW ONLY

TYPE OF SOIL: \_\_\_\_\_

TESTED BY: M. R. ... ALSO PRESENT: Dave

6-12-1079

