


stains hydric inclusions
 100-year floodplain areas

MARYLAN

Copy Perc Cert for Parcel 2
 Stripped 3/13/2009
 ROUTE 32
 Parcel 2
 Eide Att'n Property
 (Parcel 2 address TBD)

Strip
 supposedly
 owned by
 Eide Att'n
 Property

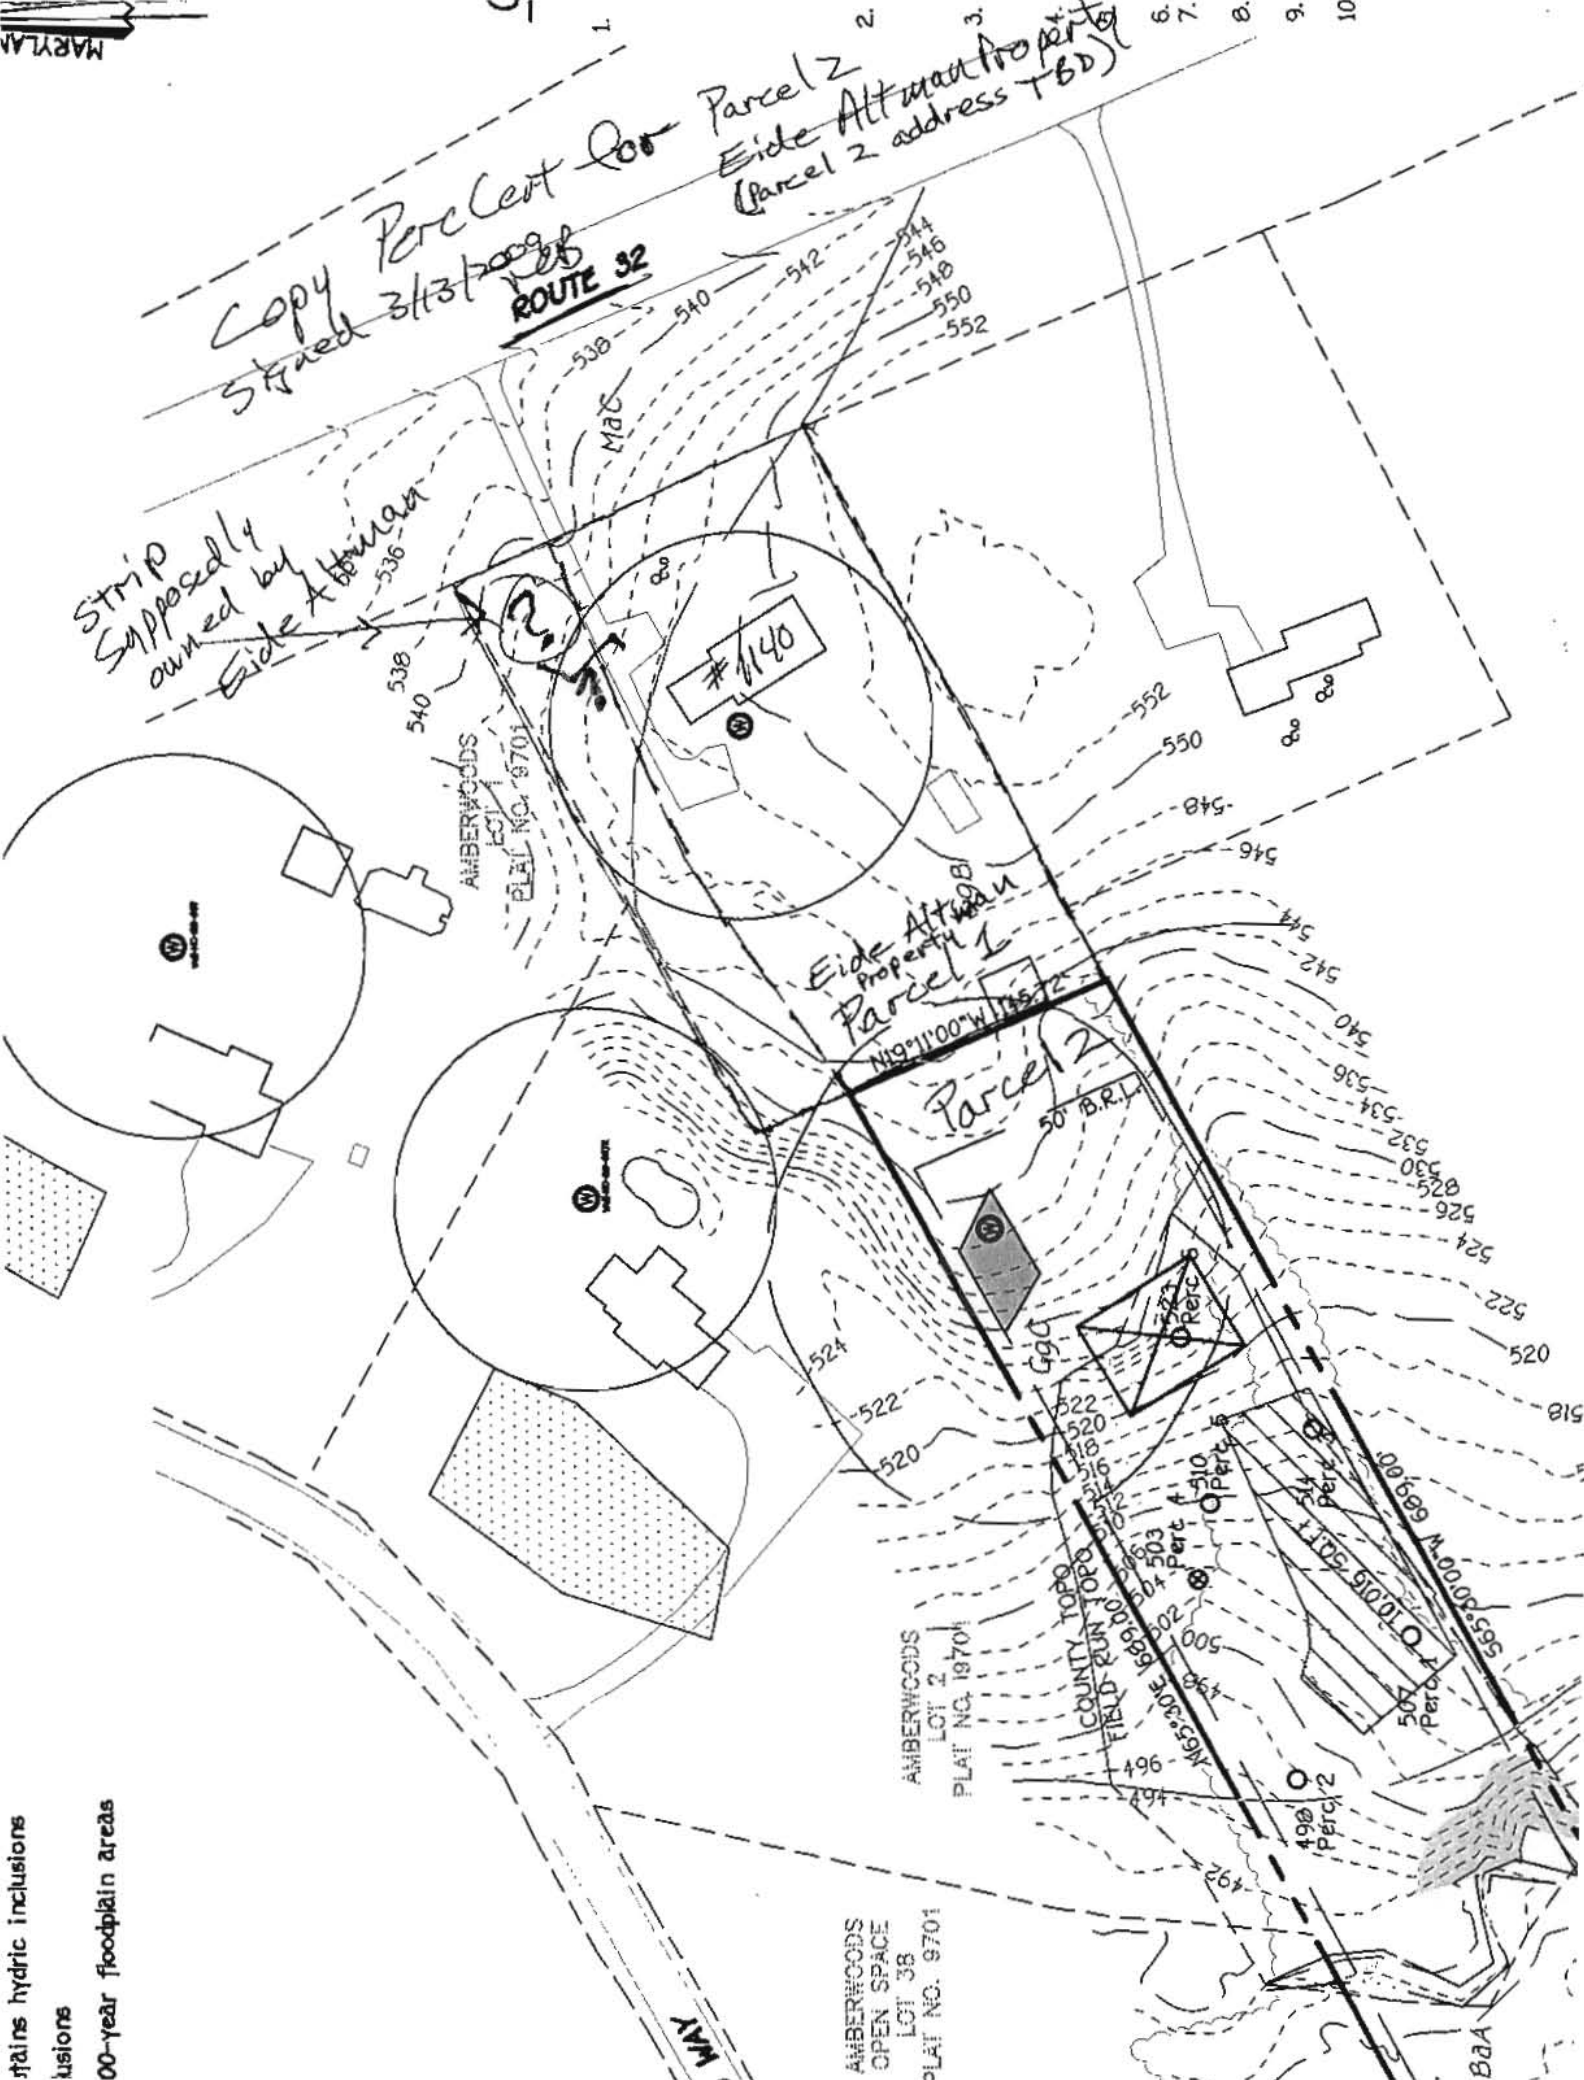

AMBERWOODS
 OPEN SPACE
 LCT 38
 PLAT NO. 9701

BaA