

C 1- 6248
 1 2 3 (SEQ. NO.) 4
 (THIS NUMBER IS TO BE PUNCHED IN COLS. 3-6 ON ALL CARDS)

SEQUENCE NO. (WRA USE ONLY)

STATE OF MARYLAND
 WATER RESOURCES ADMINISTRATION
 TAWES STATE OFFICE BLDG., ANNAPOLIS, MD. 21401
WELL COMPLETION REPORT

THIS REPORT MUST BE SUBMITTED IN 30 DAYS AFTER WELL COMPLETION

FILL IN THIS FORM COMPLETELY

DATE RECEIVED (WRA USE ONLY) _____
 DATE WELL COMPLETED 11/11/77
 8-13

DEPTH OF WELL

22 (TO NEAREST FOOT) 26

PERMIT NO. FROM "PERMIT TO DRILL WELL"

11-11-11-11
 28 29 30 31 32 33 34 35 36 37

OWNER WIDENE

LAST NAME

DRILLERS IDENTIFICATION NO. 159

STREET OR RFD 1101 KIRKWOOD RD

POST OFFICE 111111 MD

STATE THE KIND OF FORMATIONS PENETRATED, THEIR COLOR, DEPTH, THICKNESS AND IF WATER BEARING

DESCRIPTION (USE ADDITIONAL SHEETS IF NECESSARY)

DESCRIPTION	FEET		CHECK IF WATER BEARING
	FROM	TO	
Brown shale	0	57	
Blue shale	57	170	

GROUTING RECORD

WELL HAS BEEN GROUTED (CIRCLE APPROPRIATE BOX) Y N

TYPE OF GROUTING MATERIAL (CIRCLE ONE):
 CEMENT C M BENTONITE CLAY B C
 45 46 45 46

NO. OF BAGS 10 NO. OF POUNDS 1500

GALLONS OF WATER 76

DEPTH OF GROUT SEAL (TO NEAREST FOOT)
 FROM 0 FT. TO 57 FT.
 (ENTER 0 IF FROM SURFACE)

CASING RECORD

INSERT APPROPRIATE CODE BELOW

STEEL S I CONCRETE C O
 PLASTIC P L OTHER O T

MAIN CASING TYPE S I NOMINAL DIAMETER TOP (MAIN) CASING (NEAREST INCH) 6 TOTAL DEPTH OF MAIN CASING (NEAREST FOOT) 57

60 61 63 64 66 70

OTHER CASING (IF USED)

DIAMETER (INCH) _____ DEPTH (FEET) FROM _____ TO _____

SCREEN RECORD

INSERT APPROPRIATE CODE BELOW

STEEL S T BRASS OR BRONZE B R OPEN HOLE H O
 PLASTIC P L OTHER O T

WELL SCREENING

C 2 (SEQ. NO.) 6

DEPTH (NEAREST WHOLE FOOT) FROM _____ TO _____

1 2 3 4 5 6 7 8 9 10 11 12 13 14 15 16 17 18 19 20 21

23 24 26 30 32 36

38 39 41 45 47 51

SLOT SIZE 1. _____ 2. _____ 3. _____

DIAMETER OF SCREEN _____ (NEAREST INCH)

GRAVEL PACK _____

IF WELL DRILLED WAS A FLOWING WELL CIRCLE BOX F

WRA USE ONLY (NOT TO BE FILLED IN BY DRILLER)

TELESCOPE CASING T LOG INDICATOR L OTHER DATA AVAILABLE W Q

C 3 (SEQ. NO.) 6

PUMPING TEST

HOURS PUMPED (TO NEAREST HOUR) 1

PUMPING RATE (GALLONS PER MINUTE TO NEAREST GALLON) 10

METHOD USED TO MEASURE PUMPING RATE 7110

WATER LEVEL (DISTANCE FROM LAND SURFACE) BEFORE PUMPING 17 (NEAREST FOOT) WHEN PUMPING 170 (NEAREST FOOT)

TYPE OF PUMP USED (CIRCLE APPROPRIATE BOX) (FOR PUMPING TEST)
 AIR A PISTON P TURBINE T
 CENTRIFUGAL C ROTARY R OTHER (DESCRIBE BELOW) O
 JET J SUBMERSIBLE S

PUMP INSTALLED

TYPE OF PUMP (WRITE APPROPRIATE LETTER IN BOX - SEE ABOVE: A, C, J, P, R, S, T, O)

DRILLER WILL INSTALL PUMP (CIRCLE APPROPRIATE BOX) Y N


CAPACITY: GALLONS PER MINUTE (TO NEAREST GALLON) 31 30

PUMP HORSE POWER 37 41

PUMP COLUMN LENGTH (NEAREST FOOT) 43 47

CASING HEIGHT (CIRCLE APPROPRIATE BOX AND ENTER CASING HEIGHT)
 ABOVE BELOW LAND SURFACE (NEAREST FOOT) 50 51

LOCATION OF WELL ON LOT SHOW PERMANENT STRUCTURE SUCH AS BUILDINGS, SEPTIC TANKS, AND/OR OTHER LAND MARKS AND INDICATE NOT LESS THAN TWO DISTANCES (MEASUREMENTS TO WELL).

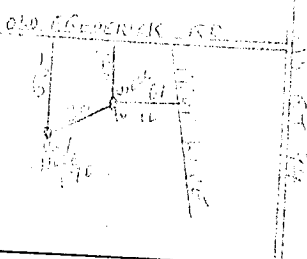

CIRCLE APPROPRIATE BOXES

A WELL WAS ABANDONED AND SEALED WHEN THIS WELL WAS COMPLETED.

E ELECTRIC LOG OBTAINED

P TEST WELL CONVERTED TO PRODUCTION WELL

I HEREBY CERTIFY THAT I HAVE COMPLIED WITH ALL CONDITIONS STATED ON THE ABOVE-CAPTIONED "PERMIT TO DRILL WELL", AND THAT INFORMATION CONTAINED IN THIS REPORT IS TRUE, ACCURATE, AND COMPLETE TO THE BEST OF MY KNOWLEDGE, INFORMATION AND BELIEF.

DRILLERS NAME _____

PLEASE PRINT ROBERT J. ...

SIGNATURE R. J. ...