

APPLICATION

A 17666

P _____

SEWAGE DISPOSAL TESTING

MARYLAND STATE DEPARTMENT OF HEALTH

HOWARD COUNTY

ELLICOTT CITY

DISTRICT 4

DATE 11/22/72

TO: THE COUNTY HEALTH OFFICER
ELLICOTT CITY, MARYLAND

I, HEREBY, APPLY FOR THE NECESSARY TESTS, IN ORDER TO CONSTRUCT (OR RECONSTRUCT) A SEWAGE DISPOSAL SYSTEM.

PROPERTY OWNER THOMAS G OYSTER, et al

ADDRESS 1419 REEDIE DRIVE PHONE _____

PROPERTY LOCATION: _____

SUBDIVISION _____ LOT NO. LOT 1

ROAD AND DESCRIPTION HEADS MILL RD (RT = 97) SOUTH
OF FORSYTHE RD

OCCUPANT _____ PHONE _____

PERSON TO CONSTRUCT SYSTEM _____

ADDRESS _____ PHONE _____

SIZE OF LOT 1.0 ACRE TYPE BLDG. 4 Bed room
NUMBER OF BEDROOMS

IF NOT SINGLE RESIDENCE, DESCRIBE _____

SIGNATURE OF APPLICANT John W. Lewis for Thomas G Oyster


APPROVED BY _____ FOR _____ DATE _____

REJECTED BY _____ FOR _____ DATE _____

HOLD PENDING FURTHER TESTS _____ DATE _____

REASONS FOR REJECTION OR HOLDING _____

THIS IS NOT A PERMIT

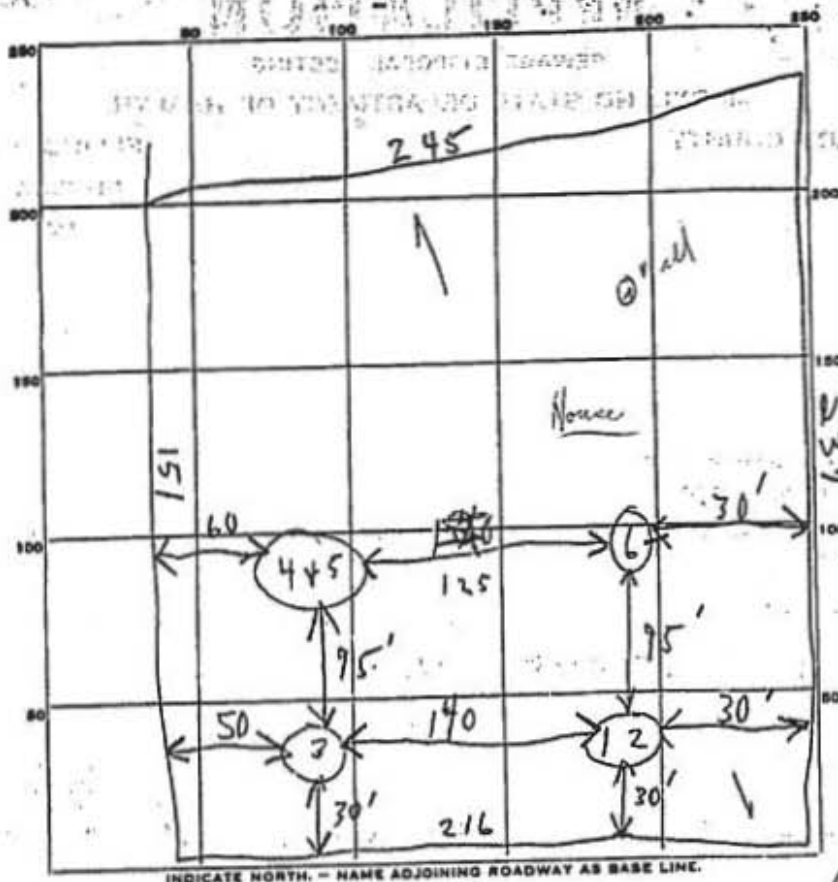

Lot 1
Measured from new property Lot #1 line

DATE	TEST NO.	DEPTH	PRE-WET		TEST - 1" DROP		TIME
			START	STOP	START	STOP	
11/2/72	1	4'	9:57	10:00	10:00	10:15	15 min
	2	11'	9:58	10:02	10:02	10:12	10 min
	3	11 1/2'	Similar to 1+2				
	4	11'	10:16	10:18	10:18	10:20	2 min
	5	3 1/2'	10:16	10:22	10:22	10:44	22 min
	6	10 1/2'	Spod soil		No flow		

} 25

} 24

} 49 } 13"

SOIL AUGER FINDING OK - CPS

TESTED BY B. Straker See 4+5 penetration 3 1/2'

REMARKS Mr. J. Lewis present

