

8/22/75
after 5:30

2/21/75
Retinal check out
C.S.S.

PERMIT

SEWAGE DISPOSAL SYSTEM

MARYLAND STATE DEPARTMENT OF HEALTH

HOWARD COUNTY

ELLICOTT CITY

INDEXED

21977
17666
Hold for call
File final
C.S.S.

DISTRICT 4

DATE 8/20/75

8/22/75
after 1 PM

Patrick J. Landrim IS PERMITTED TO INSTALL ALTER

ADDRESS 14010 Foxwythe Road, Sykesville, Md. 21784 PHONE 442-2416

A SEWAGE DISPOSAL SYSTEM LOCATED AT _____

SUBDIVISION _____ ROAD Hood's Hill (Rt. 97) LOT 1

just off 70N

PROPERTY OWNER Dennis Kimble

ADDRESS _____

SPECIFICATIONS - 3 bedrooms

DRAIN FIELD _____ DEPTH _____ FEET, BOTTOM AREA _____ SQ. FT.

SEEPAGE PITS _____ ABSORBENT SIDE-WALL AREA _____ SQ. FT.

SEPTIC TANK CAPACITY 1,000 GALLONS

FOR GARBAGE GRINDER, INCREASE DISPOSAL AREA 22% & TANK CAPACITY 50%.

OTHER Dry well to have 145 sq. ft. effective absorbent sidewall area per bedroom.

below inlet. Inlet to be 3 1/2 ft. below original grade and maximum depth 11 ft. Location

60 ft. off left property line and 125 ft. from new front property line when facing lot from

Route 97. (perc hole 4 & 5).

NOTE: ALL PIPE FROM HOUSE TO DISPOSAL AREA MUST BE CAST IRON.
PERMIT VOID AFTER THREE YEARS.


NOTE: INSTALL STAND PIPE ON SEPTIC TANK AND DRY WELL. STAND PIPES MUST BE 6" IN DIA.,

PLANS APPROVED BY C. Streaker DATE 5/16/74
CAST IRON, CONCRETE OR TERRA COTTA ACCEPTED.

FILL SEPTIC TANK AND DISTRIBUTION BOX WITH WATER BEFORE CALLING FOR AN INSPECTION. COVER NO WORK UNTIL INSPECTED AND APPROVED.

NEITHER THE HOWARD COUNTY COMMISSIONERS NOR THE HEALTH DEPARTMENT IS RESPONSIBLE FOR THE SUCCESSFUL OPERATION OF ANY SYSTEM.

A 17666

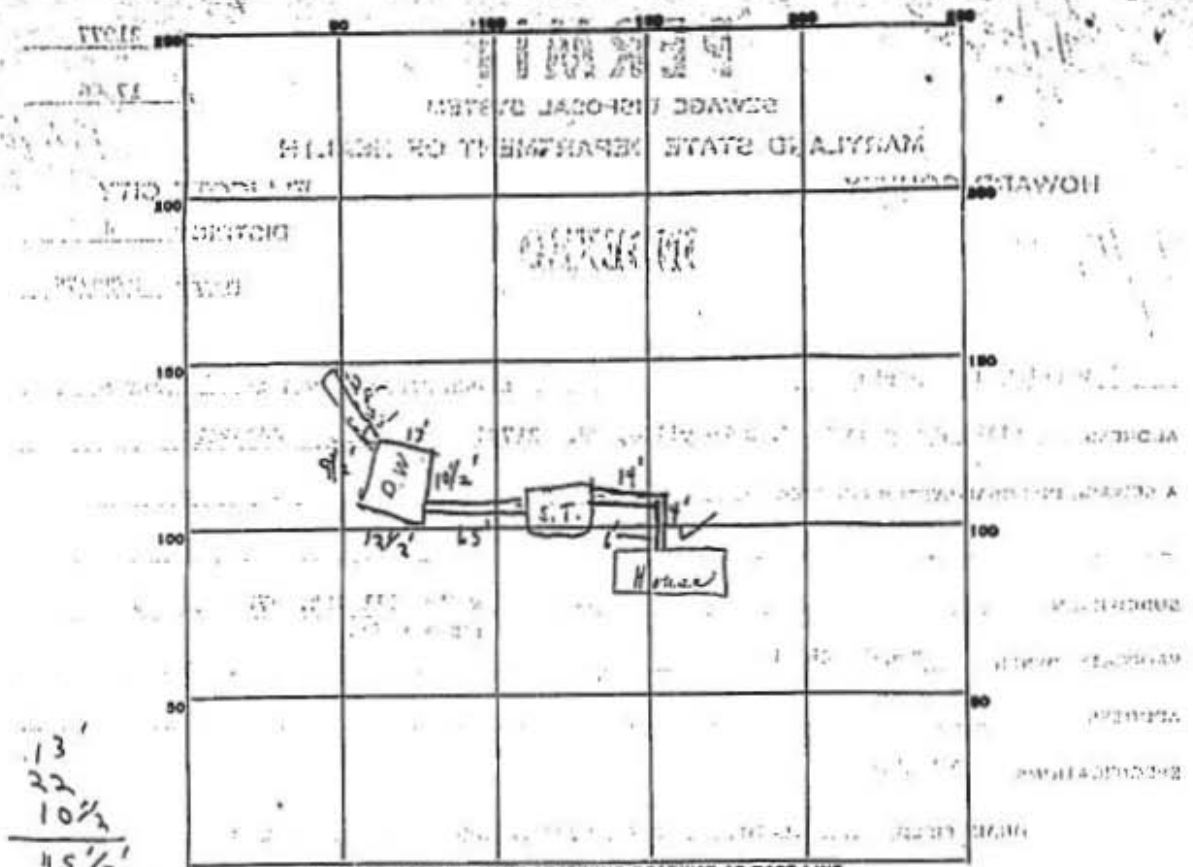

13'
22'
10 1/2'

45 1/2'

INDICATE NORTH - NAME ADJOINING ROADWAY AS BASE LINE.

PERMIT CARD ② 8/21/75 1 year permit 29.97 S.T. / P.W. ② on 11' / 11' ③ Cleanout m.

SEPTIC TANK, LEVEL ob CLEANOUTS 11' / 11'

DISTRIBUTION BOX, LEVEL ↔

TILE FIELD: DEPTH 7' FT. TRENCH WIDTH 28' FT.

GRAVEL DEPTH 7' IN. TOTAL LENGTH 28' FT. ① 17.6' 10.8' ② 36.4' 2.8'

NUMBER OF TRENCHES 1 TOTAL BOTTOM AREA 560 SQ. FT. Total 560 5.8'

SEEPAGE PITS, INSIDE DIAMETER outside perimeter 45 1/2' FT. DEPTH BELOW INLET 8' FT. ② → 360

ABSORBENT AREA 560 SQ. FT.

REMARKS ① 8/21/75 Trench ok for gravel
Trench ok - outlet at 4' thickness of gravel. Day well
Lip on pipe at 12' - 14' - 16' - 18' - 20' - 22' - 24' - 26' - 28' - 30' - 32' - 34' - 36' - 38' - 40' - 42' - 44' - 46' - 48' - 50'

② 8/22/75 Note gravel in trench & pipe covered.
Trench ok - house - connected to main sewerage
present by Keller plumbing personnel

DATE SYSTEM APPROVED 8/22/75 INSPECTOR C. Shaker

1390

P 21977 A 17666
DATE 8/20/75 11/22/72

LOCATION Hoods Mill Road
(Route 97)

APPLICATION
HOLD
APPROVED
REJECTED

LOT 1

APPLICANT John W. Lewis

INSTALLATION
HOLD
APPROVED

OWNER Thomas Kimble

PERMITTEE Pat Lendrin

APPROVED DATE 8/22/75