

7178 Columbia Gateway Drive, Columbia MD 21046
(410) 313-2640 Fax (410) 313-2648
TDD (410) 313-2323 Toll Free 1-866-313-6300
website: www.hchealth.org

Penny E. Borenstein, M.D., M.P.H., Health Officer

May 19, 2006

Mr. James Ruff
9220 Wighman Road
Suite 120
Montgomery Village, MD 20886


Re: Proposed Building Site Plan
Map: 8 Parcel: 166
1047 Route 97

Dear Mr. Ruff,

Our office received a building site plan for the above mentioned property on April 19, 2006. Review of the site plan appears acceptable, however, the number of bedrooms affects the amount of trench necessary. Also, be mindful that all trenches shall be within 10% of the same length. Relocation of the distribution box may be helpful maintain integrity of the same length for each trench. In summary, the plan appears adequate for elevations in septic design, but clarification of the number of bedrooms is necessary as well as maintaining nearly same length of each trench.

As an additional note, our office will not release a building permit until the well completion report has been turned in by the well driller. Please submit your well completion report concurrently with the building site plan with the number of bedrooms written on the permit.

Sincerely,

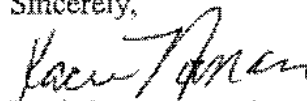
Kacie Noonan, R. S.
Well & Septic Program

KN
Cc: file

*faxed
5/19/06* ✓

Macris, Hendricks and Glascock, P.A.
Engineers • Planners • Surveyors • Landscape Architects

9220 Wightman Road, Suite 120
Montgomery Village, Maryland
20886-1279

Phone 301.670.0840

Fax 301.948.0693

www.mhgpa.com



April 14, 2006

Bureau of Environmental Health
6751 Columbia Gateway Drive
Columbia Md, 21046

Re: Parcel 166
MHG 2005.229.10

Dear Sir:

Attached to this letter are three copies of a Site Plan for a single family house and the previously approved perc plan for the referenced project.

The property owner will be filing for building permits shortly. Please review the proposed septic design and provide any comments regarding the design.

Should you have any questions regarding this matter please do not hesitate to contact me.

Sincerely,

A handwritten signature in black ink, appearing to read "J. Ruff", is written over the word "Sincerely,". The signature is stylized and cursive.

James A. Ruff, P.E.

4/24/06

Mike,

I'm not sure how you
want this reviewed.
There isn't a building permit
in yet for this property,
but they want these
plans reviewed.

Thanks

Stet

P.S. Well comp report not in.



KC,

5/11/06

Please review and generate
design comments.

23:

Mike

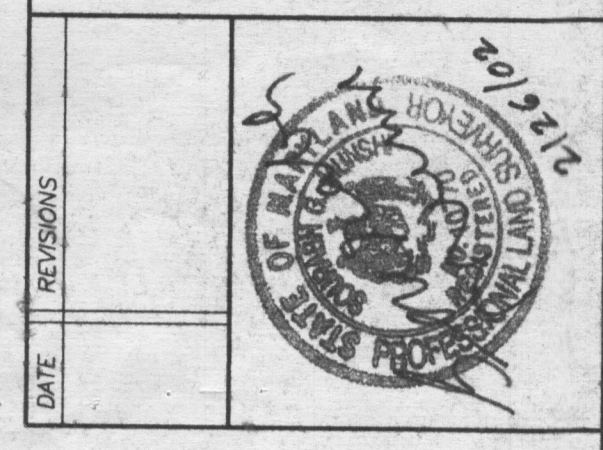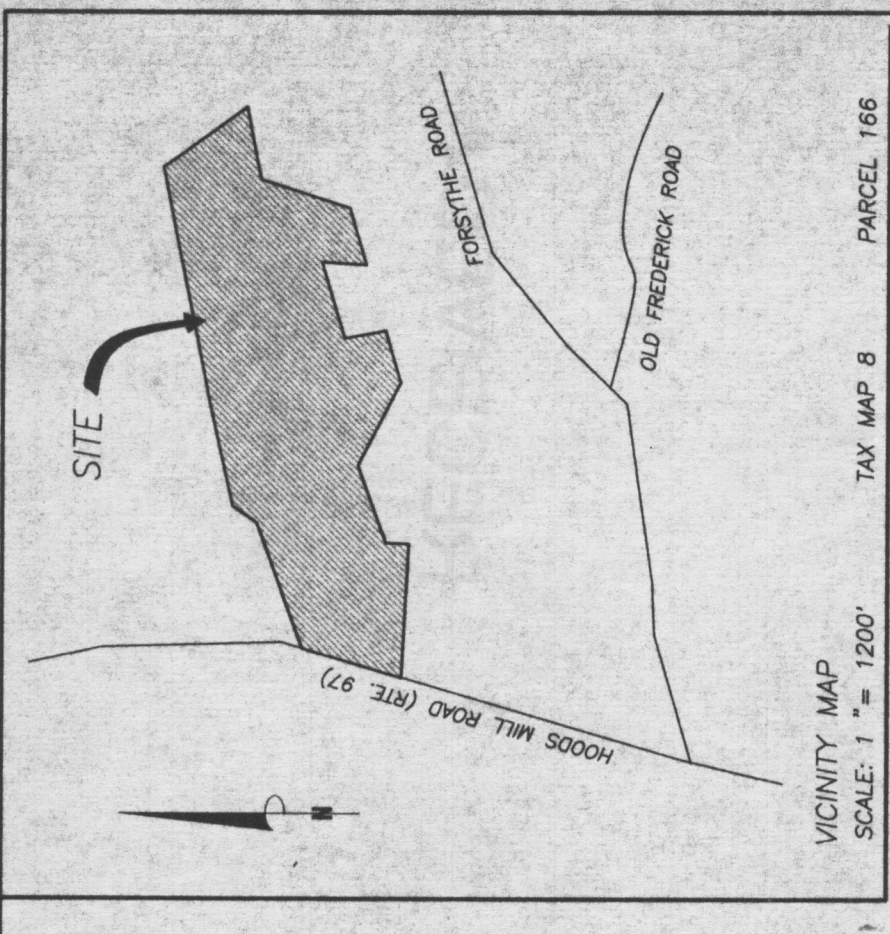

DATE: _____ REVISIONS: _____

MULLINX PROPERTY
LIBER 896 FOLIO 217

CONCEPT PLAN

SITUATED ON EAST SIDE OF HOODS MILL ROAD (RTE. 97)
HOWARD COUNTY, MARYLAND
SCALE: 1" = 100' FEBRUARY, 2002

ASSOCIATES, INC.
Engineers, Surveyors, Planners
10000 WOODBURN ROAD
CROFTON, MARYLAND 21114
(301) 424-8800 (cell) 301-304-2211