

LAYOUT 1/23/02 11am ^{Cancelled} INSP 4 4/2/02 NOON - PUMP/ALARM
 LAYOUT INSP 2 1/30/02 11AM INSP 5 _____
 INSP 3 1/31/02 PM INSP 6 _____

ISSUE DATE: 1/17/2002
 APPROVAL DATE: 4/2/02

P 516474
 A 511334-D

**PERMIT
INDEXED**

**ON-SITE SEWAGE DISPOSAL SYSTEM
HOWARD COUNTY HEALTH DEPARTMENT
BUREAU OF ENVIRONMENTAL HEALTH**

04-364856

(Whispering pipes)

Union Paving Company Inc., _____ IS PERMITTED TO INSTALL ALTER

ADDRESS: 5977 Sandy Ridge Road PHONE NUMBER: 410-379-6463

SUBDIVISION: Sollers Property LOT NUMBER: 4

ADDRESS: 17280 Old Frederick Rd. PROPERTY OWNER: Altieri Altieri Enterprises, Inc.

SEPTIC TANK CAPACITY (GALLONS): 1250 OUTLET BAFFLE FILTER REQUIRED

PUMP CHAMBER CAPACITY (GALLONS): 1250 COMPARTMENTED TANK REQUIRED

NUMBER OF BEDROOMS: 4

SQUARE FEET PER BEDROOM: 210

LINEAR FEET OF TRENCH REQUIRED: 280

TRENCHES:	Trench to be 3.0 feet wide. Inlet 4.0 feet below original grade. Bottom maximum depth 6.0 feet below original grade. Effective area begins at 4.0 feet below original grade. 2.0 feet of stone below distribution pipe.
LOCATION:	Place distribution box as shown per plan. Run trenches on contour in both directions.
NOTES:	No basement service by gravity. PUMPED SYSTEM

PLANS APPROVED: KG On SRN 12/14/01 DATE: 12/13/01

- NOTE: PERMIT VOID AFTER 2 YEARS
- NOTE: CONTRACTOR RESPONSIBLE FOR SCHEDULING A PRE-CONSTRUCTION INSPECTION FOR ALL INSTALLATIONS
- NOTE: WATERTIGHT SEPTIC TANKS REQUIRED
- NOTE: ALL PARTS OF SEPTIC SYSTEM SHALL BE 100 FEET FROM ANY WATER WELL
- NOTE: MANHOLE RISERS REQUIRED ON ALL SEPTIC TANKS AND PUMP CHAMBERS UNLESS SPECIFICALLY AUTHORIZED


NEITHER THE HOWARD COUNTY COUNCIL NOR THE HEALTH DEPARTMENT IS RESPONSIBLE FOR THE SUCCESSFUL OPERATION OF ANY SYSTEM PERMITTEE RESPONSIBLE FOR OBTAINING FINAL APPROVAL ON THIS PERMIT CALL 410-313-2640 FOR INSPECTION OF SEPTIC SYSTEM

BUILDING PERMIT SIGNED AND RETURNED 2-08-02
 B00134250-46 LP TANK
 6-20-05 B00154002-SUPRUM + LIBRARY

SEWER PERMIT SIGNED AND RETURNED 2-20-02
 B00134458
 DECK 16 2014 w/STEP

A511334-D

NOT TO SCALE

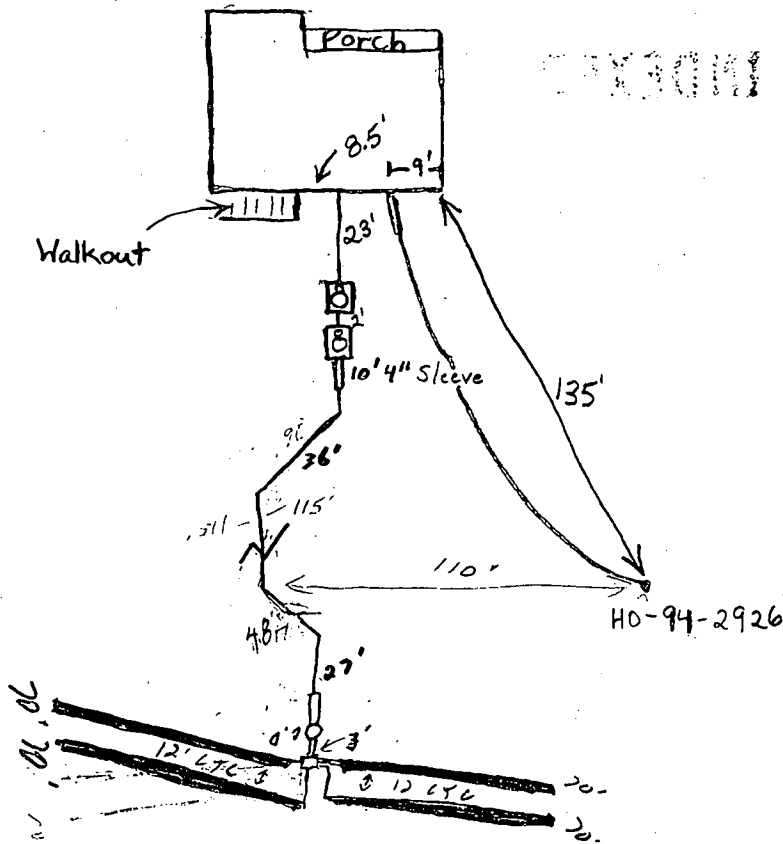

TRENCH DATA

TRENCH WIDTH 3'
 TRENCH INLET DEPTH 4'
 TRENCH BOTTOM DEPTH 6'
 DEPTH OF STONE 2'
 NUMBER OF TRENCHES 4
 TOTAL TRENCH LENGTH 280
 ABSORBENT AREA 840 ft²
 DISTRIBUTION BOX LEVEL
 BAFFLE IN DISTRIBUTION BOX

SEPTIC TANK DATA

SEPTIC TANK 1250 TS GALLONS
 MANHOLE RISER Yes
 6 INCH INSPECTION PORT Yes

PUMP CHAMBER DATA

PUMP CHAMBER GALLONS 1250 TS
 MANHOLE RISER Yes and 6" cleanout
 ALARM Functional
 PUMP PERFORMANCE TEST OK

PRE-CONSTRUCTION INSPECTION: Old Frederick Road 1/30/02 To run 70' trenches in both

directions from center of easement (BB)

INSPECTION COMMENTS: 1/30/02 Tanks set. O.K. to backfill around them (BB)

1/31/02 Told contr. not to put cleanouts on pressure line. O.K. to cover all work. Pump & Alarm tests needed (SC)

4/2/02 Cleanout by D.B. has been run over, dug up to repair. Pump & Alarm tests OK (SC)

INSPECTOR

[Signature]

DATE SYSTEM APPROVED

**BUILDING PERMITS DIVISION
 AND RETURNED**

