


HEALTH DEPT.

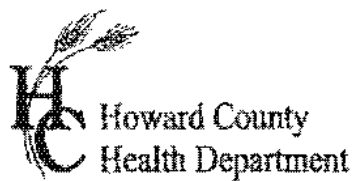

# APPLICATION

## FOR PERCOLATION TESTING AND SITE EVALUATION

TEST DATE(S) \_\_\_\_\_ TEST TIME \_\_\_\_\_

AP 544530

AGENCY REVIEW: \_\_\_\_\_

DATE 2-13-13

DO NOT WRITE ABOVE THIS LINE

I HEREBY APPLY FOR THE NECESSARY TESTING/EVALUATION PRIOR TO ISSUANCE OF SEWAGE DISPOSAL SYSTEM PERMIT(S) TO:

CHECK AS NEEDED:

- CONSTRUCT NEW SEPTIC SYSTEM(S)
- REPAIR/ADD TO AN EXISTING SEPTIC SYSTEM
- REPLACE AN EXISTING SEPTIC SYSTEM

N/A

CHECK AS NEEDED:

- NEW STRUCTURE(S)
- ADDITION TO AN EXISTING STRUCTURE
- REPLACE AN EXISTING STRUCTURE

CHECK ONE:

- CREATE NEW LOT(S)
- BUILD ON AN EXISTING LOT IN A SUBDIVISION
- BUILD ON AN EXISTING PARCEL OF RECORD

IS THE PROPERTY WITHIN 2500' OF ANY RESERVOIR?

- YES
- NO

THE TYPE OF STRUCTURE IS:

- RESIDENTIAL WITH 0 PROPOSED BEDROOMS IN THE COMPLETED STRUCTURE (NOTE UNKNOWN IF APPROPRIATE)
- COMMERCIAL (PROVIDE DETAIL OF NUMBERS AND TYPES OF EMPLOYEES/ CUSTOMERS ON ACCOMPANYING PLAN)
- INSTITUTIONAL/GOVERNMENT (PROVIDE DETAIL OF NUMBERS AND TYPES OF EMPLOYEES/USERS ON ACCOMPANYING PLAN)

PROPERTY OWNER(S) CHARLES & OLGA BARRISS

DAYTIME PHONE 301-748-9623 CELL --- FAX ---

MAILING ADDRESS 2005 MARYLAND RTE 97 COOKSVILLE MD. 21723  
STREET CITY/TOWN STATE ZIP

APPLICANT CHARLES R CROCKEN & ASSOC.

DAYTIME PHONE 410-549-2708 CELL --- FAX 410-549-9063

MAILING ADDRESS 902 LEE AVENUE SYKESVILLE MD. 21784  
STREET CITY/TOWN STATE ZIP

APPLICANT'S ROLE: DEVELOPER BUILDER BUYER RELATIVE/FRIEND REALTOR CONSULTANT

PROPERTY LOCATION  
SUBDIVISION/PROPERTY NAME EASTSIDE RTE 97 SOUTH OF FREDERICK RD. LOT NO. N/A

PROPERTY ADDRESS 2005 MD. RTE 97 COOKSVILLE, MD. 21723  
STREET TOWN/POST OFFICE

TAX MAP PAGE(S) 08 GRID 23 PARCEL(S) 225 PROPOSED LOT SIZE 0.61 AC.

AS APPLICANT, I UNDERSTAND THE FOLLOWING: THE SYSTEM INSTALLED SUBSEQUENT TO THIS APPLICATION IS ACCEPTABLE ONLY UNTIL PUBLIC SEWERAGE IS AVAILABLE. THIS APPLICATION IS COMPLETE WHEN ALL APPLICABLE FEES AND A SUITABLE SITE PLAN HAVE BEEN RECEIVED. I ACCEPT THE RESPONSIBILITY FOR COMPLIANCE WITH ALL M.O.S.H.A. AND "MISS UTILITY" REQUIREMENTS. APPROVAL IS BASED UPON SATISFACTORY REVIEW OF A PERC CERTIFICATION PLAN.

TEST RESULTS WILL BE MAILED TO APPLICANT.

Charles R Crocken  
SIGNATURE OF APPLICANT

HOWARD COUNTY HEALTH DEPARTMENT, BUREAU OF ENVIRONMENTAL HEALTH, WELL AND SEPTIC PROGRAM  
7178 COLUMBIA GATEWAY DRIVE COLUMBIA, MARYLAND 21046 (410) 313-2640 FAX (410) 313-2648  
TDD (410) 313-2323 TOLL FREE 1-877-4MD-DHMH




544530

2005 Rte 97 (Burriss)

4

①  
brn ban 1.4  
red brn L to fs 3.5  
Top of trench gravel water Inlet 4" below surface  
3.5 to Top of gravel  
gravel to ~3' below Inlet

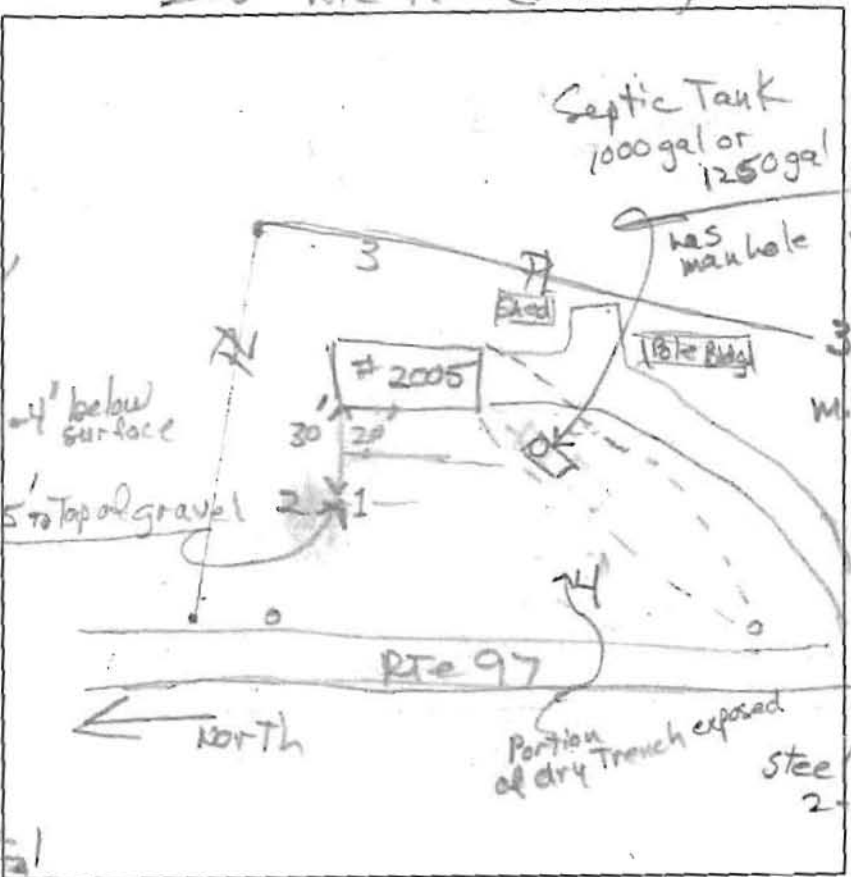

dk brn fs  
2fg  
dk brn fs  
brn L to sbk  
brn L to sbk  
2.5  
pale red  
& pale yellow fs  
3.8  
c. mica heavy  
pale red &  
pale yellow fs  
10.5  
pale brn & pale  
fs

②  
dk brn L 2fg  
dk brn L 2fg & 1 fsbk  
brn L 1 fsbk  
red L 2.2  
2 fsbk  
c. mica  
3.2  
pale red & pale yellow  
fs, many fine mica


HO-73-3074  
Steel Case 9.5' above grade  
2-pc metal cap

DATE	TEST #	DEPTH	START	BREAK 1" DROP	STOP 2" DROP	TIME OF 2ND INCH	P/F/H	
3/8/13	3	6' 11"	10:50	10:52	10:57	5	P	
3/8/13	2	11'	Visual			1.2 gpd / 10' 2"	P	
3/8/13	4	11'	Visual			3.5' to 7' OK 1.2 gpd / 10' 2"	P	
			4 Stony layer begins at East wall, runs North, layer goes to 2'					

③  
dk brn fs  
2fg to 1 fsbk  
brn L to sbk  
few mica  
3.5  
red fs  
c. mica  
4.2  
pale red & pale yellow fs  
many fine mica  
9'  
pale red fs  
& pale brn fs  
10  
pale red & pale brn  
water fs  
11.2 - pale brn & grey fs

10  
pale red & pale brn  
fs, c. mica  
13 d (grey)  
11.2  
Water hard brittle  
fs

REMARKS: Seam layer in SI. at ~2.5'  
SANITARIAN: RB BACKHOE: Gary King OTHERS: Red & Burl, Conker, Charles Burriss  
TEST HOLES USED IN SDA: 2, 3, 4 AVG. PERC TIME: SQ. FT/HR (125)  
TRENCH WIDTH: INLET DEPTH: MAX. BOT DEPTH: 7 EFFECTIVE S/W:

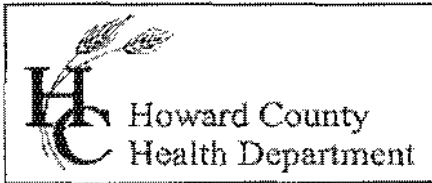

Bureau of Environmental Health  
 7178 Gateway Drive Columbia, MD 21046  
 (410) 313-2640 Fax (410) 313-2648  
 TDD (410) 313-2323 Toll Free 1-866-313-6300  
 website: www.hchealth.org

Maura J. Rossman, M.D., Acting Health Officer

# APPLICATION

## FOR PERCOLATION TESTING AND SITE EVALUATION

### PROPERTY LOCATION

SUBDIVISION/PROPERTY NAME East side Rt 97 South of Frederick Rd LOT # N/A

PROPERTY ADDRESS 2005 Rt 97 Cooksville MD 21723  
STREET TOWN ZIP

TAX ACCOUNT # \_\_\_\_\_ TAX MAP 09 GRID 23 PARCEL 225 ZONING DESIGNATION \_\_\_\_\_

PROPERTY OWNER(S) Charles + Olga Burress

DAYTIME PHONE 301-748-9623 CELL \_\_\_\_\_ EMAIL \_\_\_\_\_

MAILING ADDRESS 2005 Rt 97 Cooksville MD 21723  
STREET CITY, STATE ZIP

APPLICANT Charles R. Coacken + Assoc RELATIONSHIP TO OWNER: \_\_\_\_\_

DAYTIME PHONE 410-549-2708 CELL \_\_\_\_\_ EMAIL Fax 410-549-9063

MAILING ADDRESS 902 Lee Ave Sykesville MD 21784  
STREET CITY, STATE ZIP

I HEREBY APPLY FOR THE NECESSARY TESTING/EVALUATION PRIOR TO ISSUANCE OF SEWAGE DISPOSAL SYSTEM PERMIT(S):

- BUILDING:
- RESIDENTIAL WITH 0 EXISTING OR PROPOSED BEDROOMS IN THE COMPLETED STRUCTURE
  - COMMERCIAL (PROVIDE DETAIL OF TYPE OF USE AND NUMBERS OF EMPLOYEES/CUSTOMERS ON ACCOMPANYING PLAN)
- PROPERTY:
- SUBDIVISION: NUMBER OF LOTS INCLUDING RESIDUE: \_\_\_\_\_
  - CONSTRUCT NEW OSDS ON UNDEVELOPED LOT
  - REPAIR OR REPLACE FAILING OSDS
  - UPGRADE EXISTING OSDS
- IS THE PROPERTY WITHIN 2500 FEET OF ANY RESERVOIR?
- YES
  - NO

AS APPLICANT, I UNDERSTAND THE FOLLOWING:

- THIS APPLICATION IS VALID FOR TWO(2) YEARS FROM DATE OF FEE PAYMENT AND APPROVAL IS BASED UPON HEALTH OFFICER SIGNATURE OF A PERC CERTIFICATION PLAN PRIOR TO EXPIRATION OF THIS PERMIT.
- THE APPLICATION FEE IS NON-REFUNDABLE
- THIS APPLICATION MUST BE ACCOMPANIED BY ALL APPLICABLE FEES AND A SUITABLE SITE PLAN IN ORDER TO BE PROCESSED
- THIS IS A PUBLIC DOCUMENT

I declare and affirm that to the best of my knowledge, the information contained herein is correct. I declare that I am the owner of the property or duly authorized to make this application on behalf of the owner. I agree to comply with all applicable state and county regulations.

By signature of this application, I hereby grant Howard County Health Department officials the right to enter onto the property for the purpose of inspecting the property as directly related to the requested permit/service.

\_\_\_\_\_  
 SIGNATURE OF APPLICANT DATE

4/16/2013

Subject:  
Perce certification plan  
2005 Md. Rt 97

In accordance with the perce certification per Charles R Crocker Assoc. we request the following reduction in the sewage disposal area as follows:

1. Reduce property line set back from 10ft to 5 ft
2. Reduce house foundation set back from 20 ft to 10ft.

We would like to thank Howard Co. Health Department for consideration in this matter.

Charles L Burrell

Olya E Burrell

410-489-9320

2005 Rt 97


Cooksville, Md

21723

4/22/13

Approved

M. Davis

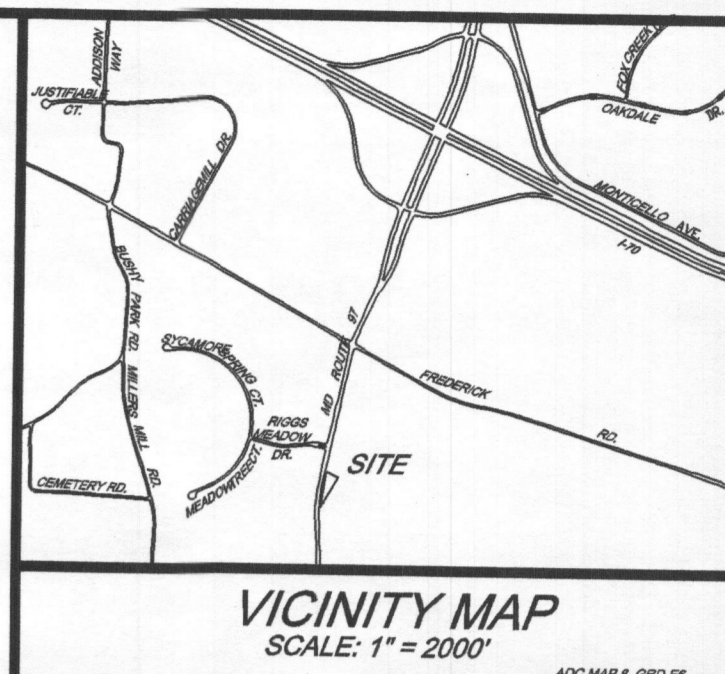


SOILS LEGEND		
SYMBOL	NAME/DESCRIPTION	SOIL GROUP
GgB	Glennville loam, 3 to 8 percent slopes	B
GgC	Glennville loam, 8 to 15 percent slopes	B
GmB	Glennville silt loam, 3 to 8 percent slopes	C
GmC	Glennville-Salts silt loam, 0 to 2 percent slopes	C

**GENERAL NOTES**

- OWNERS: CHARLES L. BURRISS  
OLGA E. BURRISS  
DEED REFERENCE: LIBER 2379, FOLIO 0059  
DATE: JULY 14, 1991  
GRANTOR: JAMES E. & ALMA L. BALSINGER
- TAX MAP 08, GRID 23, PARCEL 225
- THE BOUNDARY SHOWN HEREON IS BASED UPON CURRENT TITLE DEED.
- NEAREST PUBLIC WATER SUPPLY: DAMASCUS, DISTANCE 5 MILES (1)
- THERE IS NO 100 YEAR FLOOD PLAIN LOCATED ON THIS PROPERTY BASED ON FEMA INSURANCE RATE MAP COMMUNITY PANEL #240044-00007 B, 12/6/96.
- SUBJECT PROPERTY IS ZONED RC-DEQ.
- THE SUBJECT PROPERTY SHOWN HEREON IS NOT SUBJECT TO ANY ZONING CASES VARIANCES OR SPECIAL EXCEPTIONS.

**PERCOLATION CERTIFICATION NOTES**

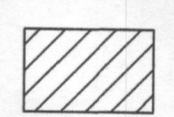
- ANY CHANGES TO THE PRIVATE SEWAGE EASEMENT SHOWN HEREON SHALL REQUIRE A REVISED PERCOLATION CERTIFICATION PLAN.
- TOPOGRAPHY SHOWN HEREON IS TAKEN FROM HOWARD COUNTY GIS PANELS 8 & 14 AND VERIFIED IN THE FIELD BY ORC & ASSOC. JANUARY, 2013.
- THERE ARE NO WELLS OR SEPTIC SYSTEMS LOCATED WITHIN 200 FEET OF THE PROPERTY BOUNDARY SHOWN HEREON.
- EXISTING WELL HO-73-7034 SHOWN HEREON HAVE BEEN FIELD LOCATED AND SHOWN ACCURATELY.
- THE PROPERTY SHOWN HEREON IS SUBJECT TO AN EXEMPTION FROM THE MINIMUM OWNERSHIP WIDTH AND LOT AREA AS REQUIRED BY THE MARYLAND DEPARTMENT OF THE ENVIRONMENT AND HOWARD COUNTY BASED UPON CONVEYANCE TO MD STATE HIGHWAY ADMINISTRATION AS SHOWN ON MD SRC RIGHT OF WAY PLAT # 6888, DATED 10/11/1951.
- 

THIS AREA DESIGNATES A PRIVATE SEWAGE AREA AS REQUIRED BY THE MARYLAND STATE DEPARTMENT OF THE ENVIRONMENT FOR INDIVIDUAL SEWAGE DISPOSAL FOR LOTS CREATED PRIOR TO MARCH OF 1972 IT PROVIDES AT LEAST ENOUGH AREA TO ACCOMMODATE AN INITIAL AND TWO REPLACEMENT SEPTIC SYSTEMS AS REQUIRED BY THE HOWARD COUNTY HEALTH DEPARTMENT. IMPROVEMENTS OF ANY NATURE IN THIS AREA ARE RESTRICTED UNTIL PUBLIC SEWERAGE IS AVAILABLE. THIS AREA SHALL BECOME NULL AND VOID UPON CONNECTION TO A PUBLIC SEWERAGE SYSTEM. THE COUNTY HEALTH OFFICER SHALL HAVE THE AUTHORITY TO GRANT ADJUSTMENTS TO THE PRIVATE SEWAGE AREA. RECORDATION OF A MODIFIED SEWAGE AREA SHALL NOT BE NECESSARY.

**PLOT PLAN / PERCOLATION CERTIFICATION PLAN**

**PURPOSE NOTE:**  
THE PURPOSE OF THE PLAN IS TO ACCOMPANY BUILDING PERMIT APPLICATION #B12005891 FOR THE GARAGE SHOWN HEREON ( UNDER CONSTRUCTION) AND FOR THE PERCOLATION TEST CERTIFICATION REQUIRED BY THE HOWARD COUNTY HEALTH DEPARTMENT.

**ZONING NOTE:**  
THE PROPERTY SHOWN HEREON WAS CREATED BY DEED LIBER 059, FOLIO 110 DATED 7/29/1891 AND SUBJECT TO A CONVEYANCE TO THE MARYLAND STATE HIGHWAY ADMINISTRATION AS SHOWN ON MD SRC RIGHT OF WAY PLAT # 6888, DATED 10/11/1951 IS EXEMPT FROM THE HOWARD COUNTY ZONING REGULATIONS SECTION 104E 4.b.(1) TO PERMIT A FRONT SETBACK OF 37 FT. IN LIEU OF THE REQUIRED SETBACK OF 50 FT. FOR THE GARAGE SHOWN HEREON.

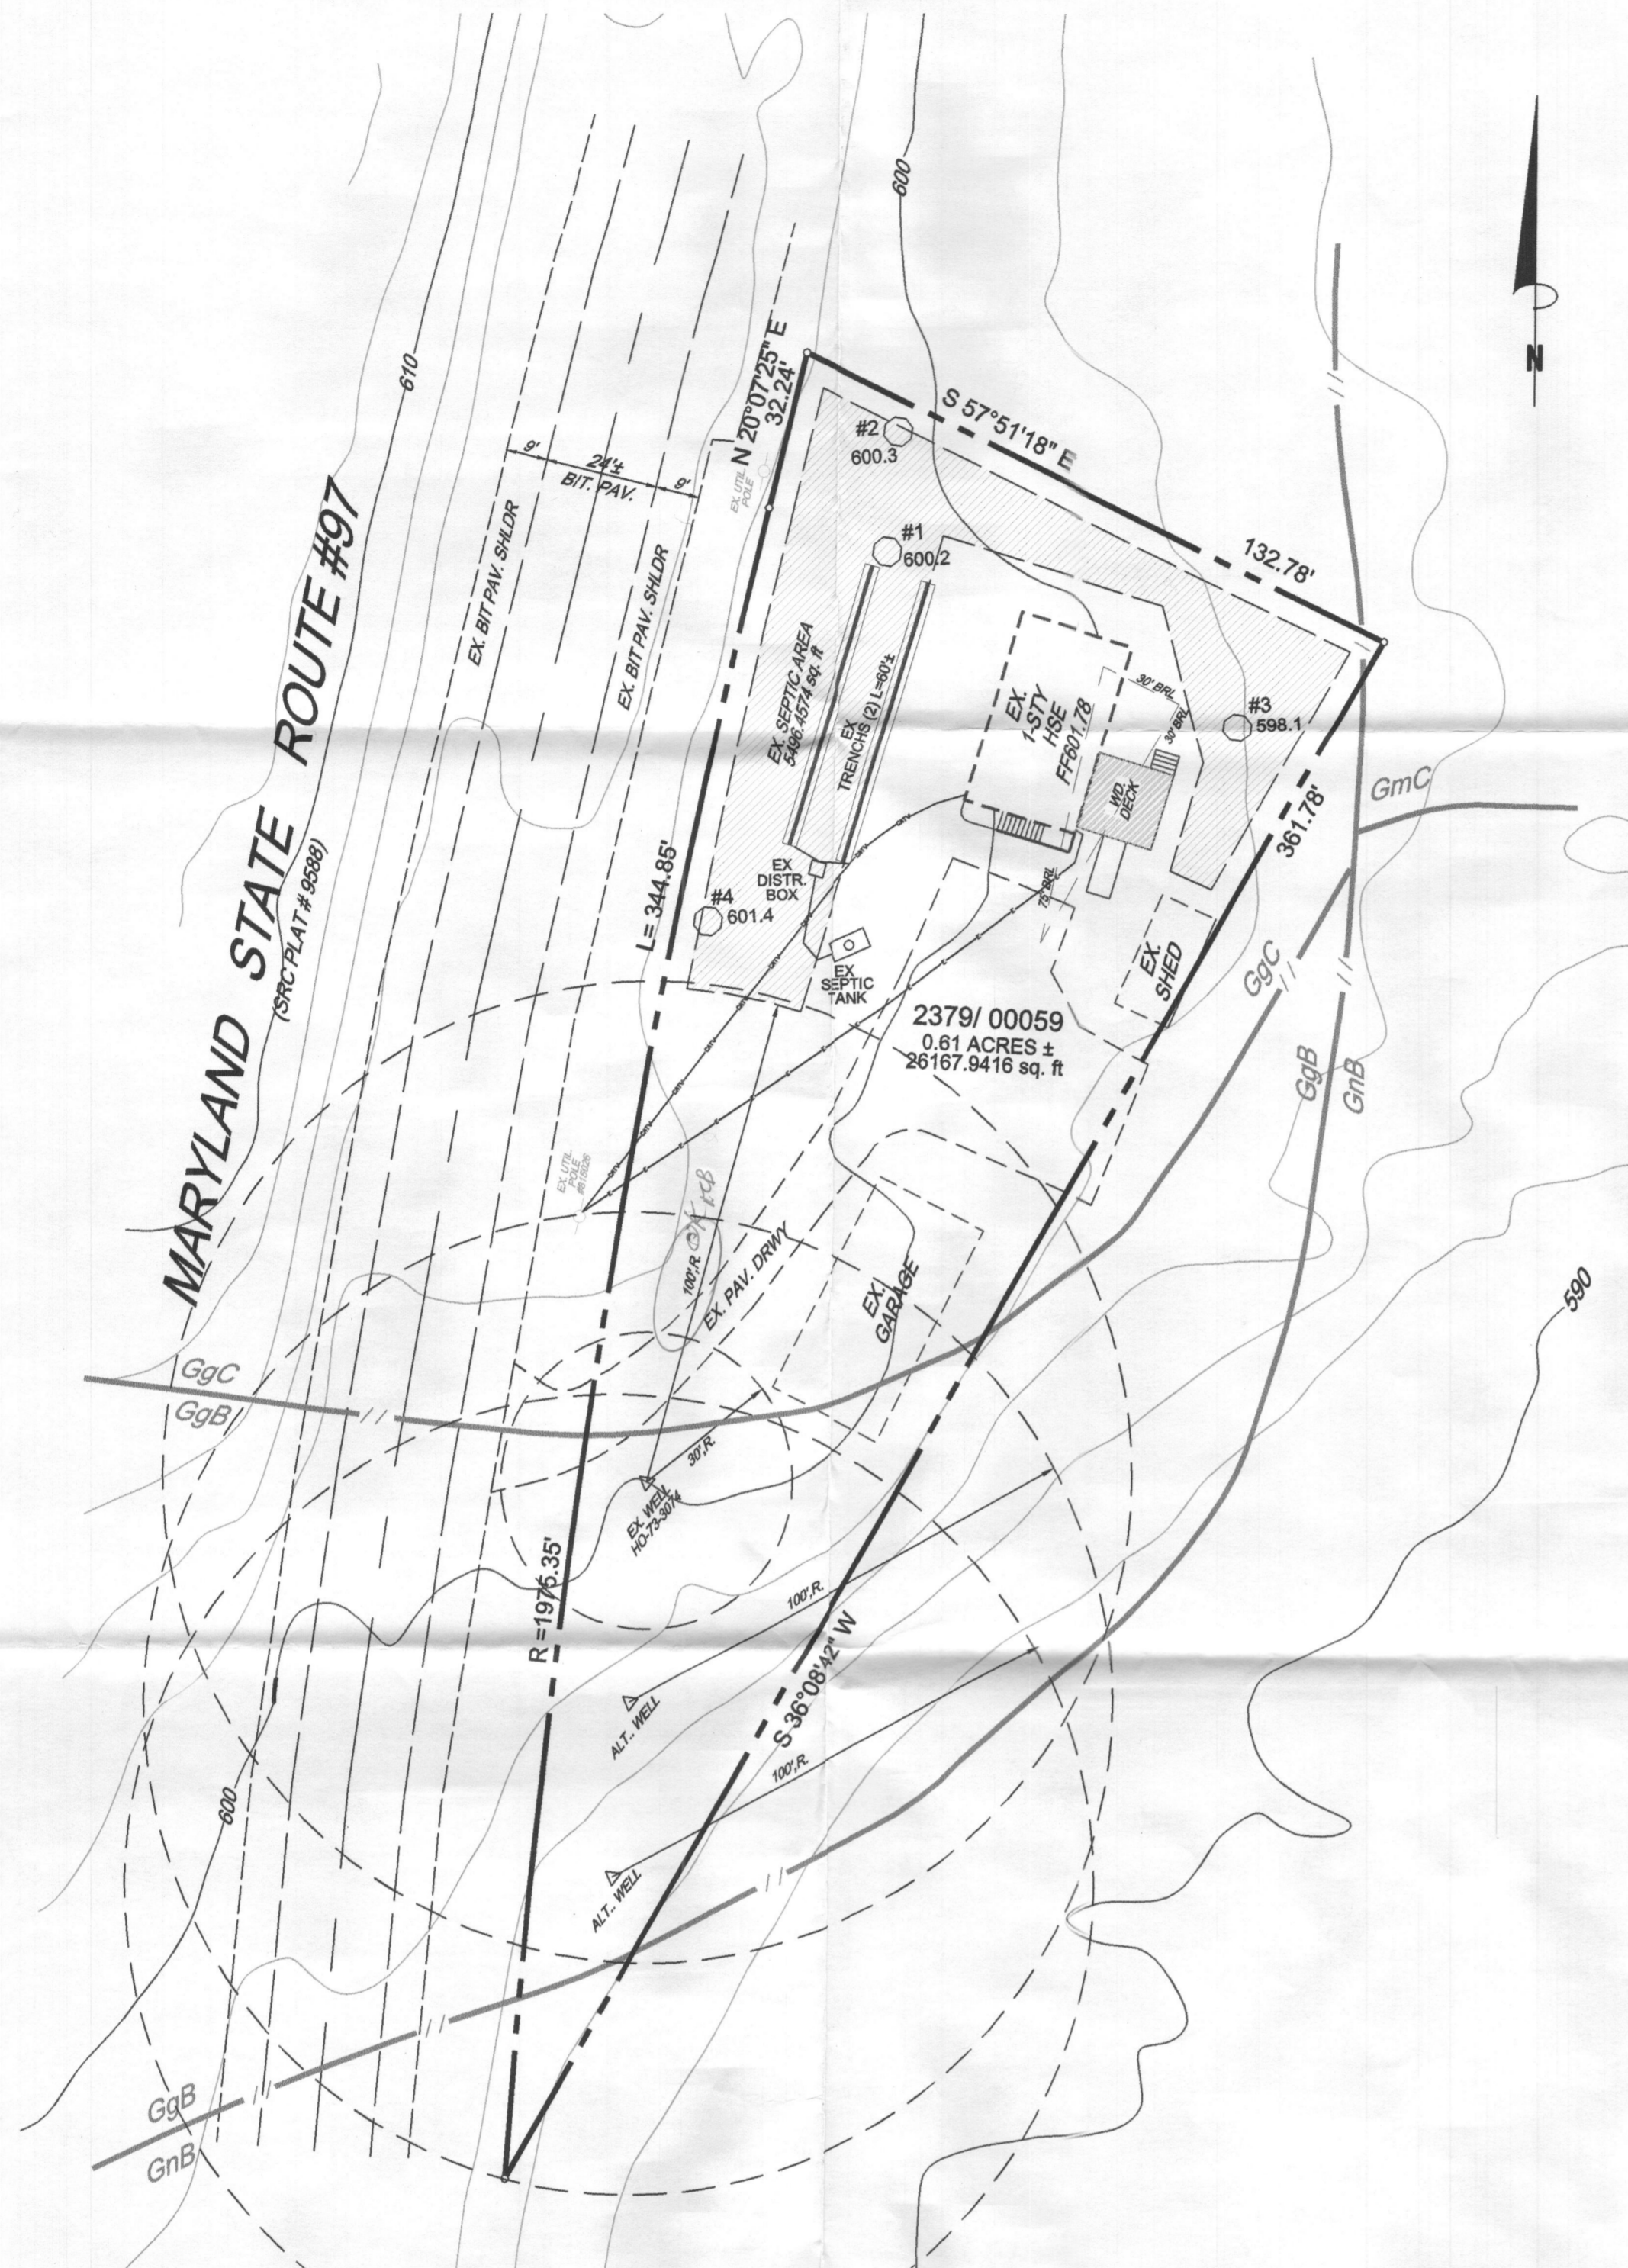

**LEGEND**

- EX. PROPERTY LINE
- EX. RIGHT-OF-WAY
- PROP. LOT LINES
- EX. EASEMENTS
- EX. CONTOURS
- PROP. CONTOURS
- EX. TREEMOODS LINE
- SOILS LINE
- LIMIT OF DISTURBANCE
- DENOTES SLOPES 25% OR GREATER
- DENOTES SLOPES 15-25%
- EX. SEWAGE DISPOSAL AREA
- STABILIZED CONSTRUCTION ENTRANCE
- SUPER SILT FENCE
- SILT FENCE

**OWNER / DEVELOPER:**  
CHARLES L. BURRISS  
OLGA E. BURRISS  
2005 MARYLAND ROUTE 97  
COOKSVILLE MD 21723-9307

**PROFESSIONAL CERTIFICATION**  
I HEREBY CERTIFY THAT THESE DOCUMENTS WERE PREPARED OR APPROVED BY ME AND THAT I AM A DULY LICENSED PROFESSIONAL ENGINEER UNDER THE LAWS OF THE STATE OF MARYLAND. LICENSE NO. 7803 EXPIRATION DATE 4-22-2012

*Charles R. Crocken* 3-26-13  
CHARLES R. CROCKEN, PE MD, LICENSE REG. NO. 7803 DATE

APPROVED: FOR PRIVATE WATER AND PRIVATE SEWERAGE SYSTEMS

*Baldevon M. Manna-Rasmussen* 4/22/2013  
HEALTH OFFICER, HOWARD CO. HEALTH DEPT. DATE

REVISION	
NO.	DATE

**HEALTH DEPARTMENT PLAN**  
**2005 MARYLAND ROUTE 97**  
**LIBER 2379/ FOLIO 00059**

TAX MAP 08 GRID 23 PARCEL 225  
4TH ELECTION DISTRICT


ZONED - "RC-DEQ"  
HOWARD COUNTY, MARYLAND

Prepared by: CHARLES R. CROCKEN AND ASSOCIATES, INC.  
Civil Engineering - Land Planning  
902 LEE AVE.  
SYKESVILLE, MD 21784  
Tel. (410) 549-2708  
Fax. (410) 549-9063


3-26-13  
DATE

*Charles R. Crocken*  
LICENSE NO. 7803  
EXPIRATION DATE: APRIL 22, 2013

TAX MAP 08 GRID 23 PARCEL 225	PROJECT NO.:
DESIGNED BY: C.R.C.	DATE: FEB. 12, 2013
DRAWN BY: C.H.C.	SCALE: 1" = 30'
	DRAWING NO. 1 OF 1

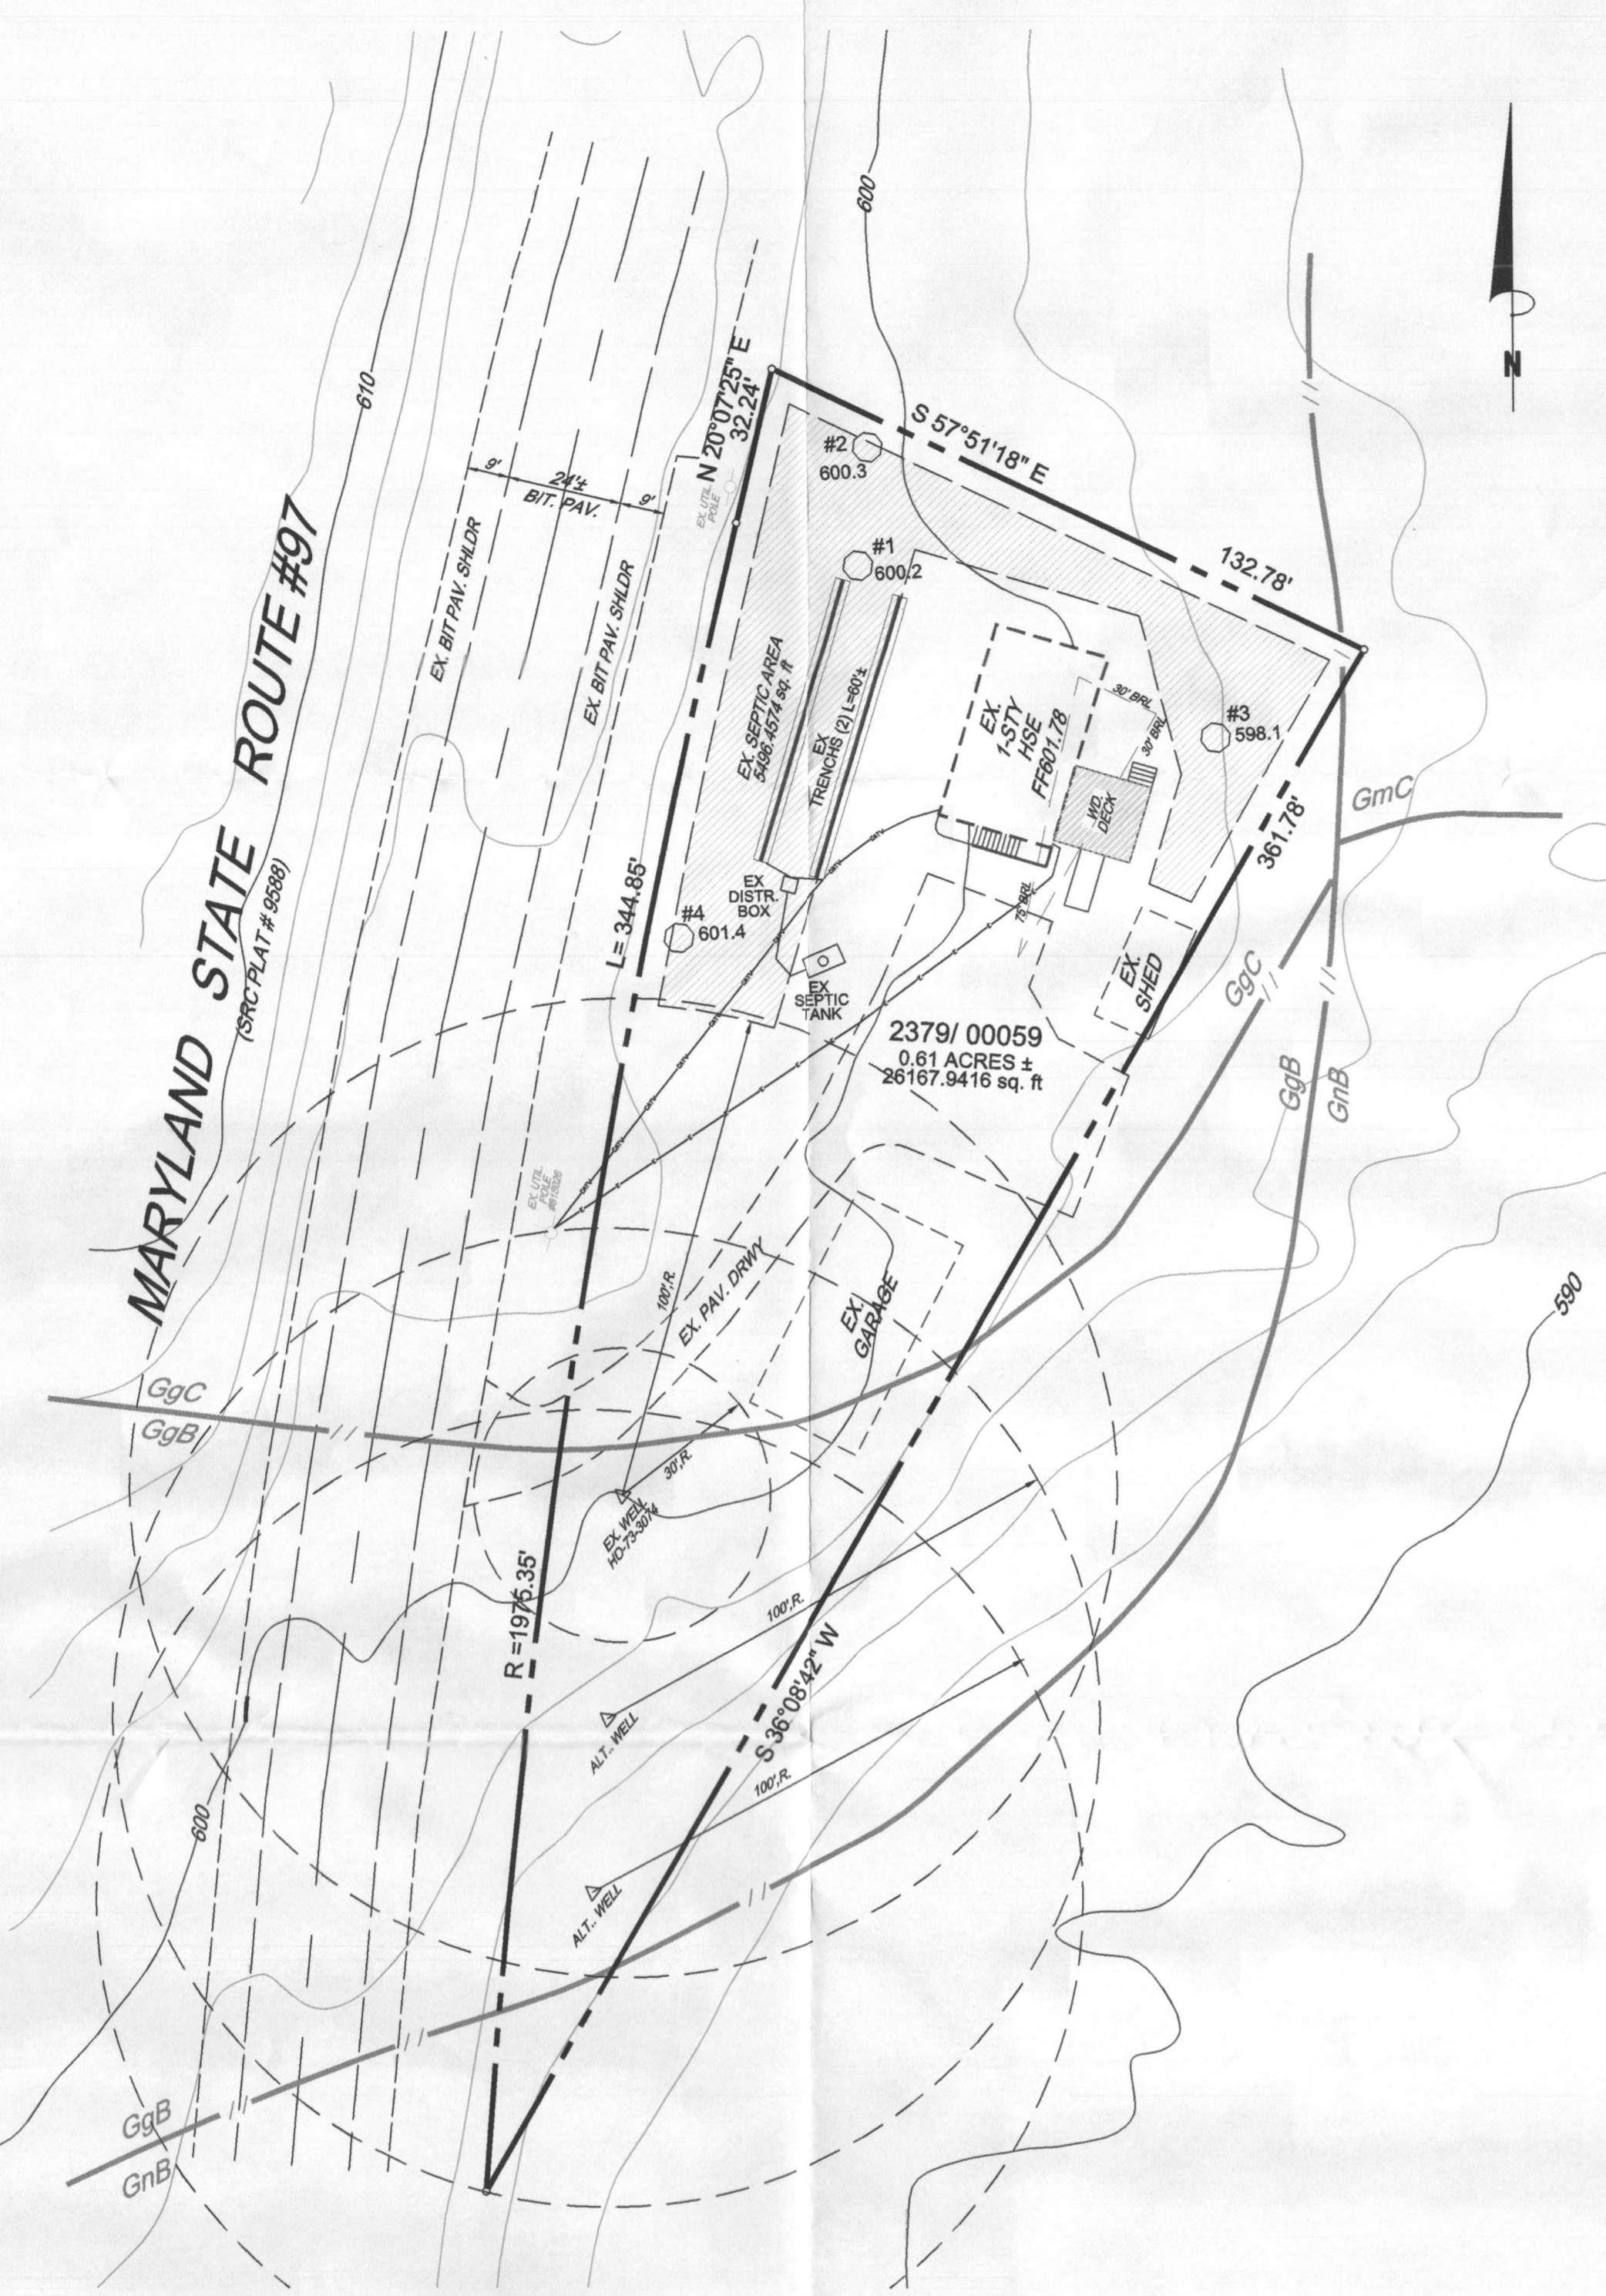

SOILS LEGEND		
SYMBOL	NAME/DESCRIPTION	SOIL GROUP
GgB	Glennville loam, 3 to 6 percent slopes	B
GgC	Glennville loam, 8 to 15 percent slopes	B
GmB	Glennville silt loam, 3 to 6 percent slopes	C
GmC	Glennville-Silt loam, 0 to 6 percent slopes	C

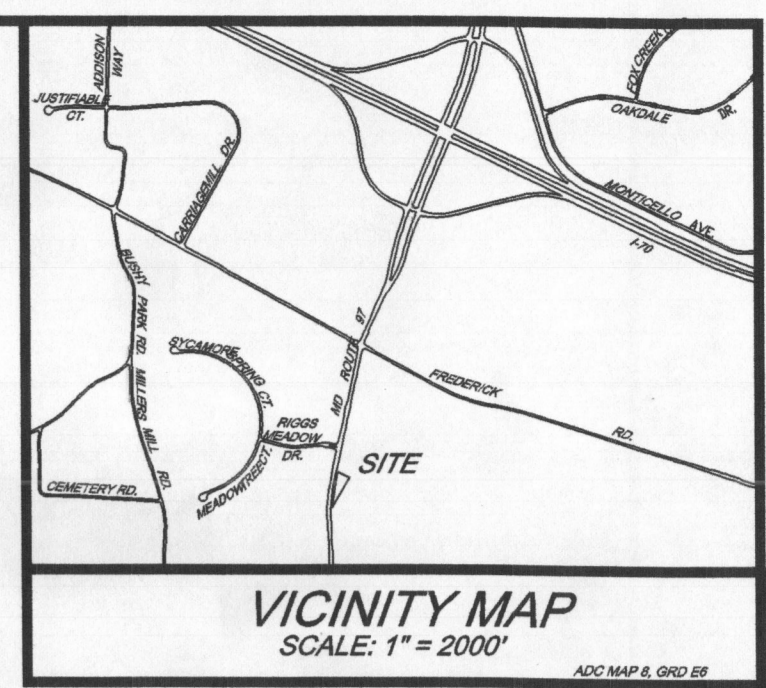

- GENERAL NOTES**
- OWNERS: CHARLES L. BURRISS  
OLGA E. BURRISS  
DEED REFERENCE: LIBER 2379, FOLIO 0059  
DATE: JULY 14, 1991  
GRANTOR: JAMES E. & ALMA L. BALSINGER
  - TAX MAP 08, GRID 23, PARCEL 225
  - THE BOUNDARY SHOWN HEREON IS BASED UPON CURRENT TITLE DEED.
  - NEAREST PUBLIC WATER SUPPLY, DAMASCUS, DISTANCE 5 MILES ±
  - THERE IS NO 100 YEAR FLOOD PLAIN LOCATED ON THIS PROPERTY BASED ON FEMA INSURANCE RATE MAP COMMUNITY PANEL #240044-00007 B, 12/4/86.
  - SUBJECT PROPERTY IS ZONED RC-DEO.
  - THE SUBJECT PROPERTY SHOWN HEREON IS NOT SUBJECT TO ANY ZONING CASES VARIANCES OR SPECIAL EXCEPTIONS

- PERCOLATION CERTIFICATION NOTES**
- ANY CHANGES TO THE PRIVATE SEWAGE EASEMENT SHOWN HEREON SHALL REQUIRE A REVISED PERCOLATION CERTIFICATION PLAN.
  - TOPOGRAPHY SHOWN HEREON IS TAKEN FROM HOWARD COUNTY GIS PANELS 8 & 14 AND VERIFIED IN THE FIELD BY CRC & ASSOC. JANUARY, 2013.
  - THERE ARE NO WELLS OR SEPTIC SYSTEMS LOCATED WITHIN 300 FEET OF THE PROPERTY BOUNDARY SHOWN HEREON.
  - EXISTING WELL HO-73-7034 SHOWN HEREON HAVE BEEN FIELD LOCATED AND SHOWN ACCURATELY.
  - THE PROPERTY SHOWN HEREON IS SUBJECT TO AN EXEMPTION FROM THE MINIMUM OWNERSHIP WIDTH AND LOT AREA AS REQUIRED BY THE MARYLAND DEPARTMENT OF THE ENVIRONMENT AND HOWARD COUNTY BASED UPON CONVEYANCE TO MD STATE HIGHWAY ADMINISTRATION AS SHOWN ON MD SRC RIGHT OF WAY PLAT # 6588, DATED 10/11/1951.
  - THIS AREA DESIGNATES A PRIVATE SEWAGE AREA AS REQUIRED BY THE MARYLAND STATE DEPARTMENT OF THE ENVIRONMENT FOR INDIVIDUAL SEWAGE DISPOSAL FOR LOTS CREATED PRIOR TO MARCH OF 1972. IT PROVIDES AT LEAST ENOUGH AREA TO ACCOMMODATE AN INITIAL AND TWO REPLACEMENT SEPTIC SYSTEMS AS REQUIRED BY THE HOWARD COUNTY HEALTH DEPARTMENT. IMPROVEMENTS OF ANY NATURE IN THIS AREA ARE RESTRICTED UNTIL PUBLIC SEWERAGE IS AVAILABLE. THIS AREA SHALL BECOME NULL AND VOID UPON CONNECTION TO A PUBLIC SEWERAGE SYSTEM. THE COUNTY HEALTH OFFICER SHALL HAVE THE AUTHORITY TO GRANT ADJUSTMENTS TO THE PRIVATE SEWAGE AREA RECORDATION OF A MODIFIED SEWAGE AREA SHALL NOT BE NECESSARY.

**PLOT PLAN / PERCOLATION CERTIFICATION PLAN**

**PURPOSE NOTE:**  
THE PURPOSE OF THE PLAN IS TO ACCOMPANY BUILDING PERMIT APPLICATION #B12003981 FOR THE GARAGE SHOWN HEREON ( UNDER CONSTRUCTION ) AND FOR THE PERCOLATION TEST CERTIFICATION REQUIRED BY THE HOWARD COUNTY HEALTH DEPARTMENT.

**ZONING NOTE:**  
THE PROPERTY SHOWN HEREON WAS CREATED BY DEED LIBER 059, FOLIO 110 DATED 7/29/1891 AND SUBJECT TO A CONVEYANCE TO THE MARYLAND STATE HIGHWAY ADMINISTRATION AS SHOWN ON MD SRC RIGHT OF WAY PLAT # 6588, DATED 10/11/1951 IS EXEMPT FROM THE HOWARD COUNTY ZONING REGULATIONS SECTION 104E 4.b.(1) TO PERMIT A FRONT SETBACK OF 37 FT. IN LIEU OF THE REQUIRED SETBACK OF 50 FT. FOR THE GARAGE SHOWN HEREON.

**PROFESSIONAL CERTIFICATION**  
I HEREBY CERTIFY THAT THESE DOCUMENTS WERE PREPARED OR APPROVED BY ME AND THAT I AM A DULY LICENSED PROFESSIONAL ENGINEER UNDER THE LAWS OF THE STATE OF MARYLAND. LICENSE NO. 7803 EXPIRATION DATE 4-22-2012

*Charles R. Crocken* 3-26-13  
CHARLES R. CROCKEN, PE MD LICENSE REG. NO. 7803 DATE

**LEGEND**

EX. PROPERTY LINE	---
EX. RIGHT-OF-WAY	- - - - -
PROP. LOT LINES	---
EX. EASEMENTS	---
EX. CONTOURS	.....
PROP. CONTOURS	.....
EX. TREEWOODS LINE	~~~~~
SOILS LINE	---H/C2---H/6B2---
LIMIT OF DISTURBANCE	100
DENOTES SLOPES 25% OR GREATER	■
DENOTES SLOPES 15-25%	■
EX. SEWAGE DISPOSAL AREA	SDA
STABILIZED CONSTRUCTION ENTRANCE	SCE
SUPER SILT FENCE	---SF---SF---
SILT FENCE	---SF---

**OWNER / DEVELOPER:**  
CHARLES L. BURRISS  
OLGA E. BURRISS  
2005 MARYLAND ROUTE 97  
COOKSVILLE MD 21723-9307

APPROVED: FOR PRIVATE WATER AND PRIVATE SEWERAGE SYSTEMS

*Richard M. Moore* 4/22/2013  
HEALTH OFFICER, HOWARD CO. HEALTH DEPT. DATE

REVISION	
NO.	DATE
HEALTH DEPARTMENT PLAN 2005 MARYLAND ROUTE 97 LIBER 2379/ FOLIO 00059	
TAX MAP 08 GRID 23 PARCEL 225 4TH ELECTION DISTRICT	
ZONED - "RC-DEO" HOWARD COUNTY, MARYLAND	
Prepared by:	CHARLES R. CROCKEN AND ASSOCIATES, INC. Civil Engineering - Land Planning 902 LEE AVE. SYKESVILLE, MD 21784 Tel. (410) 549-2708 Fax. (410) 549-9093
TAX MAP 08 GRID 23 PARCEL 225	PROJECT NO.:
DESIGNED BY: C.R.C.	DATE: FEB. 12, 2013
DRAWN BY: C.H.C.	SCALE: 1" = 30'
DRAWING NO. 1 OF 1	