


Post-it® Fax Note 7671

To Zach  
Co./Dept. FSH  
Phone # 410 313 2773  
Fax # 410 313 2648

From Gabe Cregg  
Co. Howard Co.  
Phone # 410 313 2773  
Fax # 410 313 2648

# of pages 1

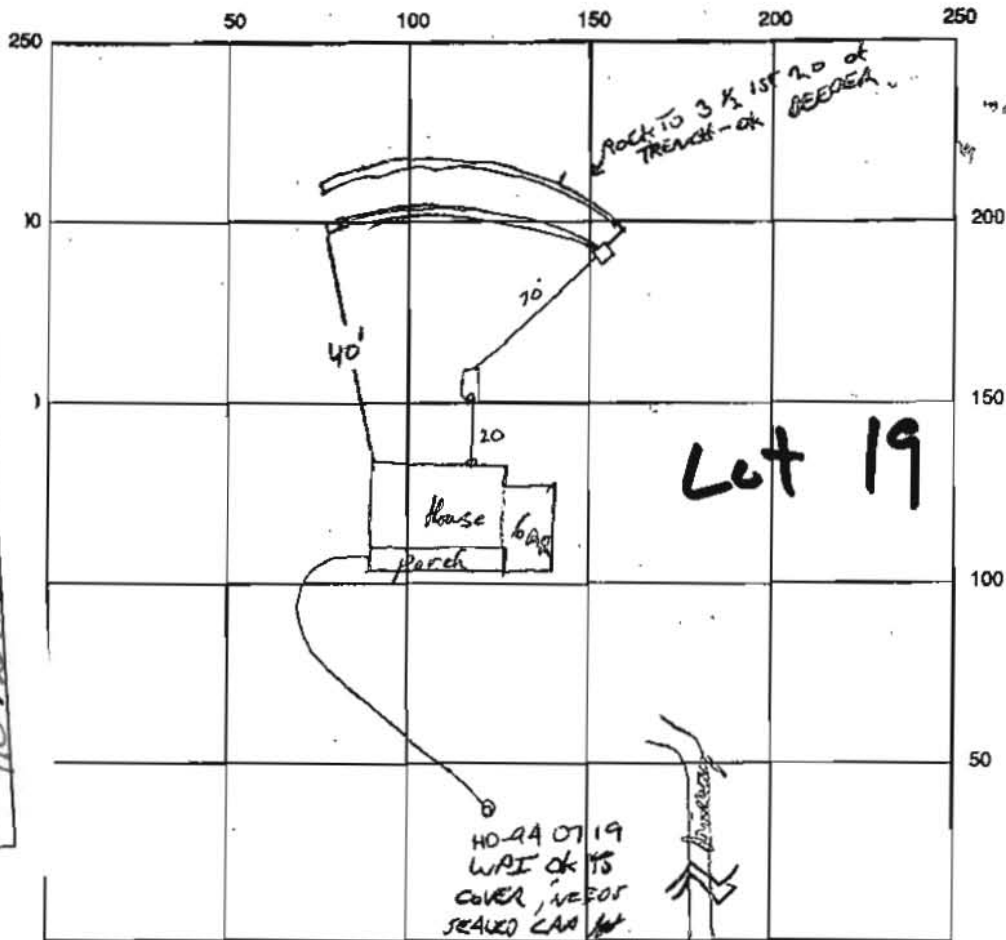

W.P.I.  
8/30/96  
H

Well working  
INDICATE NORTH - NAME ADJOINING ROADWAY AS BASE LINE

SEPTIC TANK LEVEL OK CLEANOUTS 1 ON TANK, 1 AT HOUSE

DISTRIBUTION BOX LEVEL OK

DRAIN FIELD/TITLE DEPTH 5 1/2 - 7 FT. TRENCH WIDTH 2 FT. INLET DEPTH 2 1/2 FT.

EFFECTIVE GRAVEL DEPTH 4 FT. TOTAL LENGTH 105 / 105 FT.

NUMBER OF TRENCHES 2 ONE SIDEWALL/BOTTOM AREA \_\_\_\_\_ SQ. FT.

DRYWALL INSIDE DIAMETER — FT. EFFECTIVE DEPTH BELOW INLET — FT.

ABSORBENT AREA — SQ. FT.

REMARKS: No septic work done today 8/27/96 RP 8/30/96 ok to store TRENCHES,  
ok to COVER TANK. 8/30/96 TRENCHES COMPLETE,  
ok to COVER

DATE SYSTEM APPROVED 8/30/96 INSPECTOR Blair Jansen