



Howard County Health Department

Bureau of Environmental Health
8930 Stanford Boulevard, Columbia, MD 21045
Main: 410-313-2640 | Fax: 410-313-2648
TDD 410-313-2323 | Toll Free 1-866-313-6300
www.hchealth.org
Facebook: www.facebook.com/hocohealth

Maura J. Rossman, M.D., Health Officer

RECEIPT DATE: 3/27/17 ONSITE SEWAGE DISPOSAL SYSTEM

P 560580

APPROVAL DATE: 3/30/17 PERMIT: CONSTRUCTION

A

PROPERTY ADDRESS: 2049 Drovers Lane

SUBDIVISION: Vista Ridge LOT: 15 TAX ID: 04-595480

CONTRACTOR: Fogel's EMAIL:

CONTRACTOR ADDRESS: 580 Obrecht Road PHONE:

PROPERTY OWNER: DR Horton, Inc. EMAIL:

OWNER ADDRESS: 1356 Beverly Road, Suite 300 PHONE: 800-551-5015

SEPTIC TANK SIZE (GALLONS): 2000 TANK MANUFACTURER: Mayer Bros, Inc

PUMP MODEL: PUMP SIZE: PUMP TANK CAPACITY:

DISTRIBUTION SYSTEM: [X] GRAVITY [] PRESSURE DOSED BEDROOMS: 6 APPLICATION RATE: 1.2


Table with 2 columns: Field Name (TRENCHES, LOCATION, NOTES) and Field Value (Linear feet required: 156, Inlet depth: 3, etc.)

ISSUED BY: Hank Oswald ISSUE DATE: 3/23/17 EXPIRATION DATE: 3/23/18

- NOTE: CONTRACTOR MUST SCHEDULE A PRE-CONSTRUCTION INSPECTION PRIOR TO BEGINNING ANY INSTALLATION
NOTE: CONTRACTOR MUST SCHEDULE AN INSPECTION AND GAIN APPROVAL OF ALL COMPONENTS PRIOR TO COVERING
NOTE: STONE MUST BE APPROVED BY HEALTH DEPARTMENT AND GRAVEL TICKET MUST BE AVAILABLE FOR REVIEW.
NOTE: WATERTIGHT TANKS REQUIRED
NOTE: ALL PARTS OF SEPTIC SYSTEM SHALL BE AT LEAST 100 FEET DOWNGRAIENT FROM ANY WATER WELL
NOTE: MANHOLE RISERS REQUIRED ON ALL SEPTIC TANKS AND PUMP CHAMBERS
NOTE: AN ELECTRICAL PERMIT IS REQUIRED FOR INSTALLATION OF ANY ELECTRICAL COMPONENTS OF THE SYSTEM
[] ELECTRICAL PERMIT ISSUED E
NOTE: MDE RECOMMENDS SEPTIC TANKS, BAT, AND OTHER PRETREATMENT UNITS BE PUMPED AT A FREQUENCY ADEQUATE TO ENSURE THAT SOLIDS ARE NOT DISCHARGED TO THE DISPOSAL AREA

NEITHER THE HOWARD COUNTY COUNCIL NOR THE HEALTH DEPARTMENT IS RESPONSIBLE FOR THE SUCCESSFUL OPERATION OF ANY SYSTEM.
PERMITTEE RESPONSIBLE FOR OBTAINING FINAL APPROVAL ON THIS PERMIT.
CALL 410-313-1771 TO SCHEDULE INSPECTIONS.

NOT TO SCALE

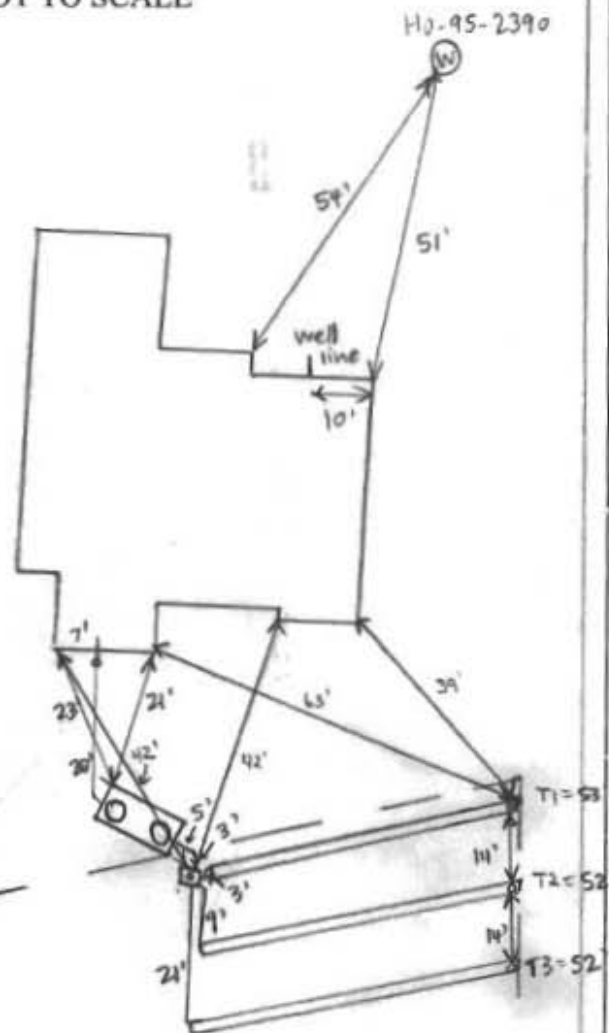

TRENCH/DRAINFIELD DATA

WIDTH	INLET	BOTTOM
3'	3'	8'
NUMBER OF TRENCHES		3
TOTAL LENGTH		157'
ABSORPTION AREA		471' + SIDEWALL
DISTRIBUTION BOX LEVEL		YES
DISTRIBUTION BOX BAFFLE		YES
DISTRIBUTION BOX PORT		YES

SEPTIC TANK DATA

SEPTIC TANK 1 LEVEL	YES
MANUFACTURER	Mayer Bros
CAPACITY	2000 GAL
SEAM LOC	TOP
TANK LID DEPTH	1 - 1.5'
BAFFLES	YES
BAFFLE FILTER	NO
MANHOLE LOC	FRONT + REAR
6" PORT LOC	NONE
WATERTIGHT TEST	NO
SLOTTED	YES
DATE ON LID	2-14-17

PUMP/SEPTIC TANK LEVEL

MANUFACTURER	
CAPACITY	GAL
SEAM LOC	
TANK LID DEPTH	
BAFFLES	
BAFFLE FILTER	
MANHOLE LOC	
6" PORT LOC	
WATERTIGHT TEST	
SLOTTED	
DATE ON LID	

PRE-CONSTRUCTION:

3/27/17 Met Fogle's on site for layout. SDA corner stakes present. Shot contour + laid out 2 x 52' trenches on contour; Fogle's will paint 3rd 52' trench after removing two trees at trench ends. Spoke with builder on site, okay to move tank closer to center upper edge of SDA. Marked 20' off house for tank placement. (S)

INSTALLATION:

3/29/17 site inspection contractor on site. Tank in place, one trench (T1) completed w/ spoil pile on top, T1 trench length @ 53'. Trench (T2) not completed yet, only 40' completed, measured trench depth @ 9'. Stone looks good, trees removed for Trench (T3) but not started yet. Contractor will cover outlet line of tank but leave dbox & trench ends uncovered for inspection. (S) 3/30/17 Trenches complete, T2 open at ends and T3 left open, 3' wide, 2.5' to stone. Levelled speed levelers in D-box. Pipe out of D-box leaking at connection - Fogle's patched with hydraulic cement while on site. (S)

FINAL INSPECTOR

Sarah Collins

DATE OF APPROVAL

3/30/17



Bureau of Environmental Health 000063
 8930 Stanford Boulevard, Columbia, MD 21045
 Main: 410-313-2640 | Fax: 410-313-2648
 TDD 410-313-2323 | Toll Free 1-866-313-6300
 www.hchealth.org
 Facebook: www.facebook.com/hocohealth
 Twitter: HowardCoHealthDep

Maura J. Rossman, M.D., Health Officer

**OPERATION AND MAINTENANCE AGREEMENT
 FOR AN ON-SITE SEWAGE DISPOSAL SYSTEM
 HAVING AN ADVANCED PRE-TREATMENT SYSTEM**

THIS AGREEMENT is made this 25 day of Sept, among DR Horton Inc
DR Horton Inc, hereinafter collectively referred to as
 "Owner", and the Howard County Health Department hereinafter referred to as the "County".

WHEREAS, Owner is the owner or contract owner of a parcel of land located at
2049 Drivers Lane, in the ___ Election District of Howard
 County, Maryland, and the deed to same is recorded or shall be recorded among the Land
 Records of Howard County, Maryland in Liber 14970 Folio 366.

WHEREAS, The Lot is suitable for the installation of a conventional on-site sewage disposal
 system with an advanced pre-treatment system, utilizing best available technology to perform
 nitrogen reduction, in accordance with the Code of Maryland Regulations 26.04.02.07, effective
 January 1, 2013. The pre-treatment device being installed is ~~Heat~~ SVR Norweco

NOW, THEREFORE, the parties hereto agree as follows:

21
40

- A. Owner hereby grants to the County the right to enter upon the Lot at any reasonable time for access to the system to make periodic inspections and the Owner agrees to provide any information and data in Owner's possession reasonably requested and needed by the County to develop accurate and thorough test results.
- B. Owner acknowledges and agrees that neither the County nor any of its agents or employees, either officially or individually, underwrites the operation of any system approved by them.
- C. The Owner will devote reasonable care and effort to the operation and maintenance of the system in perpetuity or until a public sewer connection is made so that a system malfunction is not the result of poor maintenance, faulty operation, or neglect.
- D. The Owner agrees to enter into a contract reasonably acceptable to the Owner and the County with a private entity to operate and maintain on a regularly scheduled basis an approved advanced pre-treatment system. The owner shall supply a copy of the contract to the County when it is renewed or altered.
- E. This agreement shall run with the land and upon Owner's taking title to the Lot shall bind the Owner, their heirs, successors, and assigns to the provisions of the agreement as long as the property is in existence and after installation of the system. Owner further agrees that they shall inform in writing any subsequent purchaser or lessee of the Lot that the system shall require

maintenance or other attention. Upon taking title to the Lot, the Owner agrees to cause this agreement to be recorded in the Land Records of Howard County and assure that it becomes part of the Deed for the subject property in order that prospective buyers may be aware of the special conditions affecting this property.

F. This agreement shall not be construed to limit any authority of the County to protect the public health, safety or comfort or to issue any other orders to take any other action which is now or may hereafter be within its authority.

G. This agreement may be voided at any time at the discretion of the County.


H. This agreement contains the entire agreement and understanding between the County and the Owner. There are no additional terms other than as contained in this agreement. This agreement may not be modified, except in writing signed by each of the parties or by their authorized representatives.

I. The laws of the State of Maryland govern the provisions of all transactions pursuant to this agreement.

J. Owner acknowledges and agrees that interior renovations to increase the number of bedrooms or an increase in living space shall not be permitted without approval from the County.

IN WITNESS WHEREOF, the parties have signed and sealed this agreement on the date indicated above.


Howard County Health Department

 9/25/14
Owner #1 Signature Date
DR Horton Inc.

Owner #1 Print Name

Buyer #1 Signature Date

Buyer #1 Print Name

Owner #2 Signature


Owner #2 Print Name

Buyer #2 Signature Date

Buyer #2 Print Name

LR - Agreement
Recording Fee 20.00
Grantor/Grantee Name:
D.R. HORTON INC.
Reference/Control #:
63
LR - Agreement
Surcharge 40.00
=====
SubTotal: 60.00
=====
Total: 240.00
09/26/2014 10:50
CC13-ES
2340310 CC0503 -
Howard Co
Columbia/CC05.03.08 -
Register 08

HOWARD COUNTY CIRCUIT COURT (Land Records) WAR 15799, p. 0473, MSA_CE53_15790, Date available 10/01/2014, Printed 08/10/2015.

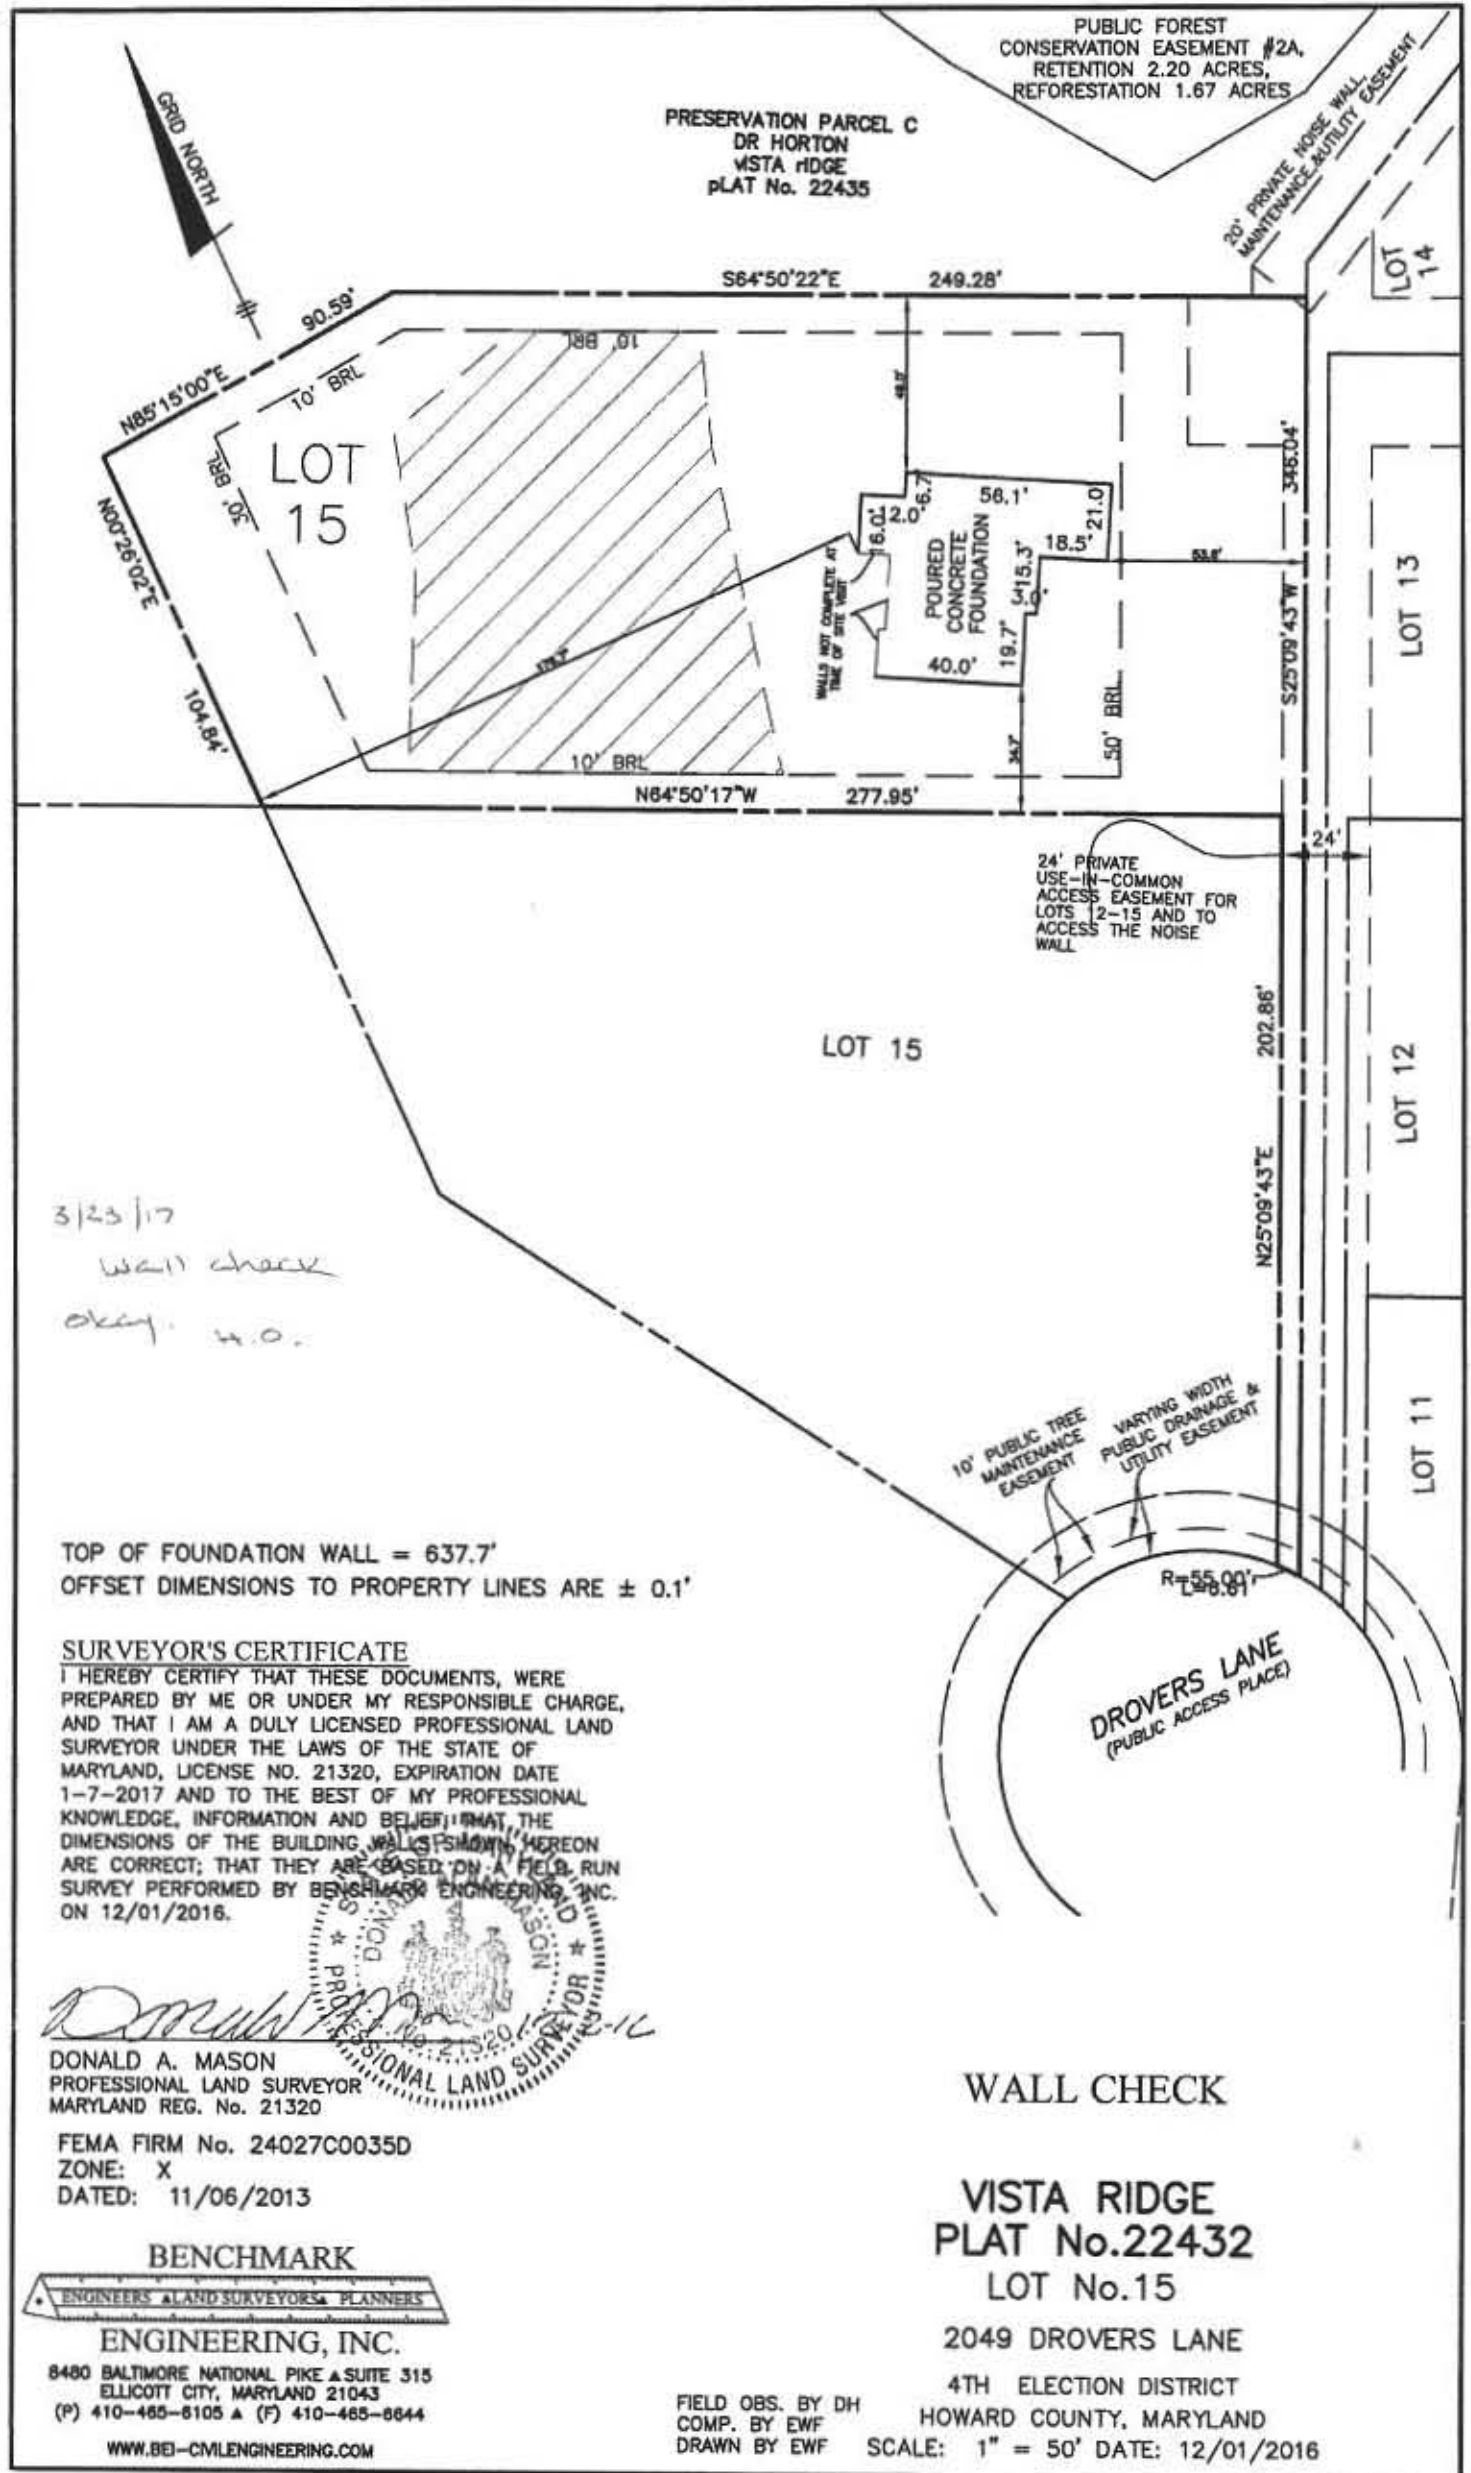

3/23/17
 wall check
 okay. n.o.

TOP OF FOUNDATION WALL = 637.7'
 OFFSET DIMENSIONS TO PROPERTY LINES ARE ± 0.1'

SURVEYOR'S CERTIFICATE
 I HEREBY CERTIFY THAT THESE DOCUMENTS, WERE PREPARED BY ME OR UNDER MY RESPONSIBLE CHARGE, AND THAT I AM A DULY LICENSED PROFESSIONAL LAND SURVEYOR UNDER THE LAWS OF THE STATE OF MARYLAND, LICENSE NO. 21320, EXPIRATION DATE 1-7-2017 AND TO THE BEST OF MY PROFESSIONAL KNOWLEDGE, INFORMATION AND BELIEF, THAT THE DIMENSIONS OF THE BUILDING WALLS SHOWN HEREON ARE CORRECT; THAT THEY ARE BASED ON A FIELD RUN SURVEY PERFORMED BY BENCHMARK ENGINEERING, INC. ON 12/01/2016.

Donald A. Mason
 DONALD A. MASON
 PROFESSIONAL LAND SURVEYOR
 MARYLAND REG. No. 21320

FEMA FIRM No. 24027C0035D
 ZONE: X
 DATED: 11/06/2013


BENCHMARK
 ENGINEERS & LAND SURVEYORS & PLANNERS
ENGINEERING, INC.
 8480 BALTIMORE NATIONAL PIKE, SUITE 315
 ELLICOTT CITY, MARYLAND 21043
 (P) 410-465-8105 A (F) 410-465-8644
 WWW.BEI-CMLENGINEERING.COM

WALL CHECK

VISTA RIDGE
 PLAT No. 22432
 LOT No. 15
 2049 DROVERS LANE


FIELD OBS. BY DH
 COMP. BY EWF
 DRAWN BY EWF
 SCALE: 1" = 50' DATE: 12/01/2016

4TH ELECTION DISTRICT
 HOWARD COUNTY, MARYLAND

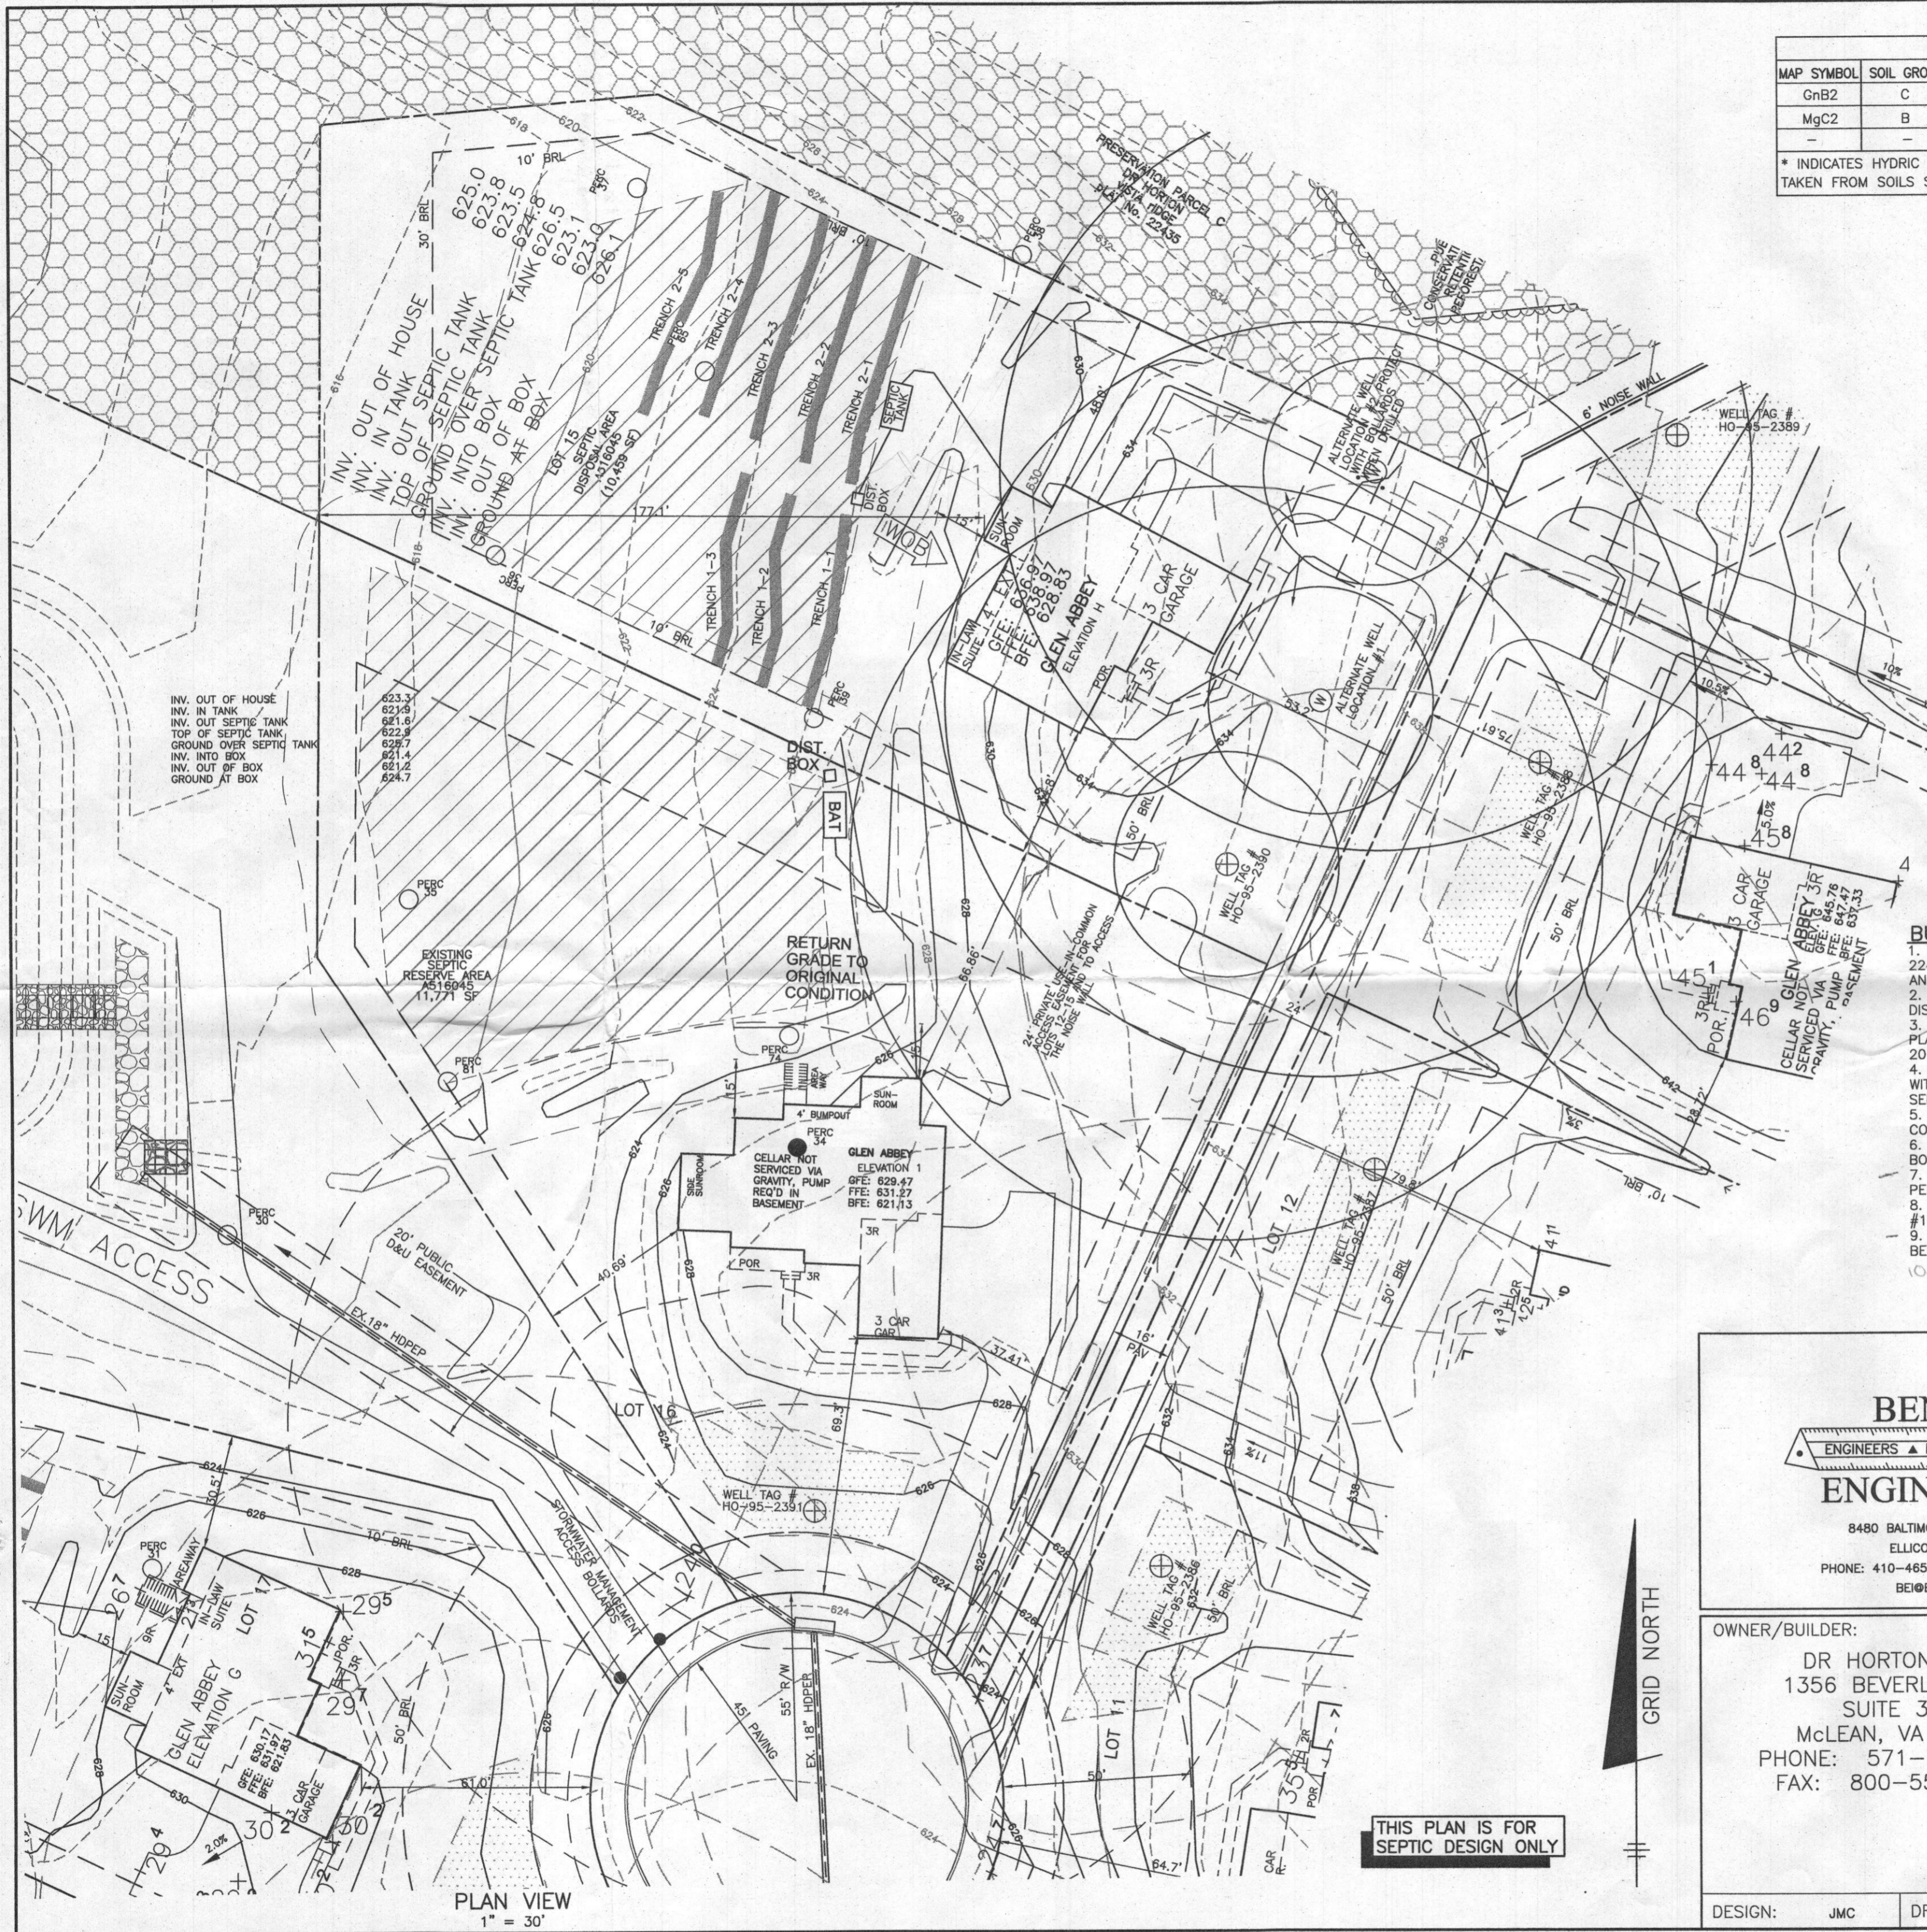


SOILS LEGEND		
MAP SYMBOL	SOIL GROUP	SOIL TYPE
GnB2	C	GLENVILLE, SILT LOAM, 3 TO 8 PERCENT SLOPES, MODERATELY ERODED
MgC2	B	MANOR GRAVELLY LOAM, 8 TO 15 PERCENT SLOPES, MODERATELY ERODED

* INDICATES HYDRIC SOILS
 TAKEN FROM SOILS SURVEY, ISSUED JULY 1968, MAP NO. 33

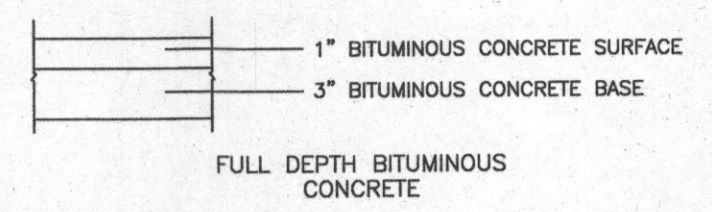

PAVING SECTION
 NOT TO SCALE

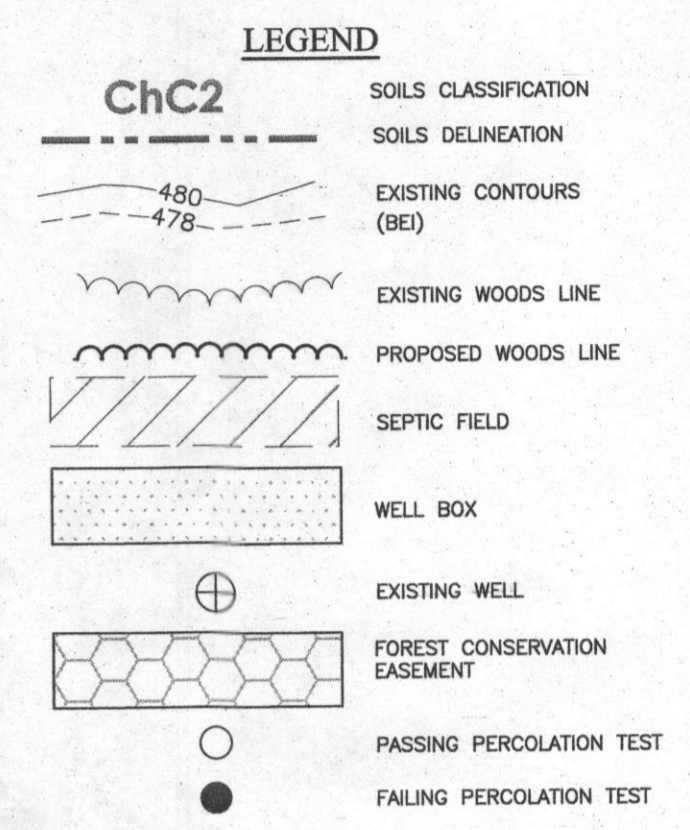

- BUILDING PERMIT PLAN NOTES:**
1. THE LOT SHOWN HEREON WAS RECORDED ON THE PLAT FOR VISTA RIDGE, PLAT No. 22430-22435. REFER TO THE PLATS FOR LOT DIMENSIONS, LOT AREAS, ALL EASEMENTS AND CONDITIONS.
 2. SEDIMENT AND EROSION CONTROLS WERE APPROVED BY HOWARD SOIL CONSERVATION DISTRICT UNDER A GRADING PLAN AND MODIFIED FOR THIS SPECIFIC HOUSE.
 3. TOPOGRAPHY SHOWN HEREON IS TAKEN FROM THE APPROVED ROAD CONSTRUCTION PLANS AND TOPOGRAPHIC INFORMATION PROVIDED BY ACCUBID, INC., ON OR ABOUT JUNE 27, 2013.
 4. ALL SEDIMENT AND EROSION CONTROL FEATURES USED ON THIS SITE SHALL COMPLY WITH THE 2011 MARYLAND STANDARDS AND SPECIFICATIONS FOR SOIL EROSION AND SEDIMENT CONTROL.
 5. ALL DRAINAGE AND STORMWATER MANAGEMENT FEATURES USED ON THIS SITE MUST COMPLY WITH THE APPROVED ROAD CONSTRUCTION PLANS EXCEPT AS WAIVED.
 6. THERE ARE NO EXISTING WELLS OR SEPTIC SYSTEMS WITHIN 100' OF THIS PROJECT'S BOUNDARY EXCEPT AS NOTED.
 7. ANY CHANGES TO A PRIVATE SEWAGE EASEMENT OR WELL BOX SHALL REQUIRE A REVISED PERCOLATION CERTIFICATION PLAN.
 8. STORMWATER MANAGEMENT FOR THIS LOT WAS DESIGNED TO BE PROVIDED BY BOTH POND #1, A POCKET POND, AND IN POND #2, A MICROPOND ED POND.
 9. THE EXISTING WELL SHOWN ON THIS PLAN, HO-95-2390, HAS BEEN FIELD LOCATED BY BENCHMARK ENGINEERING, INC., AND IS ACCURATELY SHOWN.
 10. The maximum earth cover over the tank is 3 feet. Greater earth cover will require a heavy load bearing tank.

BENCHMARK
 ENGINEERS ▲ LAND SURVEYORS ▲ PLANNERS
ENGINEERING, INC.

8480 BALTIMORE NATIONAL PIKE ▲ SUITE 315
 ELLICOTT CITY, MARYLAND 21043
 PHONE: 410-485-6105 ▲ FAX: 410-485-6644
 BEI@BEI-CIVILENGINEERING.COM


Professional Certification. I hereby certify that these documents were prepared or approved by me, and that I am a duly licensed professional engineer under the laws of the State of Maryland, License No. 45577, Expiration Date: 06-08-2018.

3/7/17

OWNER/BUILDER: DR HORTON, INC. 1356 BEVERLY ROAD SUITE 300 McLEAN, VA 22101 PHONE: 571-723-0813 FAX: 800-551-5015	PROJECT: VISTA RIDGE LOT 15
LOCATION: 2049 DROVERS LANE COOKSVILLE, MD 21723 TAX MAP No. 8 - BLOCK No. 23 - PARCEL No. 176 4TH ELECTION DISTRICT, HOWARD COUNTY, MARYLAND TAX ID NUMBER 04-595480	TITLE: SEPTIC SITE PLAN
HOUSE TYPE: GLEN ABBEY	DATE: MARCH, 2017
DESIGN: JMC	DRAFT: JMC
SCALE: 1" = 30'	PROJECT NO. 1635 DRAWING 1 OF 2

**THIS PLAN IS FOR
 SEPTIC DESIGN ONLY**

PLAN VIEW
 1" = 30'

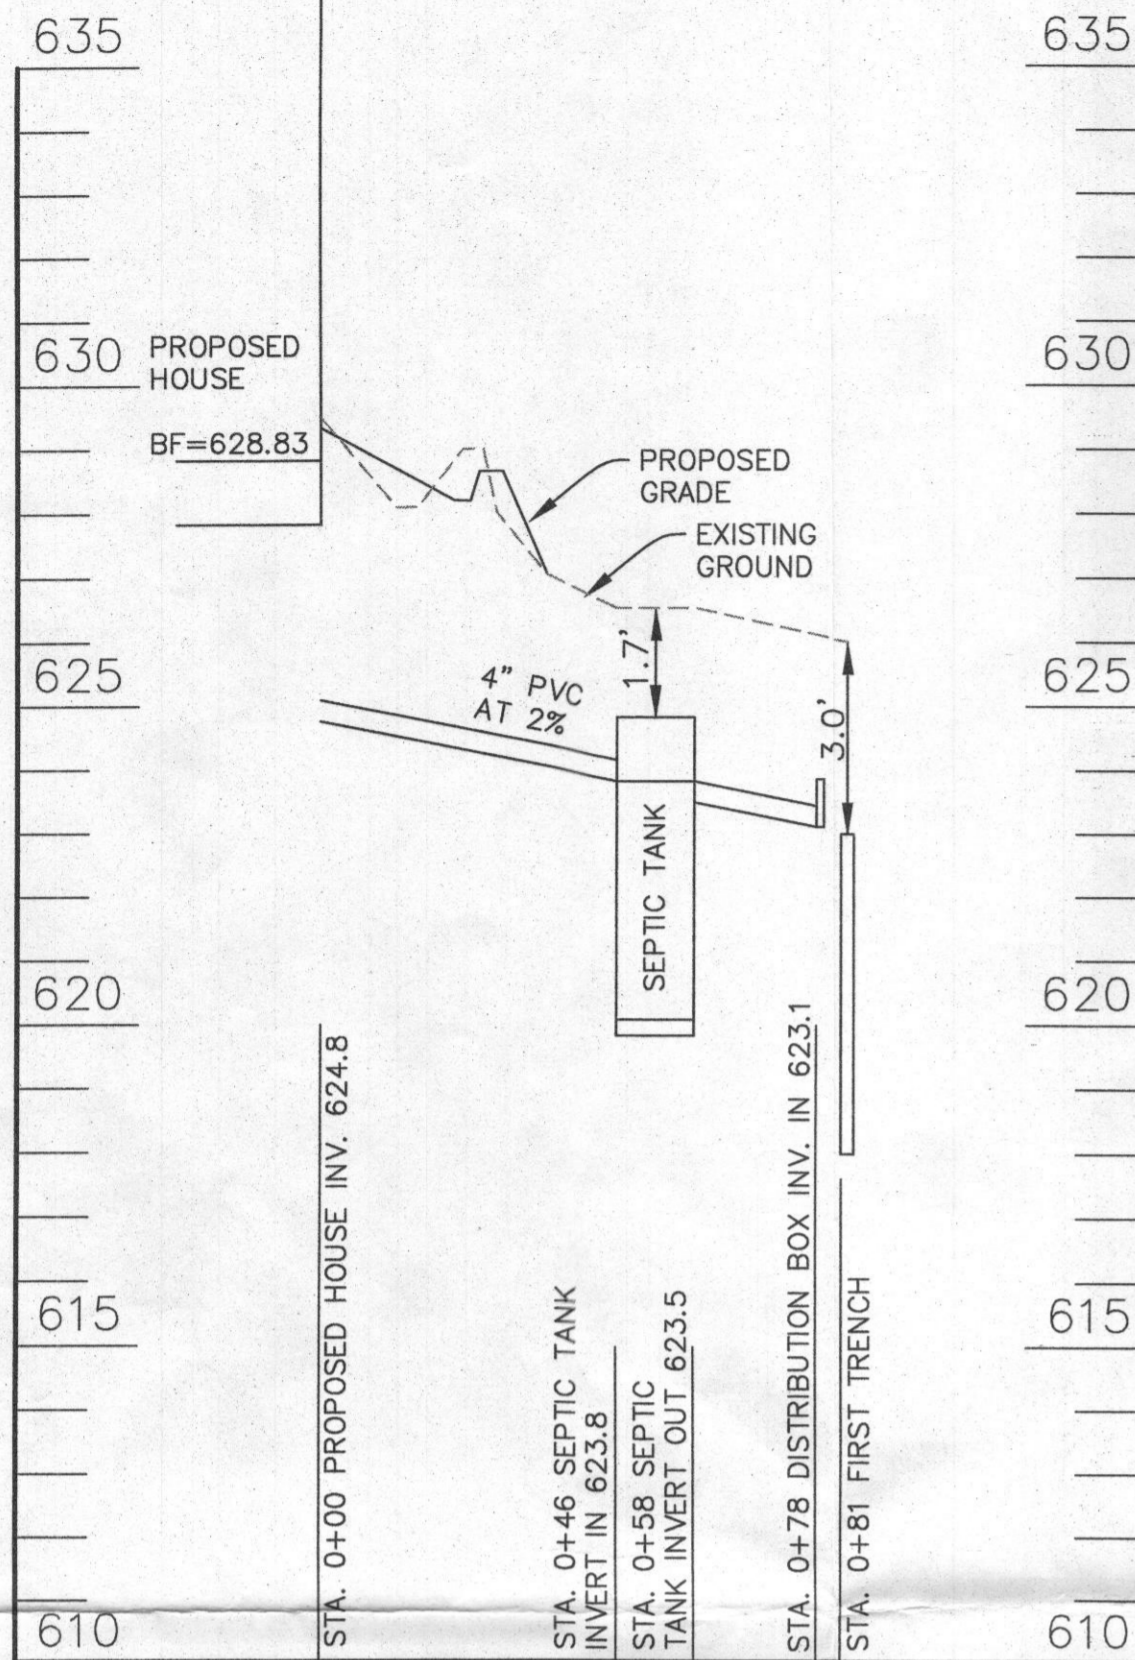

SEWER PROFILE - LOT 15
SCALE: VERTICAL 1"=3', HORIZONTAL 1"=30'

TRENCH INFORMATION

TRENCH	LENGTH	GROUND ELEVATION	INVERT ELEVATION	MAX. BOTTOM ELEV.
TRENCH 1-1	52 LF	625.9	622.9	617.9
TRENCH 1-2	52 LF	624.8	621.8	618.8
TRENCH 1-3	52 LF	623.9	620.9	615.9
TRENCH 2-1	62.6 LF	625.9	622.9	617.9
TRENCH 2-2	62.6 LF	625.0	622.0	617.0
TRENCH 2-3	62.6 LF	623.9	620.9	615.9
TRENCH 2-4	62.6 LF	622.6	619.6	614.6
TRENCH 2-5	62.6 LF	621.4	618.4	613.4

INITIAL SYSTEM	
Number of Bedrooms	6
Application Rate	1.2 gpd/sf
Effective Area Beginning Depth	6 ft
Bottom Max Depth	8 ft
Design Flow	900 gpd
Drainage Field square footage	750 sf
Sidewall reduction credit	0.625
Trench width	3
Effective Area Depth	2
Linear Length of trench Required	156 lf

1st REPLACEMENT SYSTEM	
Number of Bedrooms	6
Application Rate	0.8 gpd/sf
Effective Area Beginning Depth	7 ft
Bottom Max Depth	8 ft
Design Flow	900 gpd
Drainage Field square footage	1125 sf
Sidewall reduction credit	0.83
Trench width	3
Effective Area Depth	1
Linear Length of trench Required	313 lf

SEE MANUFACTURER SPECIFICATIONS FOR DETAILS.
WWW.MAYERPRECAST.COM
EQUIVALENT FROM OTHER MANUFACTURERS CAN BE SUBSTITUTED.


DESIGN DATA & GENERAL NOTES

- Concrete strength $f'_c=4,000$ p.s.i. @ 28 days. Density = 150 pcf.
- Cement - Portland Type III per ASTM C 150-92.
- Admixtures & plasticizers per ASTM C 260-86 & C 494-82.
- Reinforcing per ASTM A195. Min. 1-1/2" cover.
- Top slab sealed with butyl rope mastic.
- 4" wall, 4" base, & 6" top thickness.
- Max 3" of cover
- Depending on use of tank, Inlet & Outlet baffle may be required by code.

Mayer Bros., Inc.
6264 Race Road
Elkridge, Maryland 21075
Tel. 410.796.1434
Fax. 410.796.1438
www.mayerbrosprecast.com

**2,000 GALLON SEPTIC TANK
2-Compartment**
Stock Item [Approx. 19,900 lbs]

Dwg. No. 2000-2C No Scale Aug 11, 2008

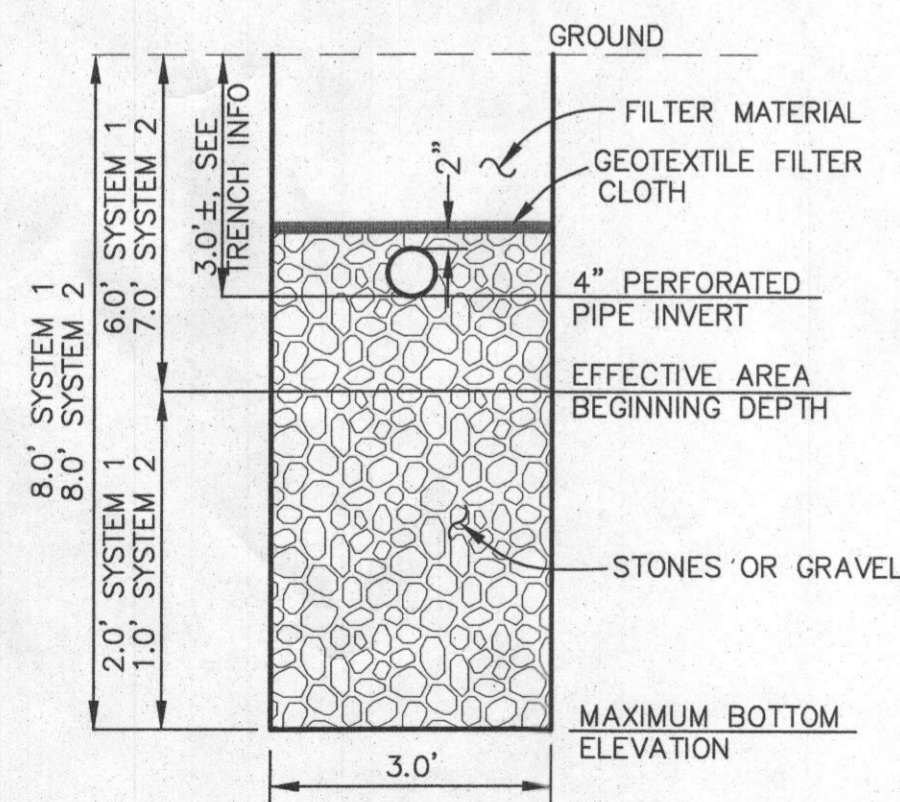

TYPICAL TRENCH DETAIL
NOT TO SCALE


Approved Septic System Plan
Howard County Health Department
Robert Aguirre 3/17/17
Signature Date

BENCHMARK ENGINEERING, INC.
ENGINEERS ▲ LAND SURVEYORS ▲ PLANNERS
8480 BALTIMORE NATIONAL PIKE ▲ SUITE 315
ELLCOTT CITY, MARYLAND 21043
PHONE: 410-465-6105 ▲ FAX: 410-465-6644
BEI@BEI-CIVLENGINEERING.COM

Professional Certification. I hereby certify that these documents were prepared or approved by me, and that I am a duly licensed professional engineer under the laws of the State of Maryland, License No. 45577, Expiration Date: 06-08-2018.


John M. Carline
STATE OF MARYLAND
No. 45577
PROFESSIONAL ENGINEER

OWNER/BUILDER: DR HORTON, INC. 1356 BEVERLY ROAD SUITE 300 McLEAN, VA 22101 PHONE: 571-723-0813 FAX: 800-551-5015	PROJECT: VISTA RIDGE LOT 15
LOCATION: 2049 DROVERS LANE COOKSVILLE, MD 21723 TAX MAP No. 8 - BLOCK No. 23 - PARCEL No. 176 4TH ELECTION DISTRICT, HOWARD COUNTY, MARYLAND TAX ID NUMBER 04-595480	TITLE: SEPTIC SITE PLAN
HOUSE TYPE: GLEN ABBEY	DATE: MARCH, 2017 PROJECT NO. 1635
DESIGN: JMC DRAFT: JMC	SCALE: 1" = 30' DRAWING 2 OF 2

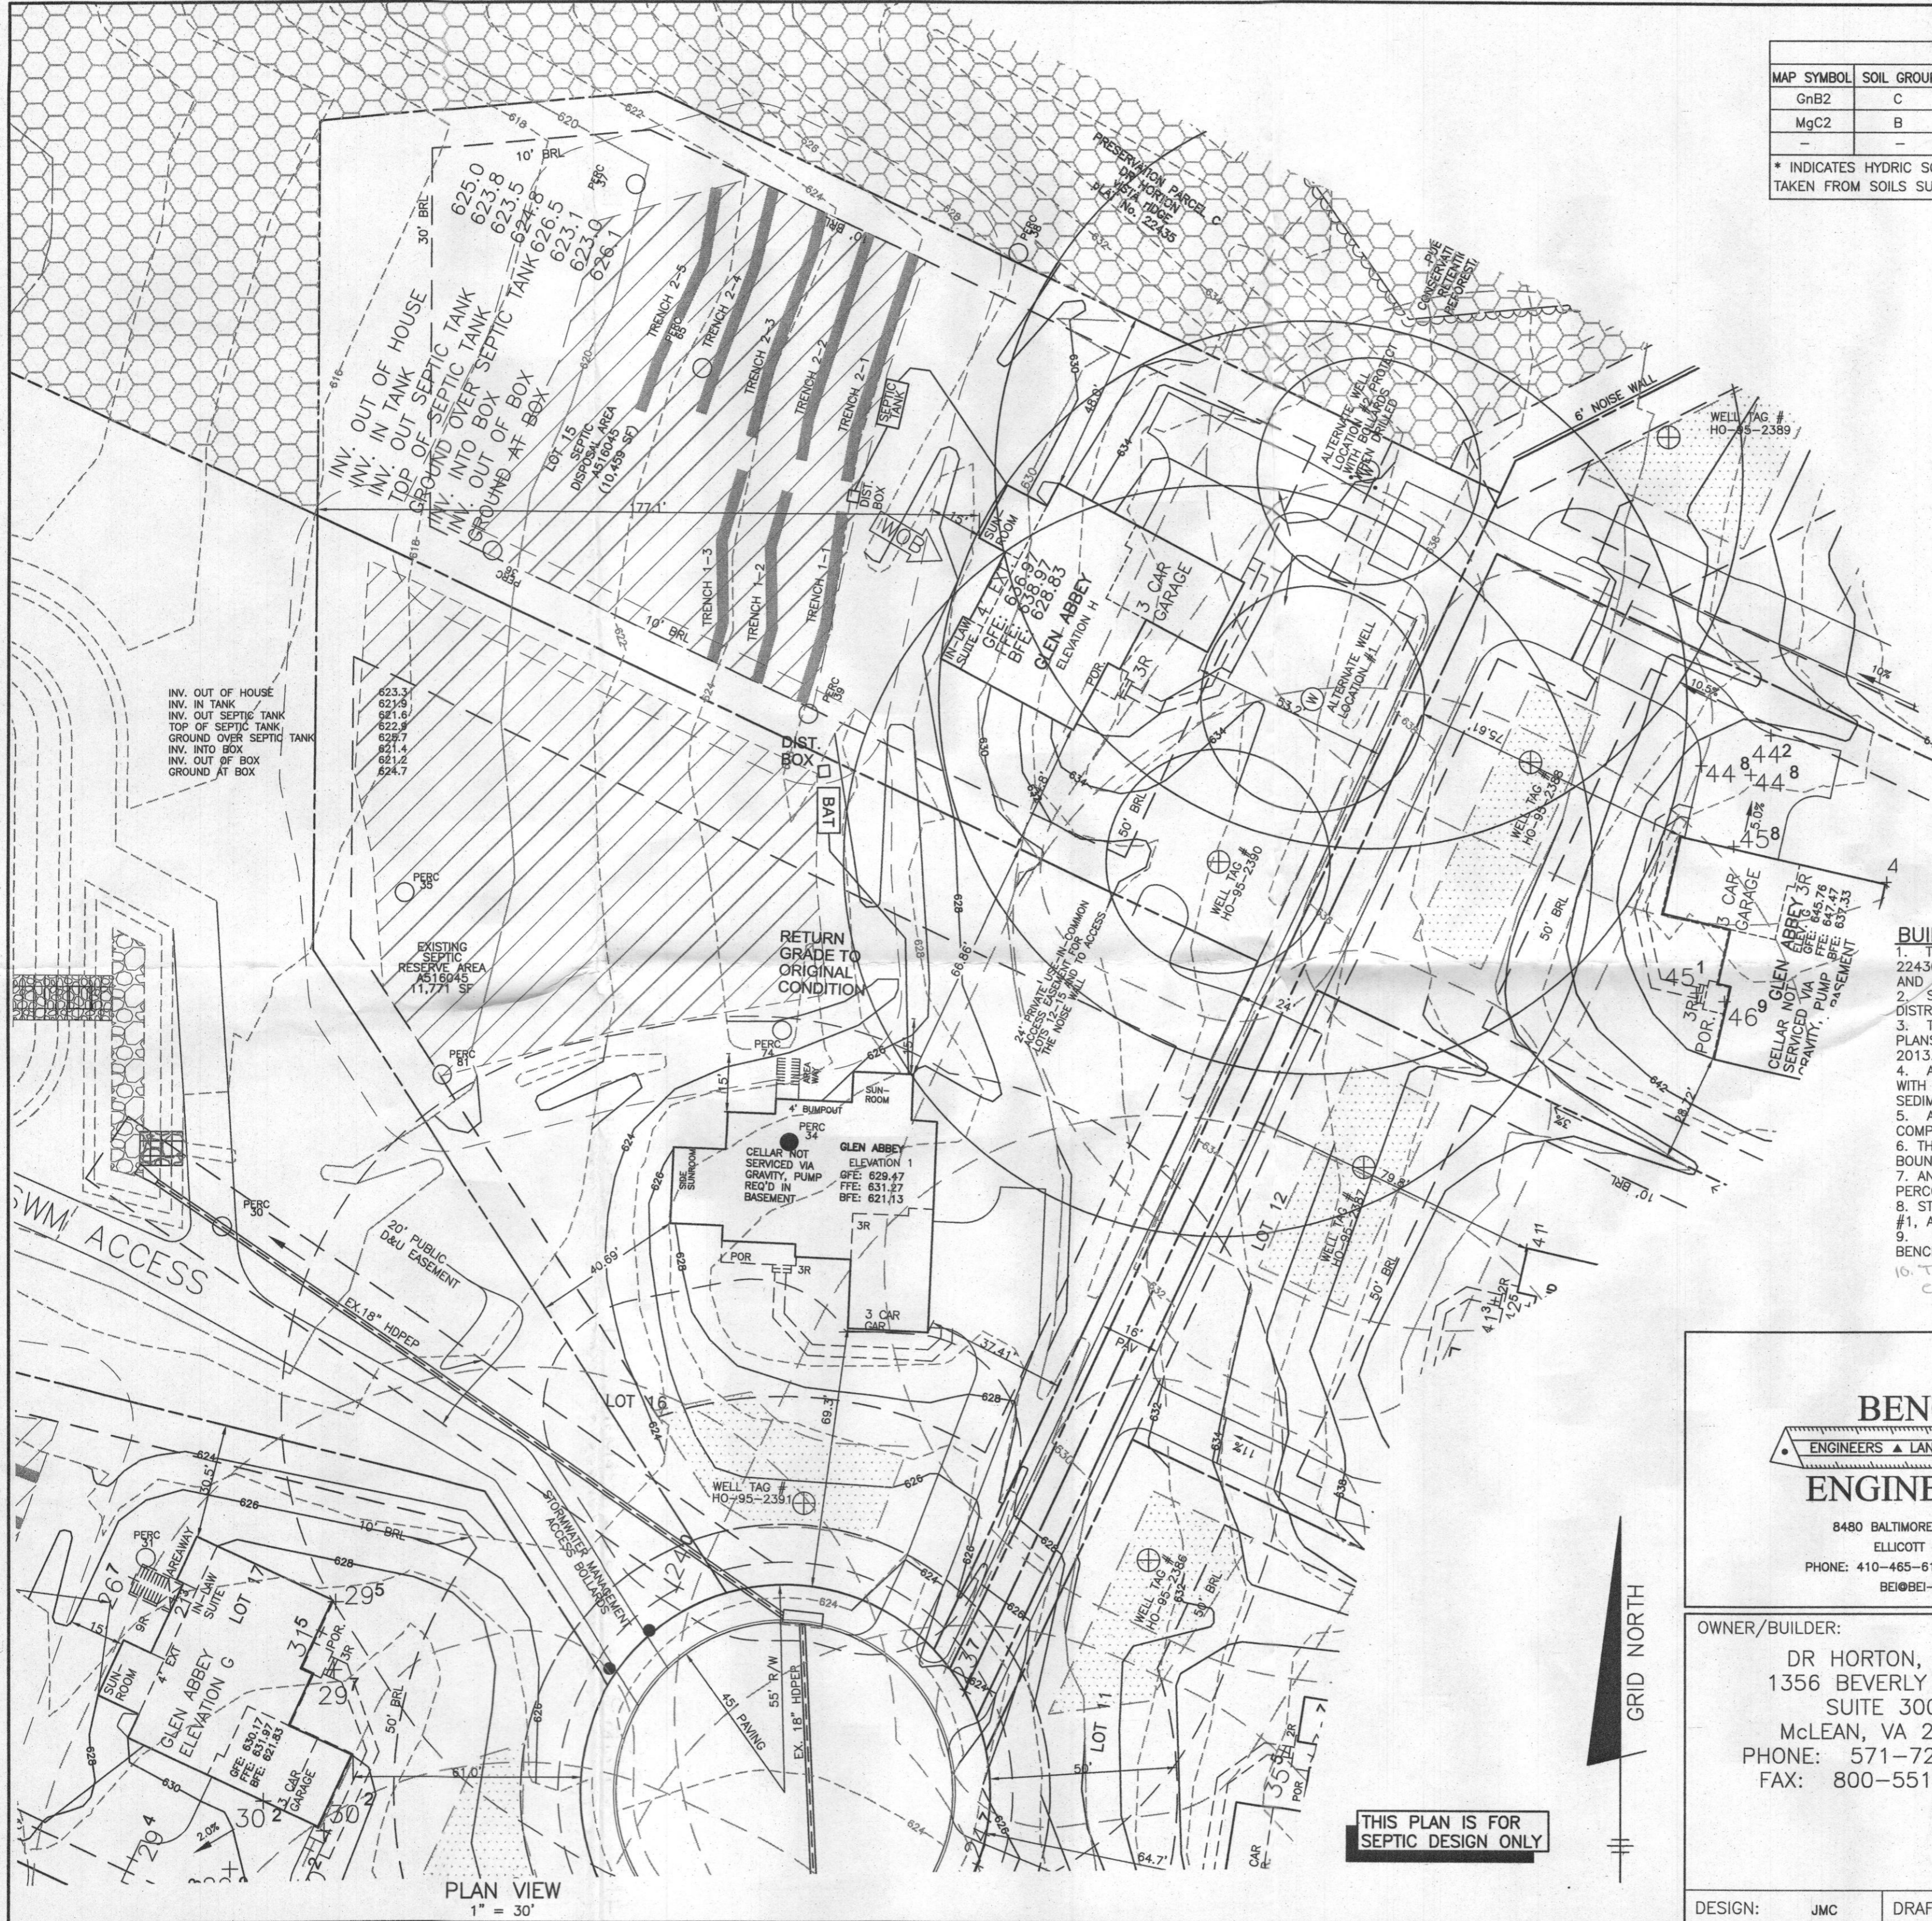


SOILS LEGEND		
MAP SYMBOL	SOIL GROUP	SOIL TYPE
GnB2	C	GLENVILLE, SILT LOAM, 3 TO 8 PERCENT SLOPES, MODERATELY ERODED
MgC2	B	MANOR GRAVELLY LOAM, 8 TO 15 PERCENT SLOPES, MODERATELY ERODED
-	-	-

* INDICATES HYDRIC SOILS
TAKEN FROM SOILS SURVEY, ISSUED JULY 1968, MAP NO. 33

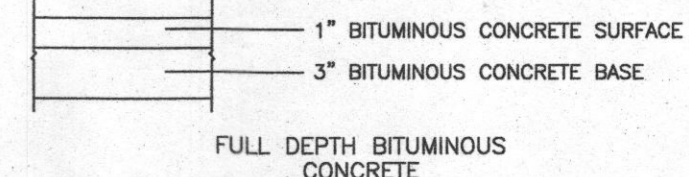

PAVING SECTION
NOT TO SCALE

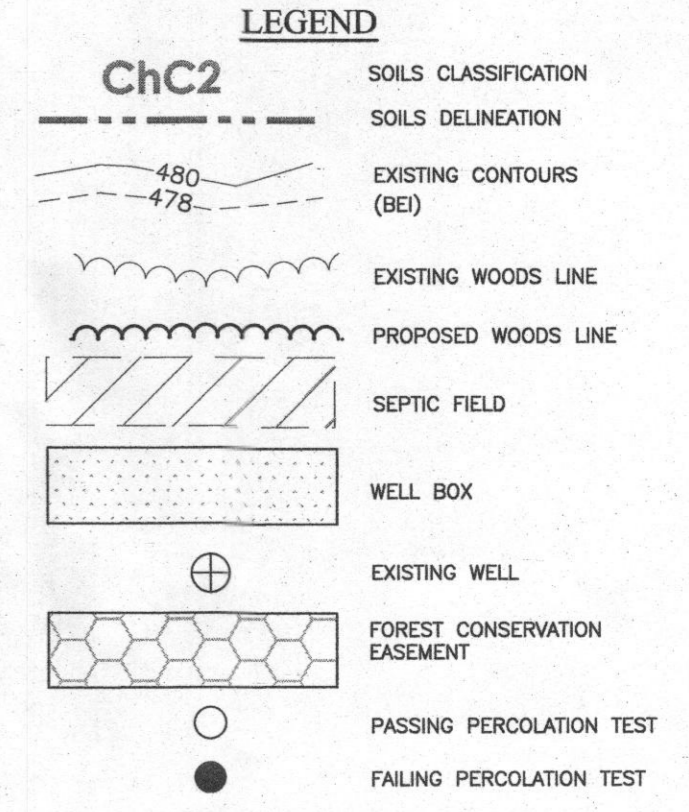

- BUILDING PERMIT PLAN NOTES:**
- THE LOT SHOWN HEREON WAS RECORDED ON THE PLAT FOR VISTA RIDGE, PLAT Nos. 22430-22435. REFER TO THE PLATS FOR LOT DIMENSIONS, LOT AREAS, ALL EASEMENTS AND CONDITIONS.
 - SEDIMENT AND EROSION CONTROLS WERE APPROVED BY HOWARD SOIL CONSERVATION DISTRICT UNDER A GRADING PLAN AND MODIFIED FOR THIS SPECIFIC HOUSE.
 - TOPOGRAPHY SHOWN HEREON IS TAKEN FROM THE APPROVED ROAD CONSTRUCTION PLANS AND TOPOGRAPHIC INFORMATION PROVIDED BY ACCUBID, INC., ON OR ABOUT JUNE 27, 2013.
 - ALL SEDIMENT AND EROSION CONTROL FEATURES USED ON THIS SITE SHALL COMPLY WITH THE 2011 MARYLAND STANDARDS AND SPECIFICATIONS FOR SOIL EROSION AND SEDIMENT CONTROL.
 - ALL DRAINAGE AND STORMWATER MANAGEMENT FEATURES USED ON THIS SITE MUST COMPLY WITH THE APPROVED ROAD CONSTRUCTION PLANS EXCEPT AS WAIVED.
 - THERE ARE NO EXISTING WELLS OR SEPTIC SYSTEMS WITHIN 100' OF THIS PROJECT'S BOUNDARY EXCEPT AS NOTED.
 - ANY CHANGES TO A PRIVATE SEWAGE EASEMENT OR WELL BOX SHALL REQUIRE A REVISED PERCOLATION CERTIFICATION PLAN.
 - STORMWATER MANAGEMENT FOR THIS LOT WAS DESIGNED TO BE PROVIDED BY BOTH POND #1, A POCKET POND, AND IN POND #2, A MICROPOL ED POND.
 - THE EXISTING WELL SHOWN ON THIS PLAN, HO-95-2390, HAS BEEN FIELD LOCATED BY BENCHMARK ENGINEERING, INC., AND IS ACCURATELY SHOWN.
 - The maximum earth cover over the tank is 3 feet. Greater earth cover will require a heavy load bearing tank.

BENCHMARK
ENGINEERS ▲ LAND SURVEYORS ▲ PLANNERS
ENGINEERING, INC.

8480 BALTIMORE NATIONAL PIKE ▲ SUITE 315
ELLCOTT CITY, MARYLAND 21043
PHONE: 410-465-6105 ▲ FAX: 410-465-6644
BEI@BEI-CVLENGINEERING.COM

Professional Certification. I hereby certify that these documents were prepared or approved by me, and that I am a duly licensed professional engineer under the laws of the State of Maryland, License No. 45577, Expiration Date: 06-08-2018.


3/7/17

OWNER/BUILDER: DR HORTON, INC. 1356 BEVERLY ROAD SUITE 300 MCLEAN, VA 22101 PHONE: 571-723-0813 FAX: 800-551-5015	PROJECT: VISTA RIDGE LOT 15
	LOCATION: 2049 DROVERS LANE COOKSVILLE, MD 21723 TAX MAP No. 8 - BLOCK No. 23 - PARCEL No. 176 4TH ELECTION DISTRICT, HOWARD COUNTY, MARYLAND TAX ID NUMBER 04-595480
TITLE: SEPTIC SITE PLAN	HOUSE TYPE: GLEN ABBEY
DATE: MARCH, 2017	PROJECT NO. 1635
DESIGN: JMC	DRAFT: JMC
SCALE: 1" = 30'	DRAWING 1 OF 2

THIS PLAN IS FOR SEPTIC DESIGN ONLY

GRID NORTH

PLAN VIEW
1" = 30'

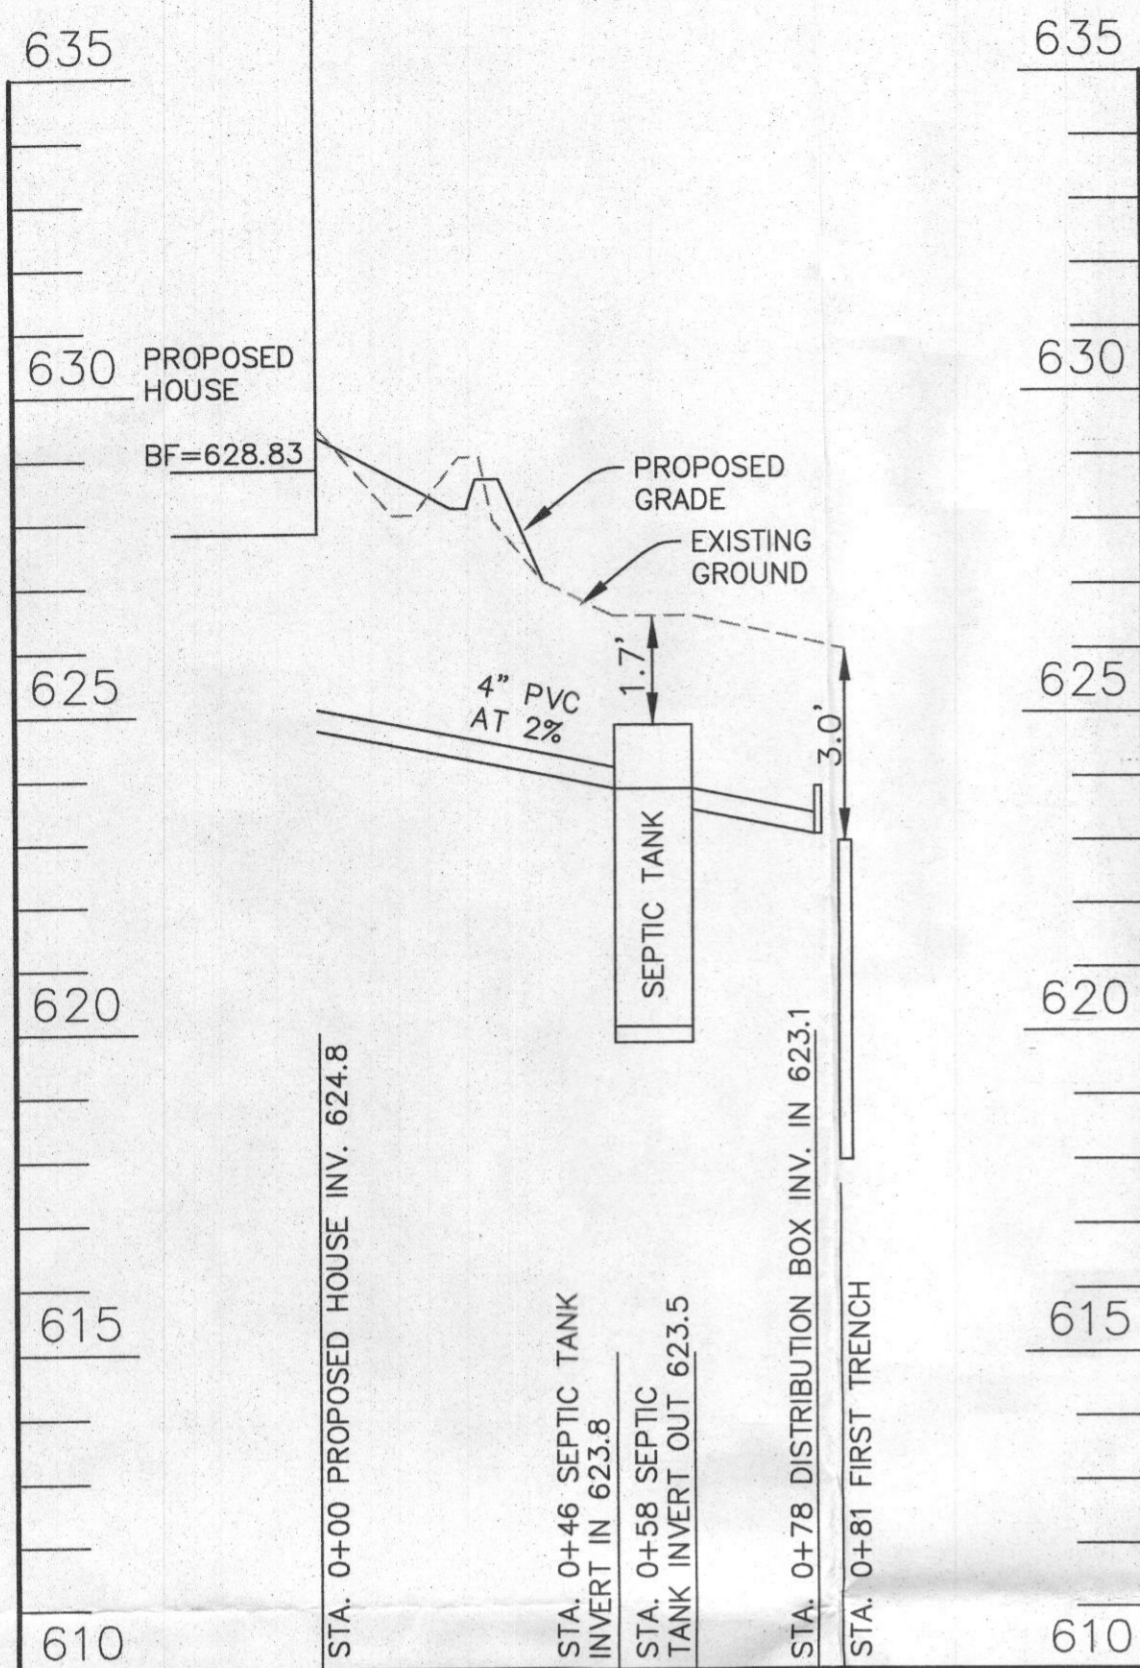

SEWER PROFILE - LOT 15
SCALE: VERTICAL 1"=3', HORIZONTAL 1"=30'

TRENCH INFORMATION

TRENCH	LENGTH (LF)	GROUND ELEVATION	INVERT ELEVATION	MAX. BOTTOM ELEV.
TRENCH 1-1	52	625.9	622.9	617.9
TRENCH 1-2	52	624.8	621.8	618.8
TRENCH 1-3	52	623.9	620.9	615.9
TRENCH 2-1	62.6	625.9	622.9	617.9
TRENCH 2-2	62.6	625.0	622.0	617.0
TRENCH 2-3	62.6	623.9	620.9	615.9
TRENCH 2-4	62.6	622.6	619.6	614.6
TRENCH 2-5	62.6	621.4	618.4	613.4

INITIAL SYSTEM		
Number of Bedrooms	6	
Application Rate	1.2	gpd/sf
Effective Area Beginning Depth	6	ft
Bottom Max Depth	8	ft
Design Flow	900	gpd
Drainage Field square footage	750	sf
Sidewall reduction credit	0.625	
Trench width	3	
Effective Area Depth	2	
Linear Length of trench Required	156	lf

1st REPLACEMENT SYSTEM		
Number of Bedrooms	6	
Application Rate	0.8	gpd/sf
Effective Area Beginning Depth	7	ft
Bottom Max Depth	8	ft
Design Flow	900	gpd
Drainage Field square footage	1125	sf
Sidewall reduction credit	0.83	
Trench width	3	
Effective Area Depth	1	
Linear Length of trench Required	313	lf


SEE MANUFACTURERS SPECIFICATIONS FOR DETAILS.
WWW.MAYERPRECAST.COM
EQUIVALENT FROM OTHER MANUFACTURERS CAN BE SUBSTITUTED.

DESIGN DATA & GENERAL NOTES

- [1] Concrete strength $f_c=4,000$ p.s.i. @ 28 days. Density = 150 pcf.
- [2] Cement - Portland Type III per ASTM C 150-92.
- [3] Admixtures & plasticizers per ASTM C 260-98 & C 494-92.
- [4] Reinforcing per ASTM A 185. Min. 1-1/2" cover.
- [5] Top slab sealed with butyl rope mastic.
- [6] 4" wall, 4" base, & 6" top thickness.
- [7] Max 3" of cover
- [8] Depending on use of tank, Inlet & Outlet baffle may be required by code.

Mayer Bros, Inc.
6264 Race Road, Elkridge, Maryland 21075
Tel. 410.796.1434, Fax. 410.796.1438
www.mayerbrosprecast.com

2,000 GALLON SEPTIC TANK 2-Compartment
Stock Item [Approx. 19,900 lbs]
Dwg. No. 2000-2C, No Scale, Aug 11, 2008

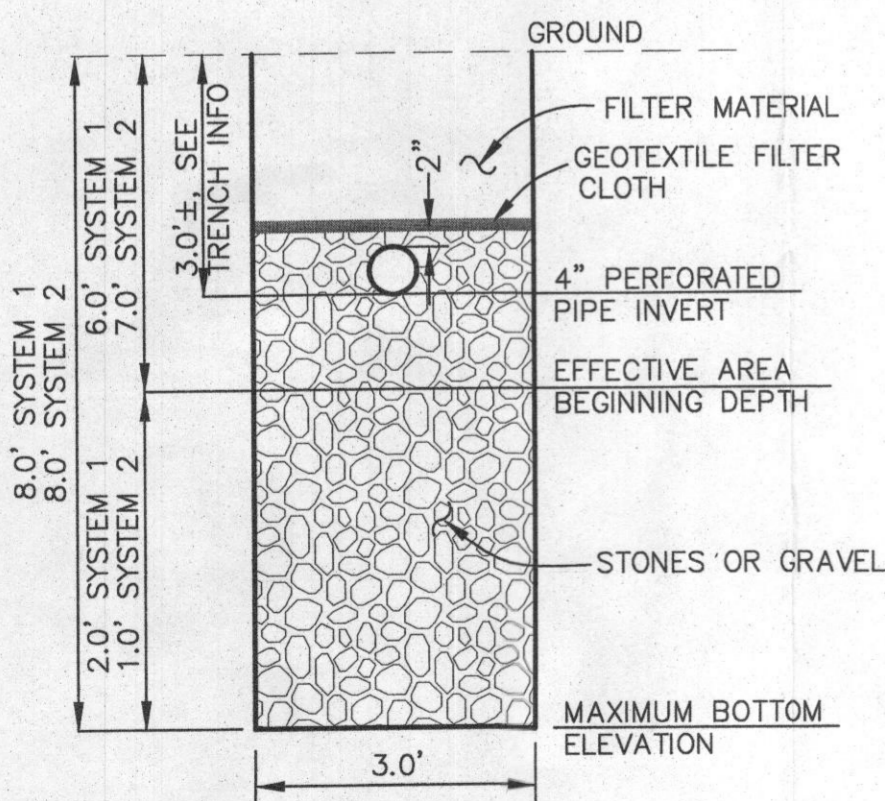

TYPICAL TRENCH DETAIL
NOT TO SCALE

Approved Septic System Plan
Howard County Health Department
Robert [Signature] 3/7/17
Signature Date

BENCHMARK ENGINEERING, INC.
ENGINEERS ▲ LAND SURVEYORS ▲ PLANNERS
8480 BALTIMORE NATIONAL PIKE ▲ SUITE 315
ELLCOTT CITY, MARYLAND 21043
PHONE: 410-465-6105 ▲ FAX: 410-465-6644
BEI@BEI-CVILENGINEERING.COM

Professional Certification. I hereby certify that these documents were prepared or approved by me, and that I am a duly licensed professional engineer under the laws of the State of Maryland, License No. 45577, Expiration Date: 06-08-2018.

JOHN M. CARNIEL
No. 45577
PROFESSIONAL ENGINEER

3/7/17

OWNER/BUILDER: DR HORTON, INC. 1356 BEVERLY ROAD SUITE 300 MCLEAN, VA 22101 PHONE: 571-723-0813 FAX: 800-551-5015	PROJECT: VISTA RIDGE LOT 15
LOCATION: 2049 DROVERS LANE COOKSVILLE, MD 21723 TAX MAP No. 8 - BLOCK No. 23 - PARCEL No. 176 4TH ELECTION DISTRICT, HOWARD COUNTY, MARYLAND TAX ID NUMBER 04-595480	TITLE: SEPTIC SITE PLAN
HOUSE TYPE: GLEN ABBEY	DATE: MARCH, 2017
DESIGN: JMC	DRAFT: JMC
SCALE: 1" = 30'	PROJECT NO. 1635 DRAWING 2 OF 2