

Bureau of Environmental Health
 8930 Stanford Boulevard, Columbia, MD 21045
 Main: 410-313-2640 | Fax: 410-313-2648
 TDD 410-313-2323 | Toll Free 1-866-313-6300
www.hchealth.org
 Facebook: www.facebook.com/hocohealth

Maura J. Rossman, M.D., Health Officer

RECEIPT DATE: 9/6/17 **ONSITE SEWAGE DISPOSAL SYSTEM** P 561513
 APPROVAL DATE: 1/22/2018 **PERMIT: CONSTRUCTION** A _____
 PROPERTY ADDRESS: 12240 Pleasant Springs Court
 SUBDIVISION: Regan Property LOT: 20 TAX ID: _____
 CONTRACTOR: Hatfield's Equipment EMAIL: ken@hatfieldsequipment.com
 CONTRACTOR ADDRESS: P.O. Box 519 Annapolis Junction, MD 20701 PHONE: 301-490-4289
 PROPERTY OWNER: MB Highland Reserve EMAIL: _____
 OWNER ADDRESS: 1686 E. Gude Drive, Rockville, MD 20850 PHONE: 410-301-762-9511
 SEPTIC TANK SIZE (GALLONS): 2000 TANK MANUFACTURER: Mayer Bros or equivalent
 PUMP MODEL: Zoeller 151 or equiv PUMP SIZE 1/3 PUMP TANK CAPACITY: 2000


DISTRIBUTION SYSTEM: GRAVITY PRESSURE DOSED BEDROOMS: 5 APPLICATION RATE: 1.2

TRENCHES:	LINEAR FEET REQUIRED: <u>100</u>	INLET DEPTH: <u>3</u>
	TRENCH WIDTH: <u>2</u>	MAXIMUM BOTTOM DEPTH: <u>8</u>
	MINIMUM SPACE BETWEEN TRENCHES: <u>11</u>	EFFECTIVE AREA BEGINNING DEPTH: <u>3</u>
LOCATION:	PER APPROVED SITE PLAN. SEWAGE DISPOSAL AREA AND TANK LOCATIONS MUST BE STAKED BY LICENSED SURVEYOR PRIOR TO PRE-CONSTRUCTION INSPECTION.	
NOTES:	Install 2x50' trenches in sw corner of SDA. Run F.M. on outer edge of SDA. Keep tanks out of 100' well ARC. 3x34'	

ISSUED BY: Kevin Wolf ISSUE DATE: 9/6/17 EXPIRATION DATE: 9/6/18

- NOTE: CONTRACTOR MUST SCHEDULE A PRE-CONSTRUCTION INSPECTION PRIOR TO BEGINNING ANY INSTALLATION
- NOTE: CONTRACTOR MUST SCHEDULE AN INSPECTION AND GAIN APPROVAL OF ALL COMPONENTS PRIOR TO COVERING
- NOTE: STONE MUST BE APPROVED BY HEALTH DEPARTMENT AND GRAVEL TICKET MUST BE AVAILABLE FOR REVIEW.
- NOTE: WATERTIGHT TANKS REQUIRED
- NOTE: ALL PARTS OF SEPTIC SYSTEM SHALL BE AT LEAST 100 FEET DOWNGRADIENT FROM ANY WATER WELL
- NOTE: MANHOLE RISERS REQUIRED ON ALL SEPTIC TANKS AND PUMP CHAMBERS
- NOTE: **AN ELECTRICAL PERMIT IS REQUIRED FOR INSTALLATION OF ANY ELECTRICAL COMPONENTS OF THE SYSTEM**
 ELECTRICAL PERMIT ISSUED E _____
- NOTE: MDE RECOMMENDS SEPTIC TANKS, BAT, AND OTHER PRETREATMENT UNITS BE PUMPED AT A FREQUENCY ADEQUATE TO ENSURE THAT SOLIDS ARE NOT DISCHARGED TO THE DISPOSAL AREA

**NEITHER THE HOWARD COUNTY COUNCIL NOR THE HEALTH DEPARTMENT IS RESPONSIBLE FOR THE SUCCESSFUL OPERATION OF ANY SYSTEM.
 PERMITTEE RESPONSIBLE FOR OBTAINING FINAL APPROVAL ON THIS PERMIT.
 CALL 410-313-1771 TO SCHEDULE INSPECTIONS.**

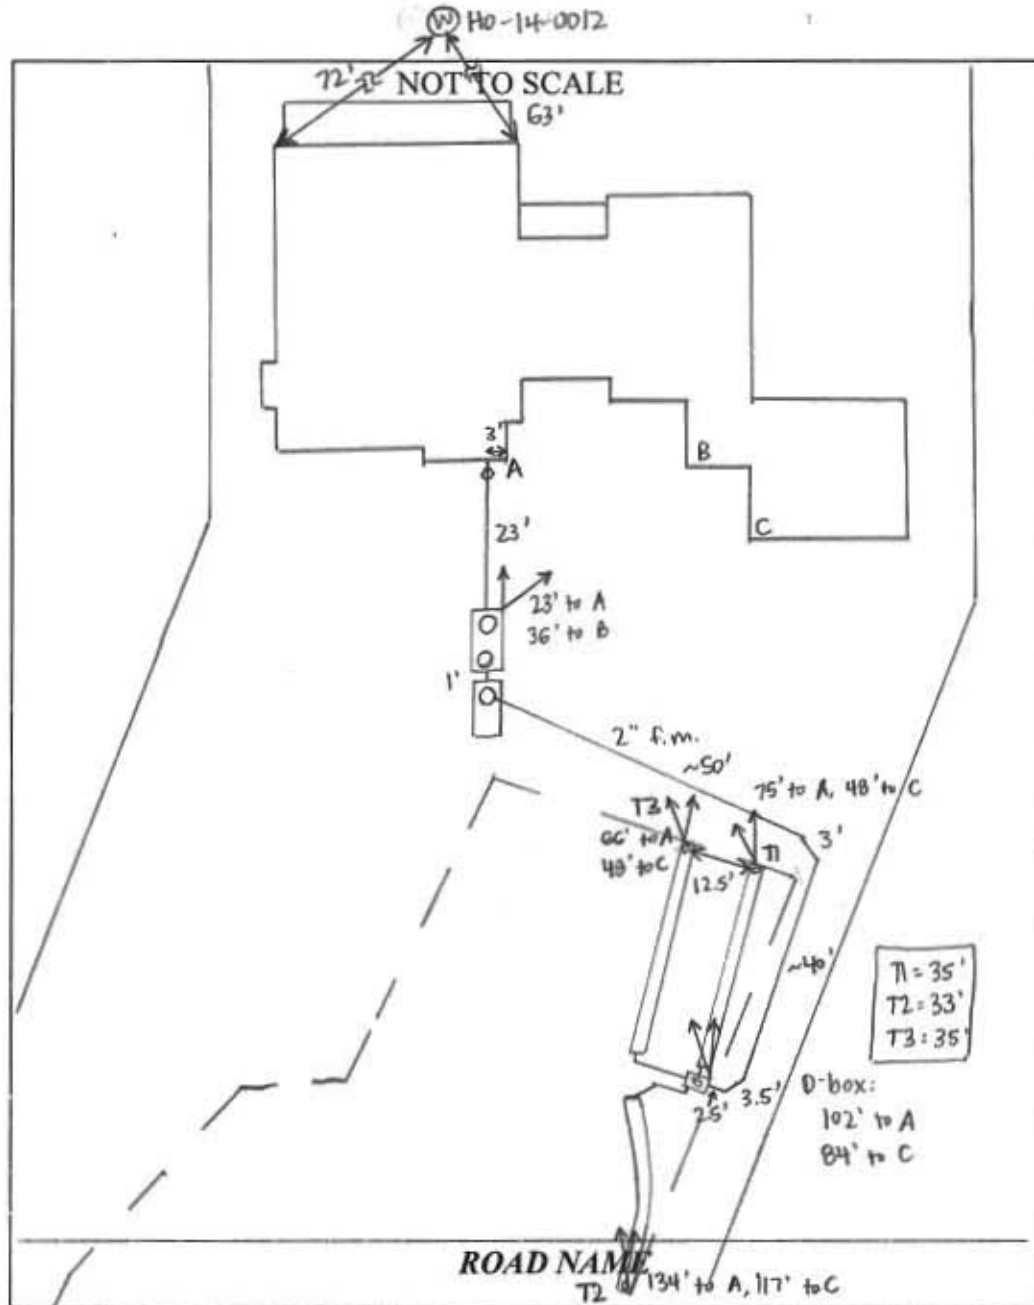

TRENCH/DRAINFIELD DATA		
WIDTH	INLET	BOTTOM
2'	3'	8'
NUMBER OF TRENCHES	3	
TOTAL LENGTH	103'	
ABSORPTION AREA	206' + SIDEWALL	
DISTRIBUTION BOX LEVEL	YES	
DISTRIBUTION BOX BAFFLE	ELBOW	
DISTRIBUTION BOX PORT	YES	

SEPTIC TANK I DATA	
SEPTIC TANK I LEVEL	YES
MANUFACTURER	BABYLON
CAPACITY	2000 GAL
SEAM LOC	TOP
TANK LID DEPTH	2.5-3'
BAFFLES	YES
BAFFLE FILTER	NO
MANHOLE LOC	FRONT + REAR
6" PORT LOC	NONE
WATERTIGHT TEST	NO
SLOTTED	YES
DATE ON LID	9-10-17
PUMP/SEPTIC TANK LEVEL YES	
MANUFACTURER	BABYLON
CAPACITY	2000 GAL
SEAM LOC	TOP
TANK LID DEPTH	2.5-3'
BAFFLES	NO
BAFFLE FILTER	NO
MANHOLE LOC	FRONT
6" PORT LOC	NONE
WATERTIGHT TEST	NO
SLOTTED	NO
DATE ON LID	9-4-17


PRE-CONSTRUCTION:

10/11/17 Met Jeff from Hatfield's on site for layout. SDA corners and tanks staked. Shot contour + laid out 3x34' trenches on contour. Didn't pull full length of lower trench due to bees in area - Hatfield's will measure 34' length prior to trench installation. (SC)

INSTALLATION:

10/12/17 House connection made. First tank set + pipe laid from house to tank. Bees gone - painted out 34' of lower trench. (SC) 10/12/17 Pump tank set. Force main run up to D-box, covered at first bends so measurements are approximate. (SC) 10/13/17 Trenches installed. T1 + T2 left open for inspection, T2 left open at ends. 2' wide, 2.5' to stone. Need pump + alarm test. (SC) 1/22/2018 Pump + Alarm ok. Septic on Breaker 9 Alarm on another Breaker. (SC)

FINAL INSPECTOR [Signature] DATE OF APPROVAL 1/22/2018

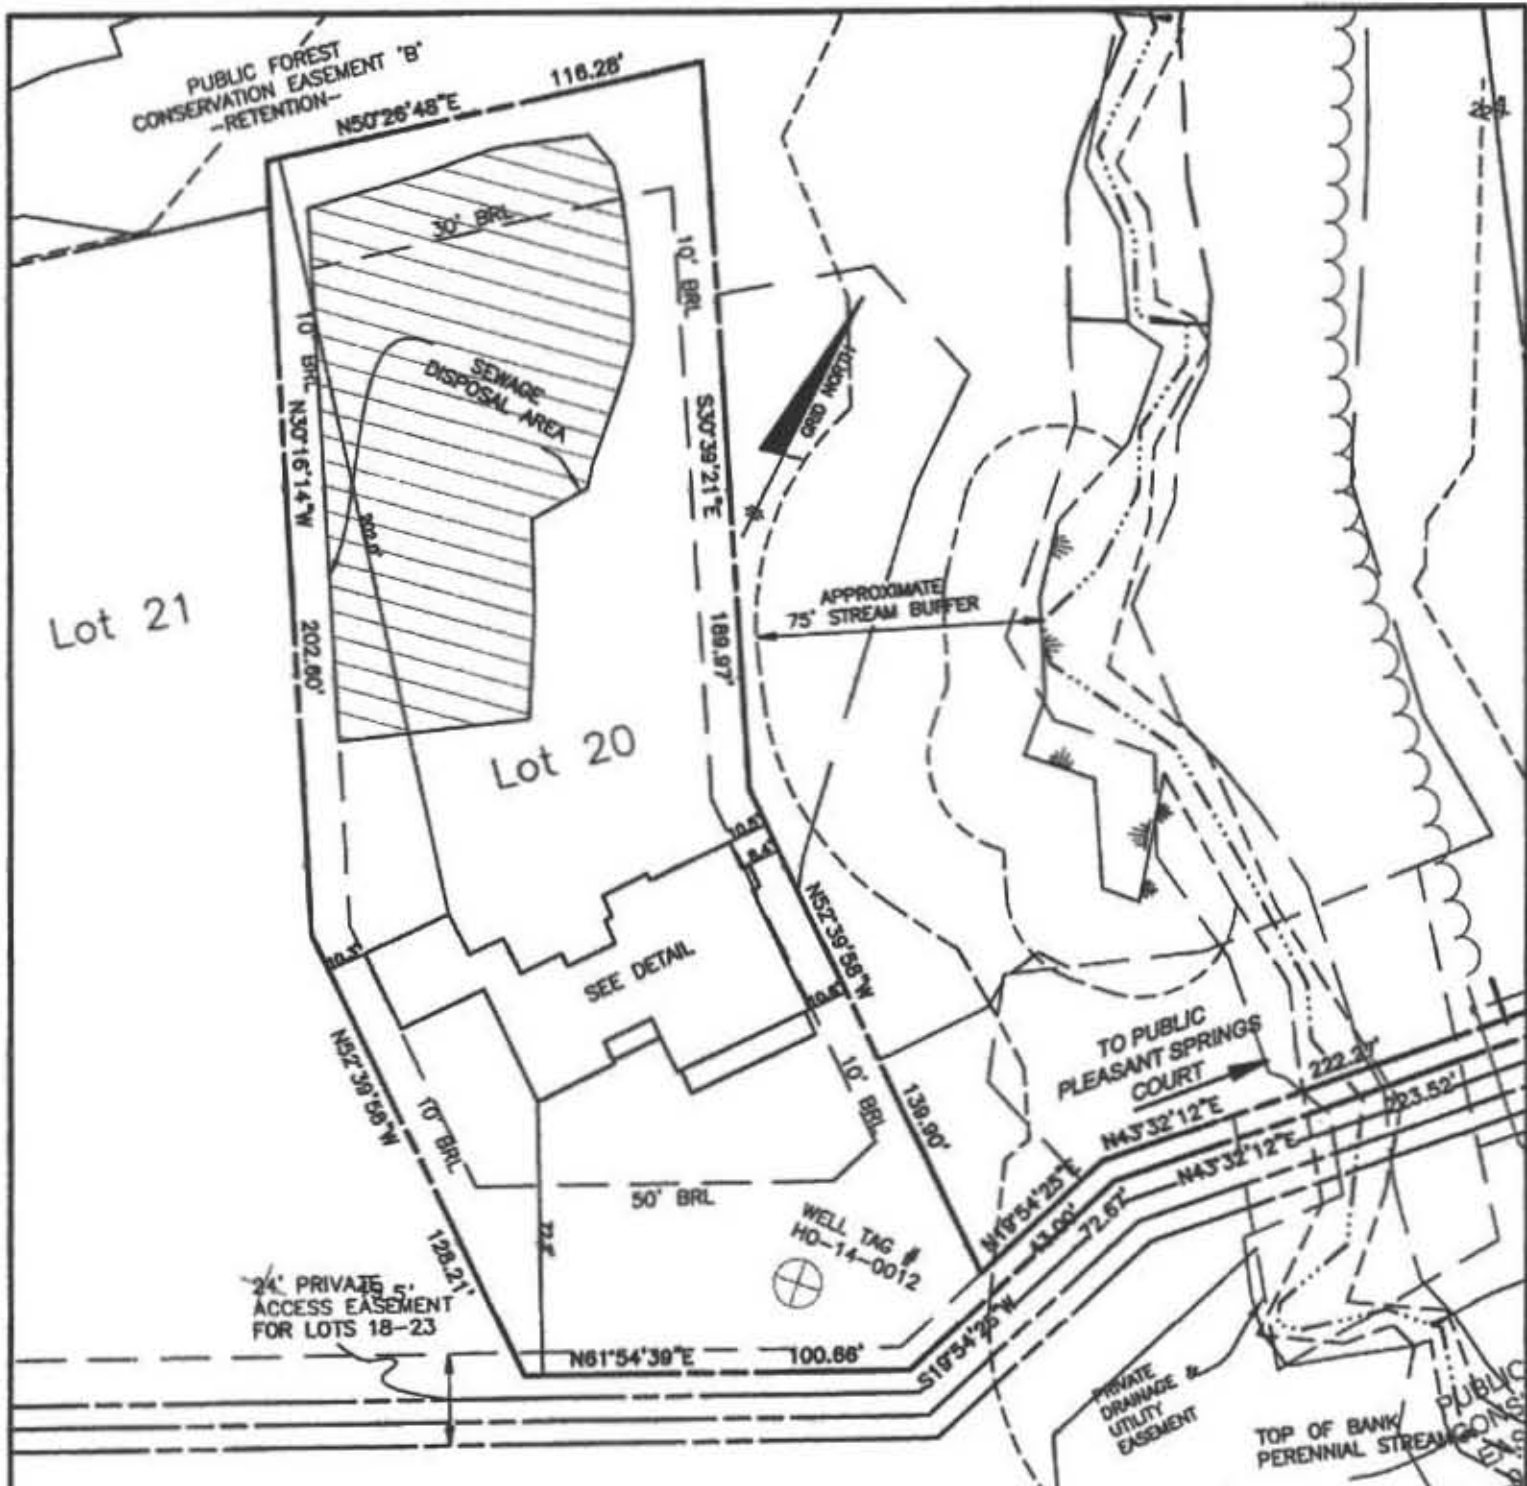

TOP OF FOUNDATION WALL = 436.0'
 OFFSET DIMENSIONS TO PROPERTY LINES ARE ± 0.1'

SURVEYOR'S CERTIFICATE


I HEREBY CERTIFY THAT THESE DOCUMENTS, WERE PREPARED BY ME OR UNDER MY RESPONSIBLE CHARGE, AND THAT I AM A DULY LICENSED PROFESSIONAL LAND SURVEYOR UNDER THE LAWS OF THE STATE OF MARYLAND, LICENSE NO. 21320, EXPIRATION DATE 1-7-2019 AND TO THE BEST OF MY PROFESSIONAL KNOWLEDGE, INFORMATION AND BELIEF, THAT THE DIMENSIONS OF THE BUILDING WALLS SHOWN HEREON ARE CORRECT; THAT THEY ARE BASED ON A FIELD RUN SURVEY PERFORMED BY BENCHMARK ENGINEERING, INC. ON 08/23/2017.



DONALD A. MASON
 PROFESSIONAL LAND SURVEYOR
 MARYLAND REG. No. 21320

FEMA FIRM No. 24027C0140D
 ZONE: X
 DATED: 11/06/2013

BENCHMARK

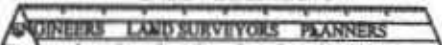

ENGINEERING, INC.

6480 BALTIMORE NATIONAL PIKE & SUITE 315
 ELLICOTT CITY, MARYLAND 21043
 (P) 410-488-8105 & (F) 410-488-6844

WWW.BE-CAL-ENGINEERING.COM



FOUNDATION DETAIL
 SCALE: 1" = 30'


WALL CHECK

REGAN PROPERTY
LOTS 2 THRU 23
PLAT No. 23067
LOT No. 20

12240 PLEASANT SPRINGS COURT

5TH ELECTION DISTRICT
 HOWARD COUNTY, MARYLAND

FIELD OBS. BY PJ
 COMP. BY DAM
 DRAWN BY EWF SCALE: 1" = 50' DATE: 08/23/2017

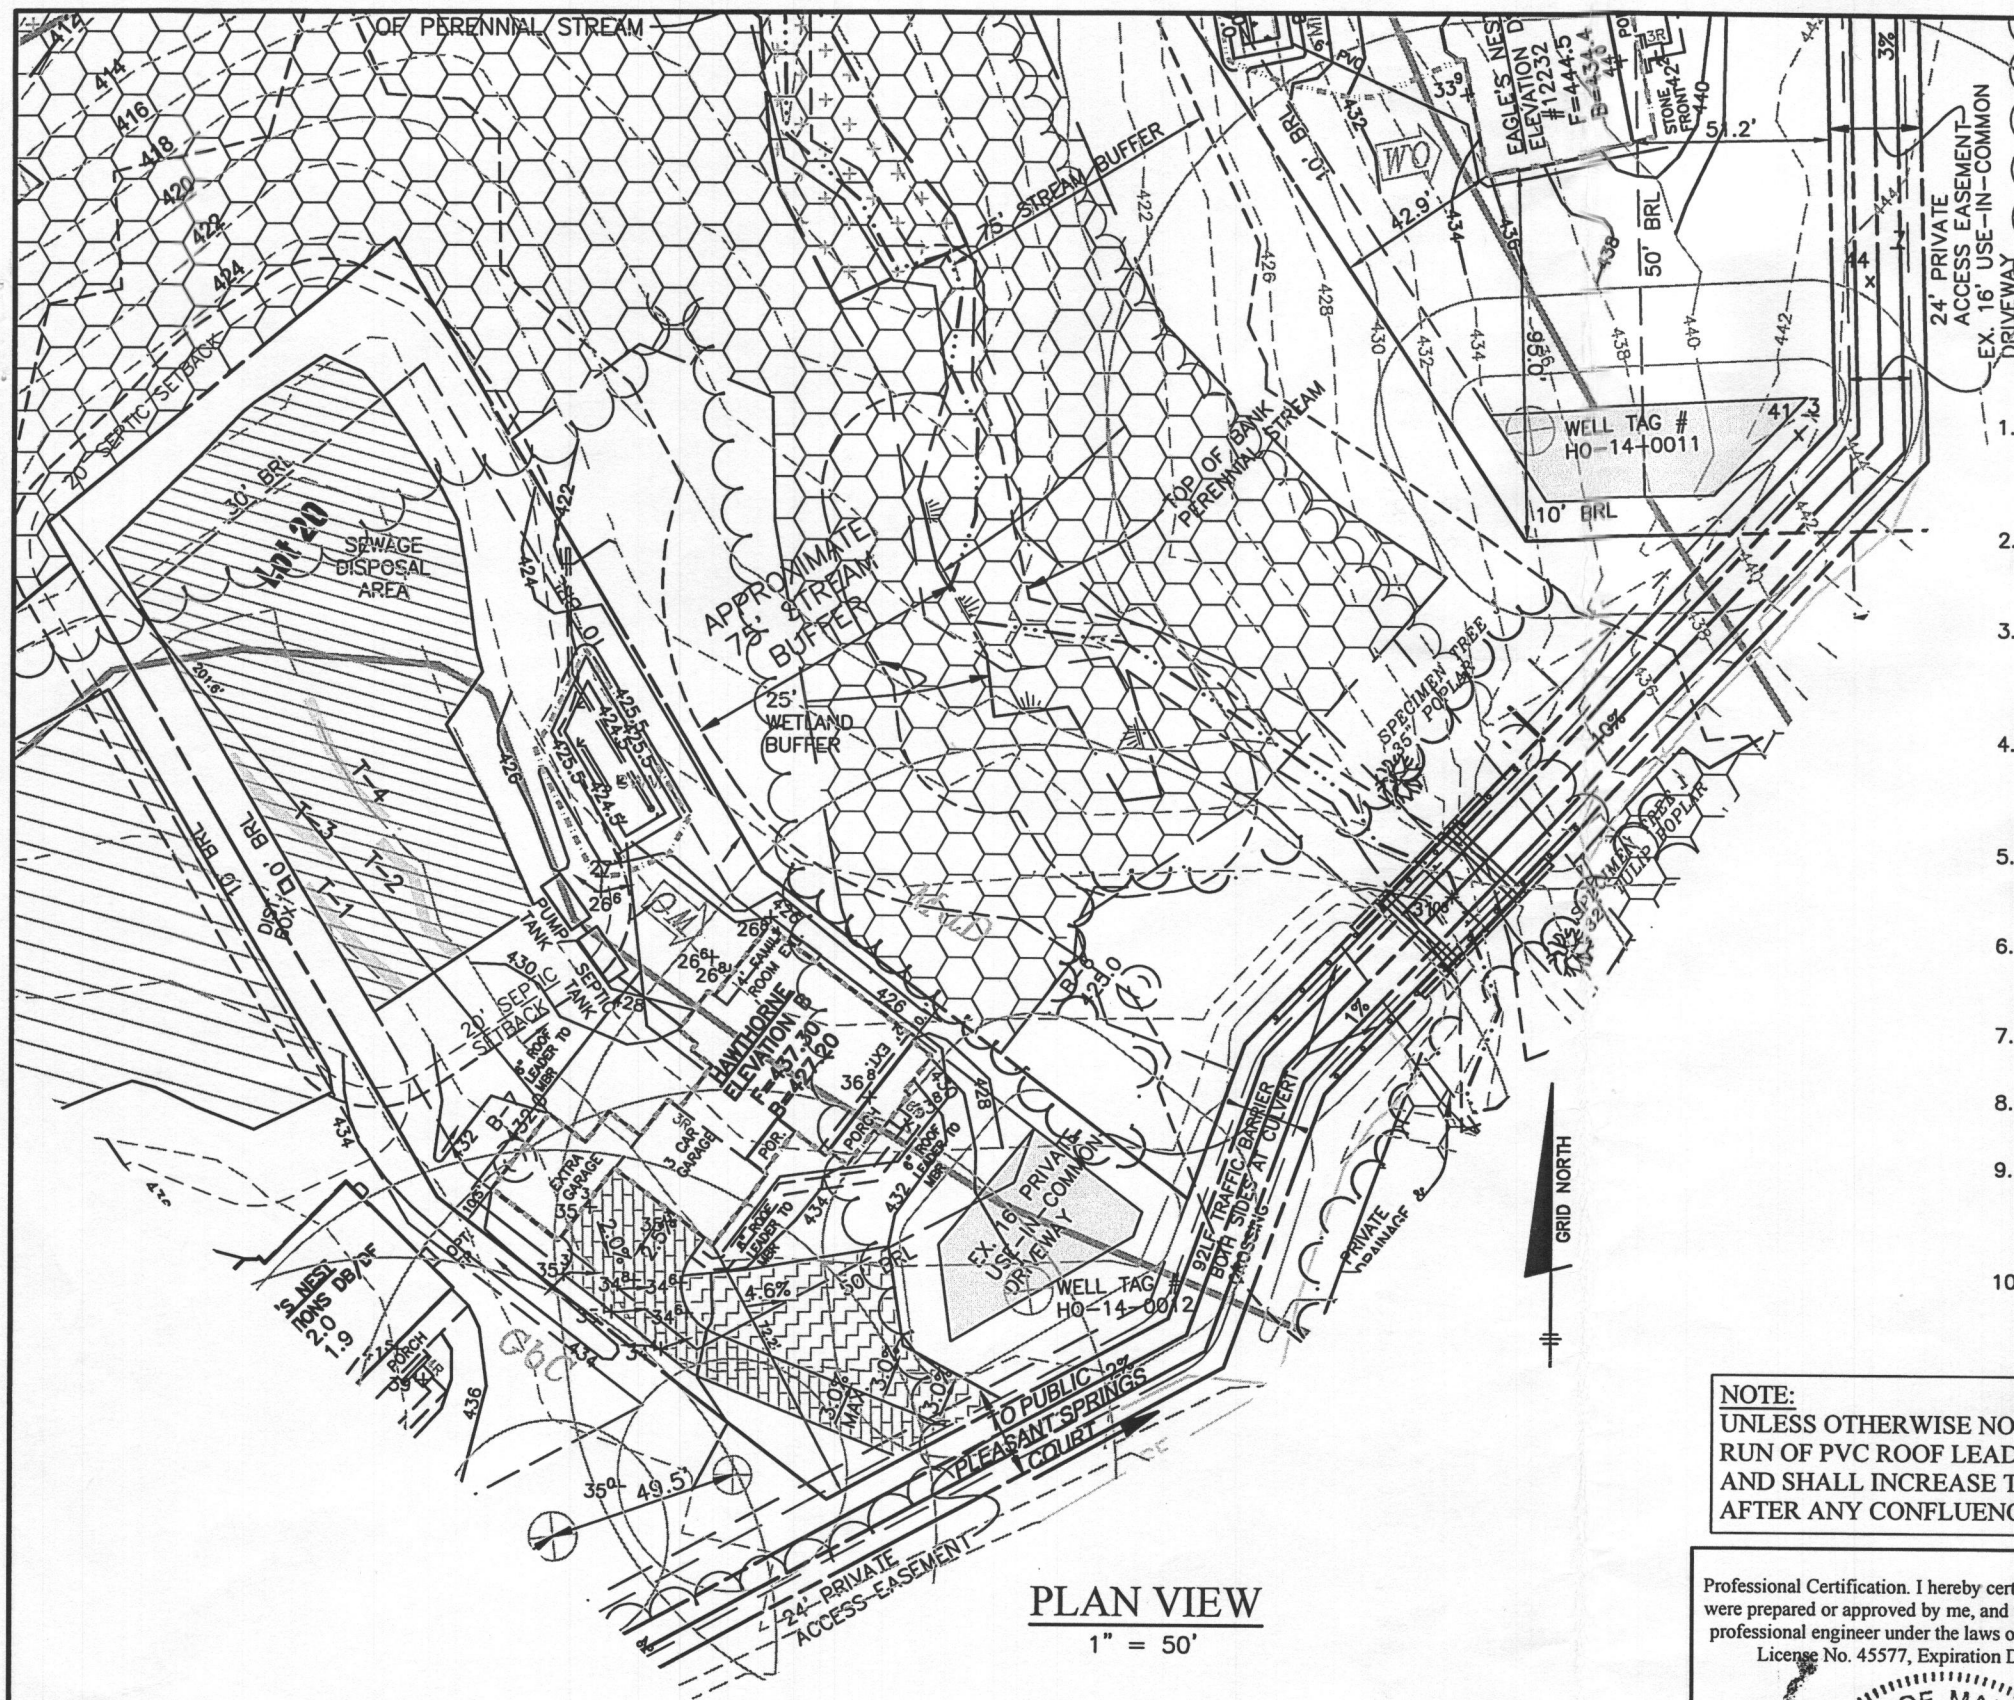

PLAN VIEW
1" = 50'

BUILDING PERMIT PLAN NOTES:

1. THE LOT SHOWN HEREON WAS RECORDED ON THE PLAT FOR REGAN PROPERTY, PLAT Nos. 23063-23074. REFER TO THE PLATS FOR LOT DIMENSIONS, LOT AREAS, ALL EASEMENTS AND CONDITIONS.
2. SEDIMENT AND EROSION CONTROLS WERE APPROVED BY HOWARD SOIL CONSERVATION DISTRICT UNDER A GRADING PLAN AND MODIFIED FOR THIS SPECIFIC HOUSE.
3. TOPOGRAPHY SHOWN HEREON IS TAKEN FROM THE APPROVED ROAD CONSTRUCTION PLANS AND TOPOGRAPHIC INFORMATION PROVIDED BY BENCHMARK ENGINEERING, INC., ON OR ABOUT JANUARY, 2012.
4. ALL SEDIMENT AND EROSION CONTROL FEATURES USED ON THIS SITE SHALL COMPLY WITH THE 2011 MARYLAND STANDARDS AND SPECIFICATIONS FOR SOIL EROSION AND SEDIMENT CONTROL.
5. ALL DRAINAGE AND STORMWATER MANAGEMENT FEATURES USED ON THIS SITE MUST COMPLY WITH THE APPROVED ROAD CONSTRUCTION PLANS EXCEPT AS WAIVED.
6. THE EXISTING WELL SHOWN ON THIS PLAN, HO-14-0012, HAS BEEN FIELD LOCATED BY BENCHMARK ENGINEERING, INC., AND IS ACCURATELY SHOWN.
7. THERE ARE NO EXISTING WELLS OR SEPTIC SYSTEMS WITHIN 100' OF THIS PROJECT'S BOUNDARY EXCEPT AS NOTED.
8. ANY CHANGES TO A PRIVATE SEWAGE DISPOSAL AREA OR WELL BOX SHALL REQUIRE A REVISED PERCOLATION CERTIFICATION PLAN.
9. STORMWATER MANAGEMENT FOR THIS LOT WAS DESIGNED AND PROVIDED BY ONE MICRO-BIORETENTION FACILITY (MDE M-6), DRY WELL FACILITY (MDE M-5) AND ONE NON-ROOFTOP DISCONNECTION (MDE N-2).
10. MICRO-BIORETENTION SHALL HAVE EITHER A 4" OR 6" ROOF LEADER DEPENDING ON ROOF-TOP AREA.

NOTE:
UNLESS OTHERWISE NOTED, THE FIRST RUN OF PVC ROOF LEADER SHALL BE 4" AND SHALL INCREASE TO AT LEAST 6" AFTER ANY CONFLUENCE OF 4" PIPES.



Professional Certification. I hereby certify that these documents were prepared or approved by me, and that I am a duly licensed professional engineer under the laws of the State of Maryland, License No. 45577, Expiration Date: 06-08-2018.



OWNER/BUILDER:		BENCHMARK ENGINEERS LAND SURVEYORS PLANNERS ENGINEERING, INC. 8480 BALTIMORE NATIONAL PIKE SUITE 315 ELLCOTT CITY, MARYLAND 21043 (P) 410-465-6105 (F) 410-465-6644 WWW.BEI-CIVLENGINEERING.COM	
PROJECT:		REGAN PROPERTY LOT 20	
LOCATION:		12240 PLEASANT SPRINGS COURT HIGHLAND, MD 20777 TAX MAP No. 34 - BLOCK No. 24 - PARCEL No. 200 5TH ELECTION DISTRICT, TAX ID NUMBER: 05 597453	
TITLE:		SEPTIC PERMIT PLAN	
HOUSE TYPE:		HAWTHORNE - ELEVATION 'B'	
DATE:	JUNE, 2017	PROJECT NO.	2171
SCALE:	AS SHOWN	DRAWING	1 OF 4

TRENCH INFORMATION

INITIAL SYSTEM		FIRST REPLACEMENT SYSTEM	
TRENCH T-1		TRENCH T-3	
TRENCH LENGTH	38 LF	TRENCH LENGTH	38 LF
GROUND ELEVATION	431.8	GROUND ELEVATION	431.0
INVERT ELEVATION	428.8	INVERT ELEVATION	428.0
MAX. BOTTOM ELEV.	423.8	MAX. BOTTOM ELEV.	423.0
TRENCH T-2		TRENCH T-4	
TRENCH LENGTH	38 LF	TRENCH LENGTH	38 LF
GROUND ELEVATION	430.2	GROUND ELEVATION	430.0
INVERT ELEVATION	427.2	INVERT ELEVATION	427.0
MAX. BOTTOM ELEV.	422.2	MAX. BOTTOM ELEV.	422.0

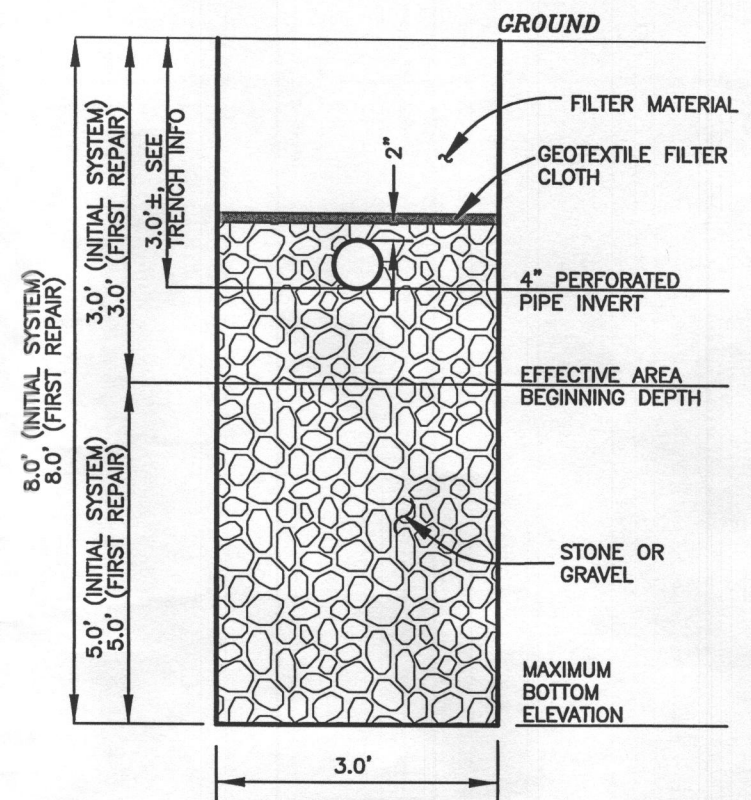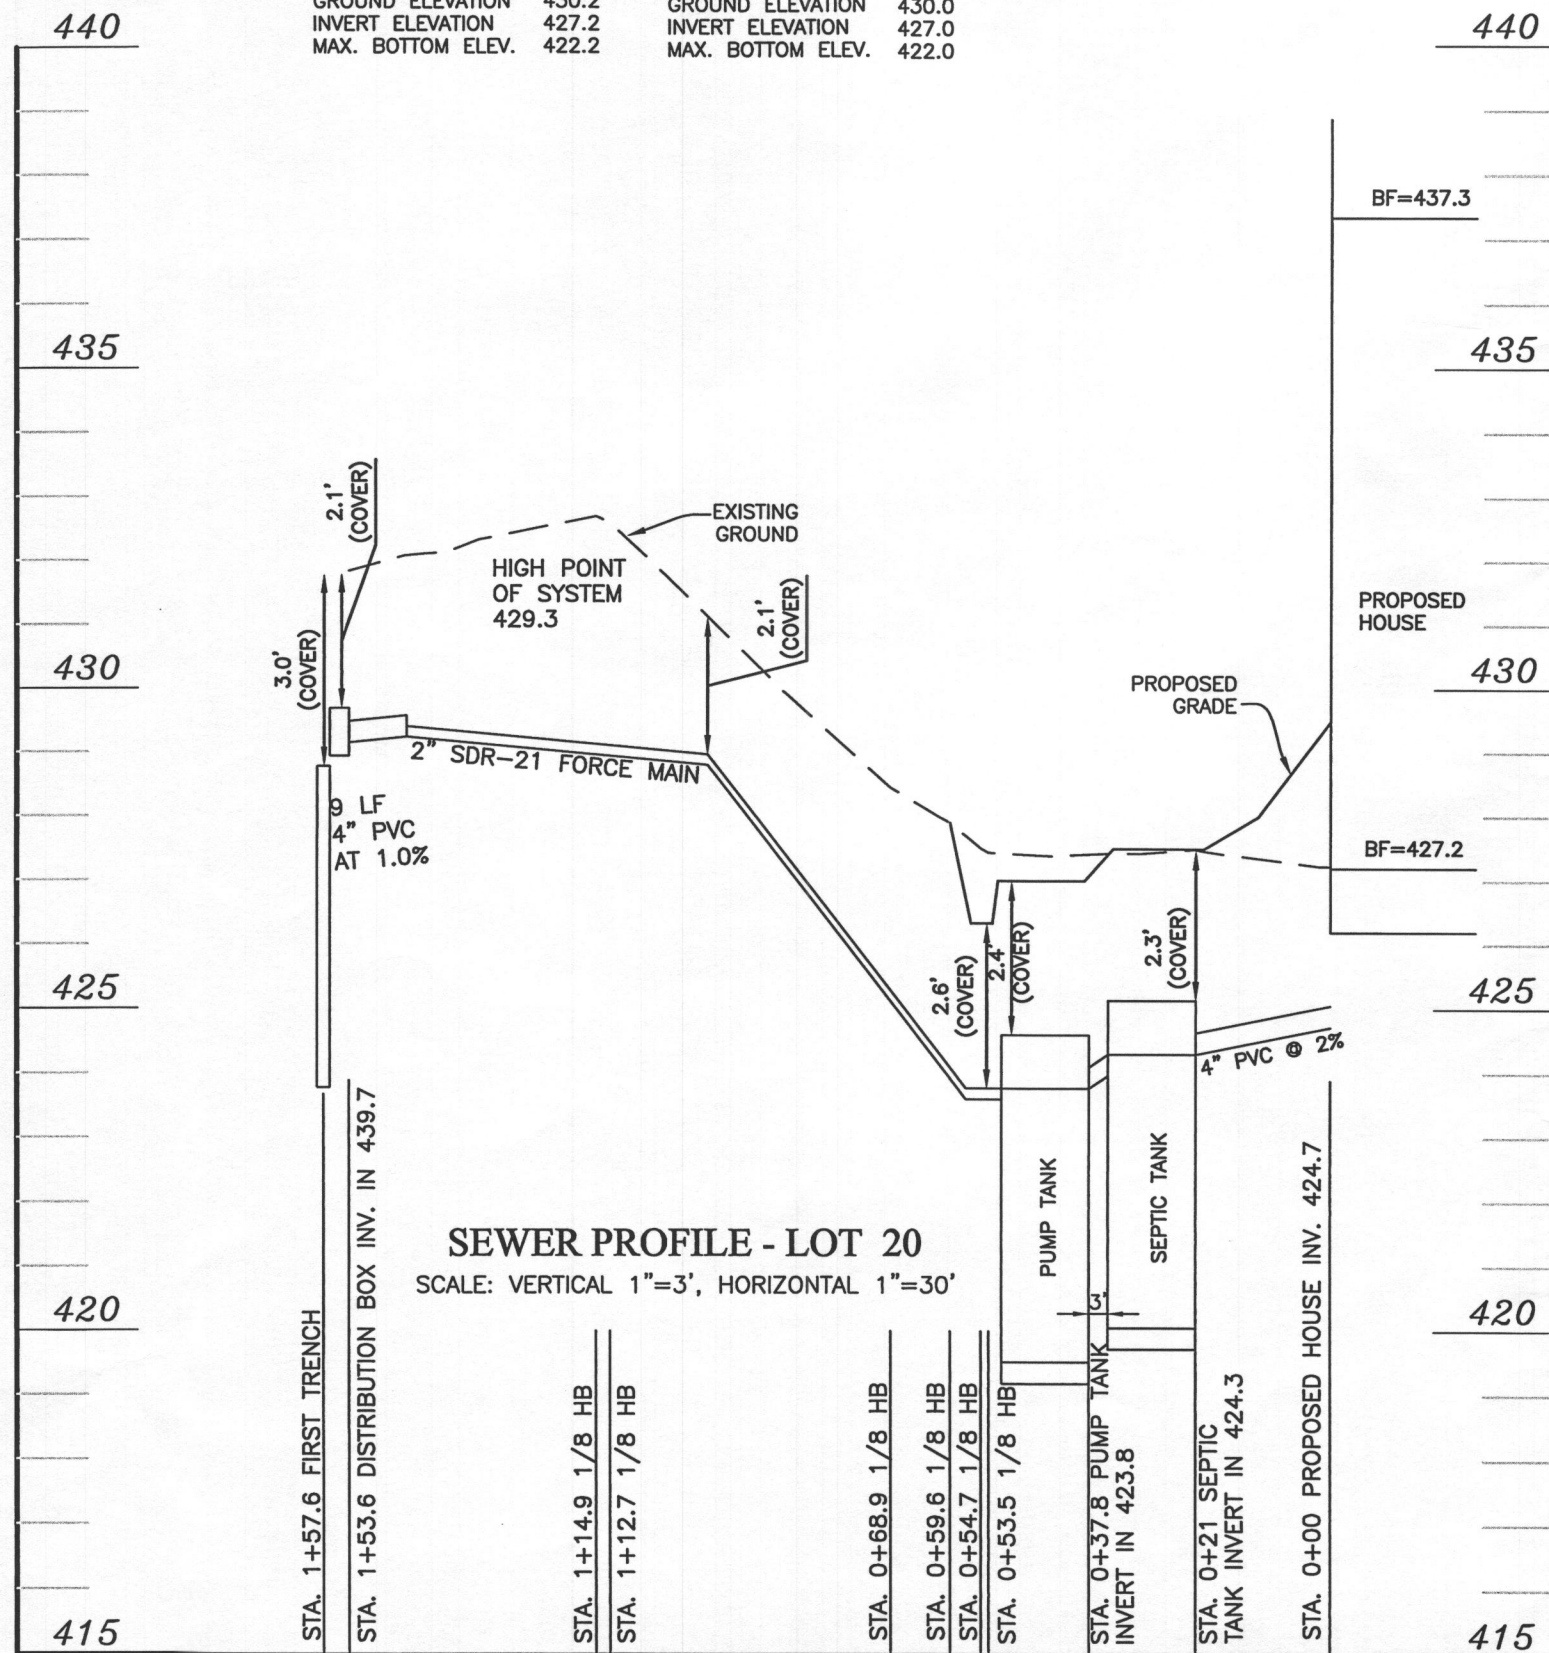

INITIAL SYSTEM		
Number of Bedrooms	5	
Application Rate	1.2	gpd/sf
Effective Area Beginning Depth	3	ft
Bottom Max Depth	8	ft
Design Flow	750	gpd
Drainage Field square footage	625	sf
Sidewall reduction credit	0.36	
Trench width	3	
Effective Area Depth	5	
Linear Length of trench Required	74	lf

1st REPLACEMENT SYSTEM		
Number of Bedrooms	5	
Application Rate	1.2	gpd/sf
Effective Area Beginning Depth	3	ft
Bottom Max Depth	8	ft
Design Flow	750	gpd
Drainage Field square footage	625	sf
Sidewall reduction credit	0.36	
Trench width	3	
Effective Area Depth	5	
Linear Length of trench Required	74	lf

THIS PLAN IS FOR SEPTIC DESIGN ONLY

SEE MANUFACTURERS SPECIFICATIONS FOR DETAILS.
WWW.MAYERPRECAST.COM
EQUIVALENT FROM OTHER MANUFACTURERS CAN BE SUBSTITUTED.

SIGNATURE AND SEAL ARE FOR SEPTIC PROFILE AND CALCULATIONS ONLY, TANK AND DETAILS WERE NOT DESIGNED OR REVIEWED BY THE ENGINEER:

Professional Certification. I hereby certify that these documents were prepared or approved by me, and that I am a duly licensed professional engineer under the laws of the State of Maryland, License No. 45577, Expiration Date: 06-08-2018.



OWNER/BUILDER: MB HIGHLAND RESERVE, LLC
1686 EAST GUDE DRIVE
ROCKVILLE, MD 20850
301-762-9511

BENCHMARK ENGINEERING, INC.
ENGINEERS LAND SURVEYORS PLANNERS
8480 BALTIMORE NATIONAL PIKE SUITE 315
ELLCOTT CITY, MARYLAND 21043
(P) 410-465-6105 (F) 410-465-6644
WWW.BEI-CMLENGINEERING.COM

PROJECT: **REGAN PROPERTY LOT 20**

LOCATION: 12240 PLEASANT SPRINGS COURT
HIGHLAND, MD 20777
TAX MAP No. 34 - BLOCK No. 24 - PARCEL No. 200
5TH ELECTION DISTRICT, TAX ID NUMBER: 05 597453

TITLE: **SEPTIC PERMIT PLAN**

HOUSE TYPE: **HAWTHORNE - ELEVATION 'B'**


DATE: JUNE, 2017 PROJECT NO. 2171

SCALE: AS SHOWN DRAWING 2 OF 4

**TOTAL DYNAMIC HEAD
FLOW PER MINUTE**

MODEL	151		152		153		
Feet	Meters	Gal.	Liters	Gal.	Liters	Gal.	Liters
5	1.5	50	189	69	261	77	291
10	3.0	45	170	61	231	70	265
15	4.5	38	144	53	201	61	231
20	6.1	29	110	44	167	52	197
25	7.6	16	61	34	129	42	159
30	9.1	-	-	23	87	33	125
35	10.7	-	-	-	-	22	85
40	12.2	-	-	-	-	11	42
Shut-off Head	-	30 ft. (9.1m)	-	30 ft. (9.1m)	-	44 ft. (13.4m)	-

Use Model 151

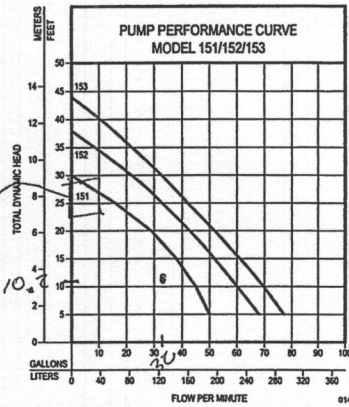

Model	MODEL COMPARISON										
	Seal	Mode	Volts	Ph	Amps	HP	H _z	Lbs	Kg	Simplex	Duplex
N151	Single	Non	115	1	6.0	1/3	60	32	15	1	2 or 3
E151	Single	Non	230	1	3.2	1/3	60	32	15	1	2 or 3
BN151	Single	Auto	115	1	6.0	1/3	60	33	15	*	2 or 3
BE151	Single	Auto	230	1	3.2	1/3	60	33	15	*	2 or 3
N152	Single	Non	115	1	8.5	4/10	60	37	17	1	2 or 3
E152	Single	Non	230	1	4.3	4/10	60	37	17	1	2 or 3
BN152	Single	Auto	115	1	8.5	4/10	60	39	18	*	2 or 3
BE152	Single	Auto	230	1	4.3	4/10	60	39	18	*	2 or 3
N153	Single	Non	115	1	10.5	1/2	60	37	17	1	2 or 3
BN153	Single	Auto	115	1	10.5	1/2	60	39	18	*	2 or 3
E153	Single	Non	230	1	5.3	1/2	60	37	17	1	2 or 3
BE153	Single	Auto	230	1	5.3	1/2	60	39	18	*	2 or 3

*BN and BE models include a 20' (6 m) piggyback variable level pump switch. Additional cord lengths are available in 25' (8 m) and 35' (11 m). 50' (15 m) cords are available for 230 V units only.
NOTE: Model 151 has a plastic base. Models 152 & 153 have a cast iron base.


SELECTION GUIDE

- For automatic, use single piggyback variable level float switch or double piggyback variable level float switch. Refer to FM0477.
- See FM1228 for correct model of simplex control panel.
- See FM0712 for correct model of duplex control panel.

OPTIONAL PUMP STAND P/N 10-2421


- Reduces potential clogging by debris
- Replaces rocks or bricks under the pump
- Made of durable, noncorrosive ABS
- Raises pump 2" (5 cm) off bottom of basin
- Provides the ability to raise intake by adding sections of 1/2" or 2" (DN40 or DN50) PVC piping
- Attaches securely to pump
- Accommodates sump, dewatering and effluent applications

NOTE: Make sure float is free from obstruction.

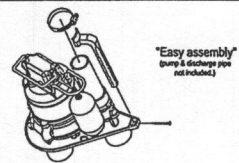


CAUTION All installation of controls, protection devices and wiring should be done by a qualified licensed electrician. All electrical and safety codes should be followed including the most recent National Electrical Code (NEC) and the Occupational Safety and Health Act (OSHA).

© Copyright 2015 Zoeller® Co. All rights reserved.
502-778-2731 | 800-928-7867 | 3649 Cane Run Road | Louisville, KY 40211-1961 | www.zoeller.com

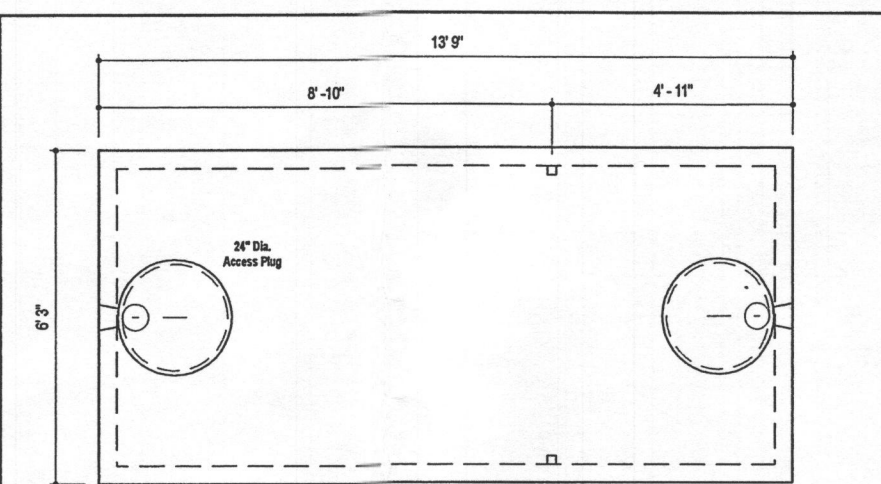

PLAN VIEW

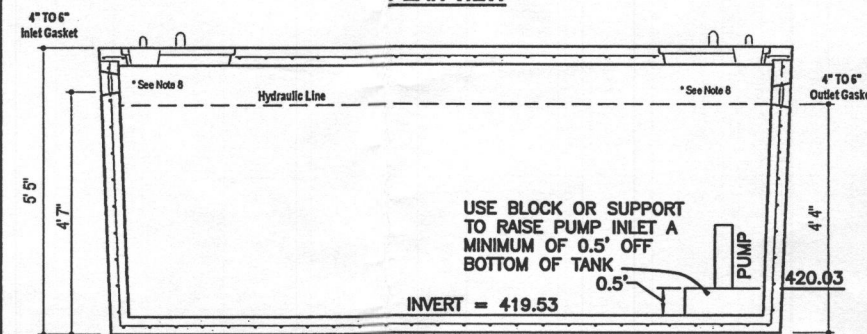

SECTION A-A

DESIGN DATA & GENERAL NOTES


- Concrete strength $f_c=4,000$ p.s.i. @ 28 days. Density = 160 pcf.
- Cement - Portland Type III per ASTM C 150-92.
- Admixtures & plasticizers per ASTM C 260-98 & C 494-92.
- Reinforcing per ASTM A105. Min. 1-1/2" cover.
- Top slab sealed with butyl rope mastic.
- 4" wall, 4" base, & 5" top thickness.
- Max 3" of cover
- Depending on use of tank, inlet & outlet baffle may be required by code.

FLOAT TREE:	ELEV.	RELATIVE TO BOTTOM
BOTTOM OF TANK	419.53	
TOP OF PUMP	421.13	1'-7 1/4"
PUMP OFF	421.20	1'-8"
PUMP ON	421.49	1'-11 1/2"
HIGH ALARM	421.99	2'-5 1/2"


WEIGHT = 19,000 lbs.

MBI
Mayer Bros., Inc.
6264 Race Road
Elkridge, Maryland 21075
Tel. 410.796.1434
Fax. 410.796.1438
www.mayerbrosprecast.com

2,000 GALLON SEPTIC TANK
1-Compartment **LOT 20**
Stock Item [Approx. 19,900 lbs]
Dwg. No. 2000-1C No Scale Aug. 11, 2008

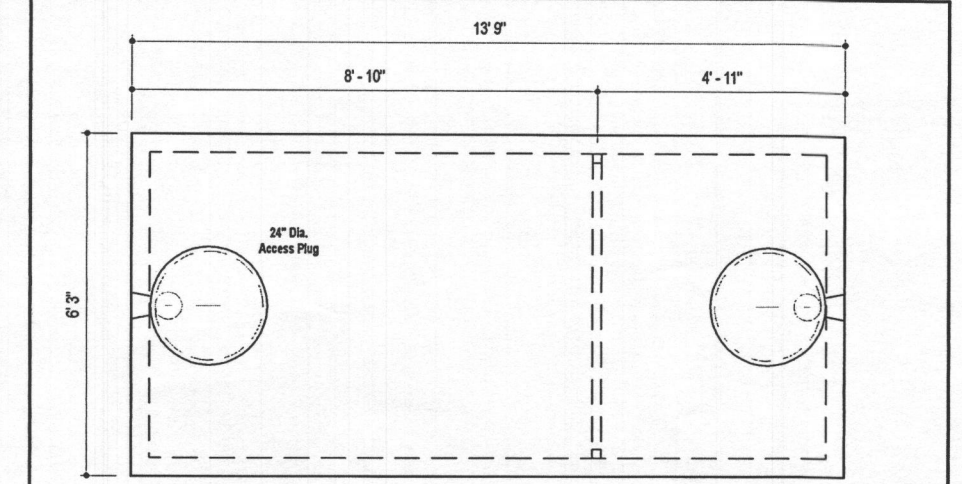

PLAN VIEW

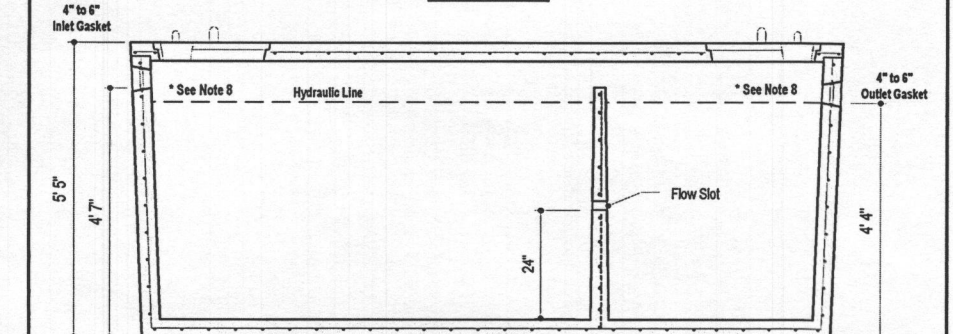

SECTION A-A

DESIGN DATA & GENERAL NOTES

- Concrete strength $f_c=4,000$ p.s.i. @ 28 days. Density = 160 pcf.
- Cement - Portland Type III per ASTM C 150-92.
- Admixtures & plasticizers per ASTM C 260-98 & C 494-92.
- Reinforcing per ASTM A105. Min. 1-1/2" cover.
- Top slab sealed with butyl rope mastic.
- 4" wall, 4" base, & 5" top thickness.
- Max 3" of cover
- Depending on use of tank, inlet & outlet baffle may be required by code.

MBI
Mayer Bros., Inc.
6264 Race Road
Elkridge, Maryland 21075
Tel. 410.796.1434
Fax. 410.796.1438
www.mayerbrosprecast.com


2,000 GALLON SEPTIC TANK
2-Compartment
Stock Item [Approx. 19,900 lbs]
Dwg. No. 2000-2C No Scale Aug 11, 2008

**THIS PLAN IS FOR
SEPTIC DESIGN ONLY**

**SEE MANUFACTURERS
SPECIFICATIONS FOR
DETAILS.
EQUIVALENT FROM OTHER
MANUFACTURERS CAN BE
SUBSTITUTED.**

**SIGNATURE AND SEAL ARE FOR SEPTIC
PROFILE AND CALCULATIONS ONLY, TANK,
PUMP, AND DETAILS WERE NOT DESIGNED
OR REVIEWED BY THE ENGINEER:**

Professional Certification. I hereby certify that these documents were prepared or approved by me, and that I am a duly licensed professional engineer under the laws of the State of Maryland, License No. 45577, Expiration Date: 06-08-2018.

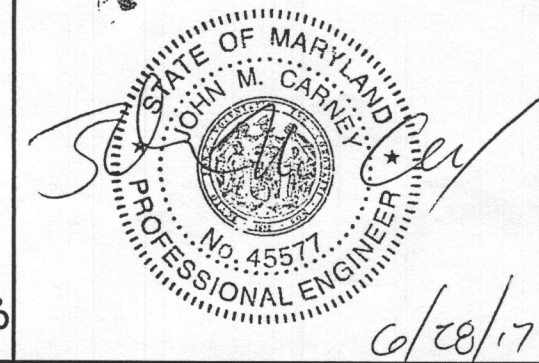

OWNER/BUILDER:		BENCHMARK ENGINEERS LAND SURVEYORS PLANNERS ENGINEERING, INC. 8480 BALTIMORE NATIONAL PIKE SUITE 315 ELLICOTT CITY, MARYLAND 21043 (P) 410-485-6105 (F) 410-485-6644 WWW.BEI-CVILENGINEERING.COM	
PROJECT:		REGAN PROPERTY LOT 20	
LOCATION:		12240 PLEASANT SPRINGS COURT HIGHLAND, MD 20777 TAX MAP No. 34 - BLOCK No. 24 - PARCEL No. 200 5TH ELECTION DISTRICT, TAX ID NUMBER: 05 597453	
TITLE:		SEPTIC PERMIT PLAN	
HOUSE TYPE:		HAWTHORNE - ELEVATION 'B'	
DATE:	JUNE, 2017	PROJECT NO.	2171
SCALE:	AS SHOWN	DRAWING	3 OF 4

Pumping Station

Diameter of Force Main and Manifold = 2 " of SDR 21 pipe
 Length of Force Main = 93 feet SDR 21 gallons/100 feet = 18.8 Table 4.2
 Volume of Main = 17.5 gallons ID = 2.149
 Total Volume = 17.5 gallons length = 100 gallon/sq ft 7.480519
 Minimum Dose must be greater than 1/6 of the design flow 125 gallons
 Minimum Dose must be greater than the volume of the main 18 gallons
 Use minimum dose of 160 gallons okay Doses per Day = 4.6875

Size Pump Chamber

Pump chamber must be able to hold one dose and one days design flow

One day Capacity = 750 gallons
 Dose = 160 gallons
 Totals = 910 gallons

Use 2,000 gallon pump tank

Tank Dimensions: Exterior Interior
 Length: 13.75 feet Length: 13.08 feet Walls: 0.33 feet
 Width: 6.25 feet Width: 5.58 feet Bottom: 0.33 feet
 Height: 5.42 feet Height: 4.67 feet Top: 0.42 feet
 Area: 73.05 sf Bottom to
 Volume: 341.14 cf Inlet: 4.58 feet

Sizing the Pump

Flow: runtime = 5 minutes
 rate = 32.00 gallons/minute

Design Head:

Design Head = Static Head + Friction Head
 Static Head = highest elevation of main - pump off elevation
 Highest component of system = 429.3 Main HP
 Pump off elevation = 421.20
 Static Head = 8.10 feet
 Friction Head = Head loss due to pipe friction
 2.0" pipe = 93 feet
 45° bends 6 loss for bend 24 feet per table 4.3
 Gate Valve 1 loss for tee 1.3 feet per table 4.3
 Friction loss per table 4.4 = 1.74 (ft/100 ft)
 Equivalent Length = 118.3 Friction loss 2.06 feet
 Total Friction Head = 2.06
 Design Head = 10.16 feet

Pump Requirements:

Performance = 32.00 gpm
 Head of Water = 10.16 feet of head

Pump Selection: Zoeller Pump Company Effluent Series, Model 151
 1/3 horse power

Pump Flow Rate = 44.00 gallons/minute per rating curve 3.64 Minutes
 TDH analysis 11.81 ft
 Between design and curve? Yes

Design Pump Chamber

Ground over Tank = 427.00 Cover 2.38 ft
 Top of Tank = 424.62
 Invert of Tank = 419.53
 6" Riser = 0.50 feet
 Pump Height = 1.10 feet
 Min. Pump off = 421.13
 Selected Pump off = 421.20
 Dose = 21.4 cf
 Area of Pit = 73.05 sf
 Pump on dist. = 0.29
 Pump on Elev. = 421.49
 Distance between Pump on and Highwater Alarm = 0.5 feet
 Highwater Alarm Elevation = 421.99
 Dist. for a dose above alarm = 1.37
 Minimum Inlet Elev. = 423.37
 Tank Inlet = 423.78 Okay
 Dist. Alarm to Inlet = 1.79 Okay

THIS PLAN IS FOR SEPTIC DESIGN ONLY

SEE MANUFACTURES SPECIFICATIONS FOR DETAILS. EQUIVALENT FROM OTHER MANUFACTURERS CAN BE SUBSTITUTED.

SIGNATURE AND SEAL ARE FOR SEPTIC PROFILE AND CALCULATIONS ONLY, TANK, PUMP AND DETAILS WERE NOT DESIGNED OR REVIEWED BY THE ENGINEER:

Professional Certification. I hereby certify that these documents were prepared or approved by me, and that I am a duly licensed professional engineer under the laws of the State of Maryland, License No. 45577, Expiration Date: 06-08-2018.



OWNER/BUILDER:	BENCHMARK ENGINEERS LAND SURVEYORS PLANNERS ENGINEERING, INC. 8480 BALTIMORE NATIONAL PIKE SUITE 315 ELLICOTT CITY, MARYLAND 21043 (P) 410-465-6105 ▲ (F) 410-465-6644 WWW.BEI-CVLENGINEERING.COM	
PROJECT:	REGAN PROPERTY LOT 20	
LOCATION:	12240 PLEASANT SPRINGS COURT HIGHLAND, MD 20777 TAX MAP No. 34 - BLOCK No. 24 - PARCEL No. 200 5TH ELECTION DISTRICT, TAX ID NUMBER: 05 597453	
TITLE:	SEPTIC PERMIT PLAN	
HOUSE TYPE:	HAWTHORNE - ELEVATION 'B'	
DATE:	JUNE, 2017	PROJECT NO. 2171
SCALE:	AS SHOWN	DRAWING 4 OF 4