



Approved  
on 7/7/86  
by S. Abel

APPROVED


WALK-THRU BUILDING PERMIT  
BP# B08001164 A#:

APP. SAN. P. Buch

DESC. OF WORK: 10' x 42'  
DATE: 4/23/08

Front porch approved  
as shown

New 10' x 42'  
Front Porch

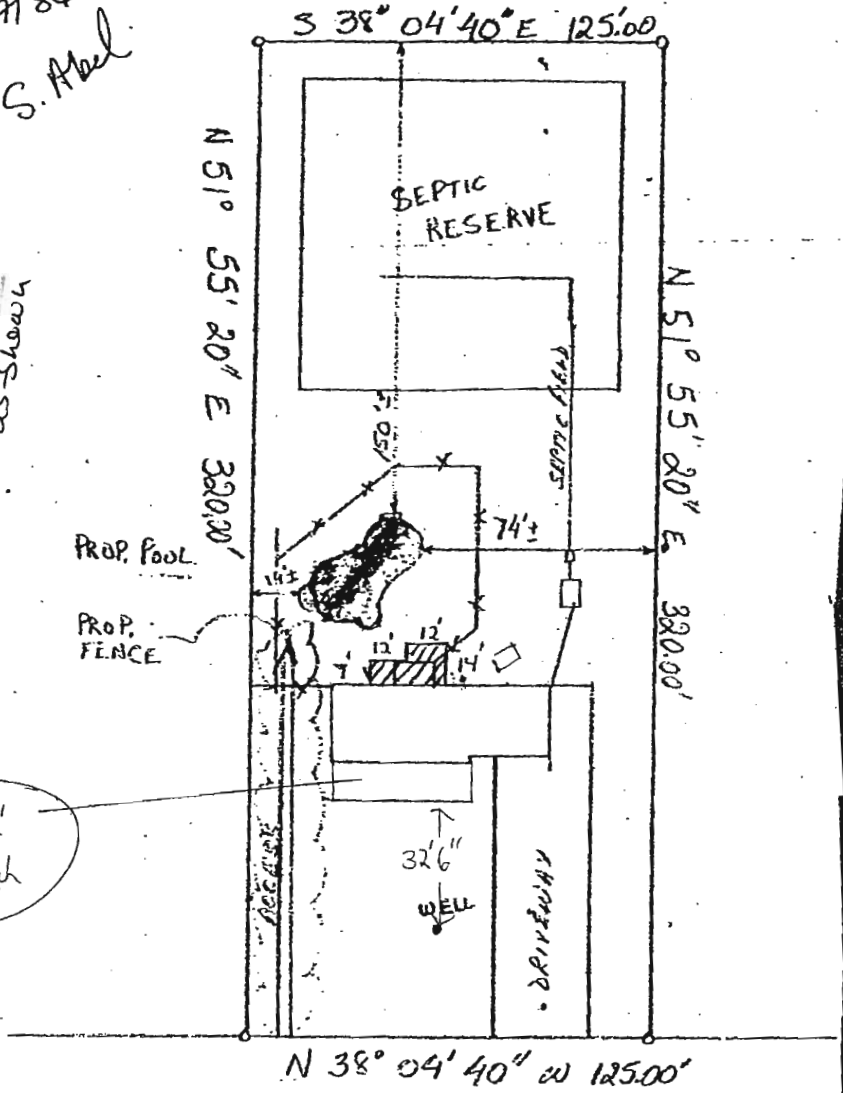

11294 OLD JOHNS HOPKINS RD.

SCALE 1" = 60'

LOT # 11

HALLMARK  
SECTION ONE.