

Bureau of Environmental Health
 8930 Stanford Boulevard, Columbia, MD 21045
 Main: 410-313-2640 | Fax: 410-313-2648
 TDD 410-313-2323 | Toll Free 1-866-313-6300
www.hchealth.org
 Facebook: www.facebook.com/hocohealth

Maura J. Rossman, M.D., Health Officer

RECEIPT DATE: 12/13/17 **ONSITE SEWAGE DISPOSAL SYSTEM** P 562359

INSTALLATION APPROVAL DATE: 3/6/18 (Rw) **PERMIT** A _____

SEWER HOUSE CONNECTION

PROPERTY ADDRESS: 5019 Crape Myrtle Court

SUBDIVISION: Walnut Creek LOT: 139 TAX ID: _____

CONTRACTOR: South Carroll Backhoe EMAIL: scbackhoe@comcast.net

CONTRACTOR ADDRESS: 4410 Salem Bottom Road, Westminster, MD 21157 PHONE: 410-596-3618

PROPERTY OWNER: NVR Inc. EMAIL: _____

OWNER ADDRESS: 9720 Patuxent Woods Road, Columbia, MD 21046 PHONE: 410-379-5956

NUMBER OF BEDROOMS: 5 CONNECTED TO PUBLIC WATER: YES NO

LOCATION:	INSTALL 4" SEWER LINE PER APPROVED SITE PLAN.
NOTES:	


ISSUED BY: Robert Freemon ISSUE DATE: 12/13/17 EXPIRATION DATE: 12/13/18

- NOTE: HOWARD COUNTY BUREAU OF UTILITIES APPROVAL OF GRINDER PUMP INSTALLATION IS REQUIRED PRIOR TO SEPTIC PERMIT APPROVAL
- NOTE: CONTRACTOR MUST SCHEDULE AN INSPECTION AND GAIN APPROVAL OF ALL COMPONENTS PRIOR TO COVERING
- NOTE: AN ELECTRICAL PERMIT IS REQUIRED FOR INSTALLATION OF ANY ELECTRICAL COMPONENTS OF THE SYSTEM

NEITHER THE HOWARD COUNTY COUNCIL NOR THE HEALTH DEPARTMENT IS RESPONSIBLE FOR THE SUCCESSFUL OPERATION OF ANY SYSTEM. PERMITTEE RESPONSIBLE FOR OBTAINING FINAL APPROVAL ON THIS PERMIT. CALL 410-313-1771 FOR INSPECTION OF SEPTIC SYSTEM.

NOT TO SCALE

W 40-15-0109

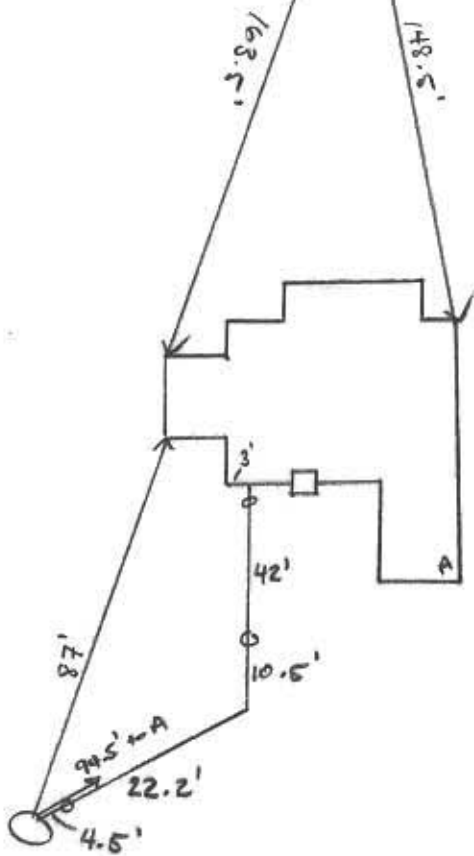

GRAPE MYRTLE ROAD NAME COURT

TRENCH/DRAINFIELD DATA

WIDTH INLET BOTTOM

NUMBER OF TRENCHES _____
 TOTAL LENGTH _____
 ABSORPTION AREA _____
 DISTRIBUTION BOX LEVEL _____
 DISTRIBUTION BOX BAFFLE _____
 DISTRIBUTION BOX PORT _____

SEPTIC TANK DATA

SEPTIC TANK 1 LEVEL _____
 MANUFACTURER _____
 CAPACITY _____ GAL
 SEAM LOC _____
 TANK LID DEPTH _____
 BAFFLES _____
 BAFFLE FILTER _____
 MANHOLE LOC _____
 6" PORT LOC _____
 WATERTIGHT TEST _____
 SLOTTED _____
 DATE ON LID _____

PUMP/SEPTIC TANK LEVEL _____
 MANUFACTURER _____
 CAPACITY _____ GAL
 SEAM LOC _____
 TANK LID DEPTH _____
 BAFFLES _____
 BAFFLE FILTER _____
 MANHOLE LOC _____
 6" PORT LOC _____
 WATERTIGHT TEST _____
 SLOTTED _____
 DATE ON LID _____

PRE-CONSTRUCTION:

SL SPEC: *Solvent Welded** Has Trace Wire

4" Cresline PVC DWV NSF DWV ASTM SCH 40 220 PSI WATER @ 73°F

PVC 1120 NSF DWV-G ASTM D 1785 PPFA 0817032MS AX 2341

INSTALLATION: 12/22/2017 Contractor installed sewer line. Awaiting start up from Utilities. (D)

3/6/25 start-up rec'd via email from DPW. (KRM)

FINAL INSPECTOR

[Signature]

DATE OF APPROVAL

Wolf, Kevin

From: Anastasia, James <janastas@nvrinc.com>
Sent: Thursday, March 01, 2018 10:15 AM
To: Wolf, Kevin
Cc: Howell, Brandon
Subject: FW: U&O Release (Street Address) 5019 Crape Myrtle Ct
Attachments: well results lot 139.pdf

Kevin

Please see U&O release below as well as attached well results. Can you please provide ICOP by Monday the 5th.

Regards,

Jimmy Anastasia
Project Manager
NV Homes
Cell: 240-712-0528

From: Bozzell, Duane [<mailto:DBozzell@howardcountymd.gov>]
Sent: Monday, February 26, 2018 6:37 AM
To: Miscbilling <Miscbilling@howardcountymd.gov>
Cc: Hart, Amy <AHart@howardcountymd.gov>; Rocco, Anthony <ARocco@howardcountymd.gov>; Martin, Sharhonda <smmartin@howardcountymd.gov>; Williams, Jeffrey <jewilliams@howardcountymd.gov>; Bozzell, Duane <DBozzell@howardcountymd.gov>; Bernard, Dana <dbernard@howardcountymd.gov>; Wolf, Kevin <KWolf@howardcountymd.gov>; Collins, Sarah <SCollins@howardcountymd.gov>; Tuder, Matt <MTuder@howardcountymd.gov>; Cagle, Clint <ccagle@nvrinc.com>; Srour, Matthew <msrour@nvrinc.com>; Anastasia, James <janastas@nvrinc.com>
Subject: [Ext] U&O Release (Street Address)

On the morning of 2-16-2018 observed the start-up of a Sewage Grinder Pump at the Walnut Creek Shared Septic System:

Walnut Creek, Contract #4773
NV Homes Homes, Lot # 139
5019 Crape Myrtle
Ellicott City, MD 21042

The Sewage Grinder Pump test was successful; the Bureau of Utilities releases its hold on this property for U&O.

Thank You.

*Duane Bozzell
DPW-Bureau of Utilities
Phone: (410)313-4900
Fax: (410)313-4989*

