

PRELIMINARY

APPLICATION

19040

EXX

A _____

P _____

SEWAGE DISPOSAL TESTING

STATE OF MARYLAND - DEPARTMENT OF HEALTH AND MENTAL HYGIENE

HOWARD COUNTY HEALTH DEPARTMENT
ENVIRONMENTAL HEALTH SERVICES

P. O. BOX 476, ELLICOTT CITY, MARYLAND 21043
TELEPHONE: 465-8000, EXT. 356

DISTRICT 4th

DATE 10/9/73

3 BR - 1000 gal ST
4 BR - 1250 gal ST

Dry well is to have 125 ~~sq~~ sq. ft effective absorbent sidewall area below the first 4 ft of non-absorbent ground at original grade. Maximum depth of DW to be 11 ft. Locate dry well 140 ft from right side line and 170 ft from the 160.71' lot line (which is the "Old Baltimore Rd"), as seen when facing lot from the Old Baltimore Rd.

TO: THE COUNTY HEALTH OFFICER
ELLICOTT CITY, MARYLAND

I, HEREBY, APPLY FOR THE NECESSARY TEST IN ORDER TO CONSTRUCT (OR RECONSTRUCT) A SEWAGE DISPOSAL SYSTEM.

PROPERTY OWNER Nancy Valle

ADDRESS 4401 Roxbury Mill Road, Brookeville, Md. 20729 PHONE 966-2540

PROPERTY LOCATION:

SUBDIVISION _____ LOT NO. 2

ROAD AND DESCRIPTION Route 97, Glenwood, Maryland - left side of Roxbury Mill Road -

Go to stone house on top of hill. Mrs. Connors will meet you.

SIZE OF LOT 1.85 acres TYPE BLDG. 3 or 4 bedrooms
NUMBER OF BEDROOMS

IF NOT SINGLE RESIDENCE DESCRIBE _____

THE SYSTEM INSTALLED UNDER THIS APPLICATION IS ACCEPTABLE ONLY UNTIL PUBLIC FACILITIES BECOME AVAILABLE.

SIGNATURE OF APPLICANT /s/ Nancy Valle


APPROVED BY N.H. Zipp FOR D.W. DATE 5/8/74
(KIND OF SYSTEM)

REJECTED BY _____ FOR _____ DATE _____
(KIND OF SYSTEM)

HOLD PENDING FURTHER TESTS WWZ DATE 10/11/73

REASONS FOR REJECTION OR HOLDING final plat w certified test holes and proposed house site

THIS IS NOT A PERMIT

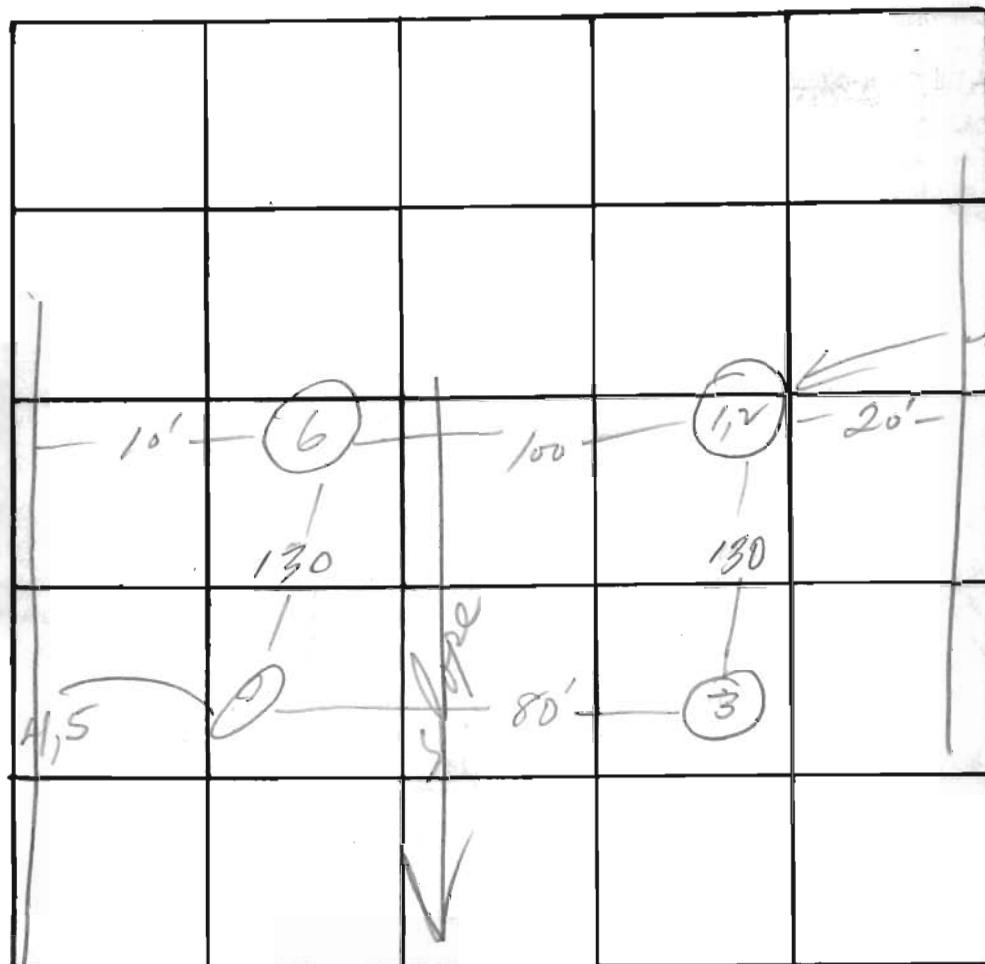

INDICATE NORTH. - NAME ADJOINING ROADWAY AS BASE LINE

RT 97



DATE	TEST NO.	DEPTH	PRE-WET		TEST - 1" DROP		TIME
			START	STOP	START	STOP	
10/10/73	1	5	2:38	2:44	2:44	2:50	6
	2	11 1/2	2:35	2:42	2:42	2:55	13
	3	9	Visual; shale rock @ 9' - good fr. 4'				
	4	3 1/2	3:27	3:31	3:31	3:35	4
	5	10 1/2	3:25	3:31	3:31	3:49	18
	6	11 1/2	Visual; sim to 142; dry				

REMARKS

TYPE OF SOIL

○ Indicates percolation test

MD. ROUTE 97

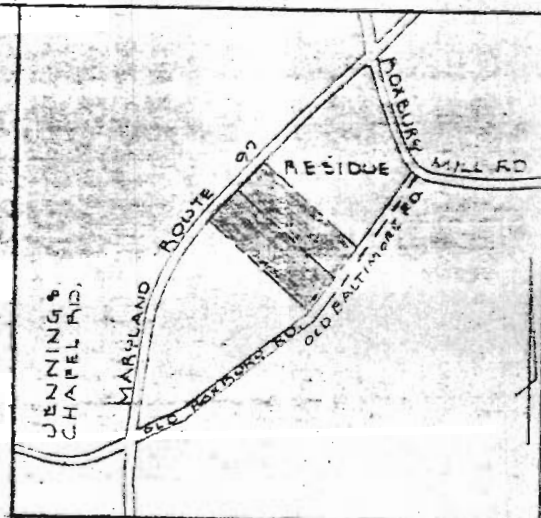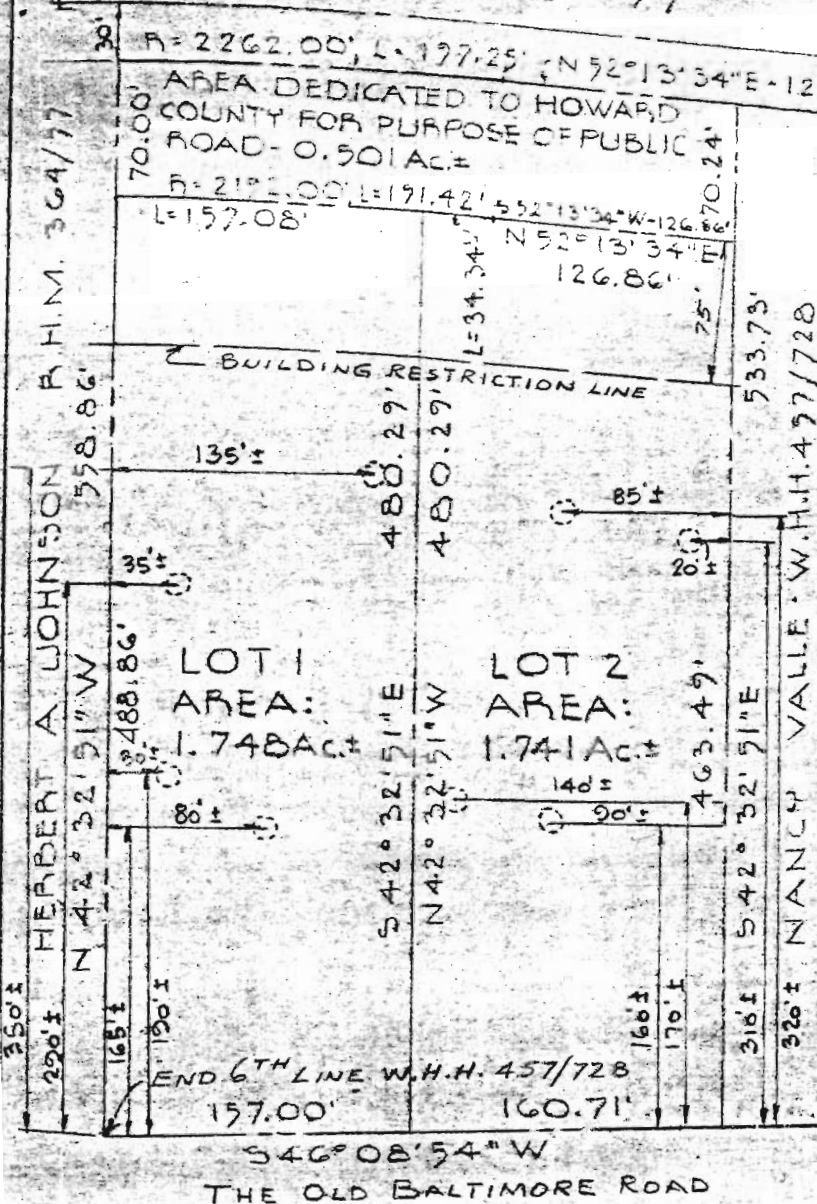

VICINITY MAP
SCALE = 1" = 800'

NOTES:

1. Total area of tract: 9.86 Ac.±
2. Number of Lots: 2
3. Total area within lots: 3.489 Ac.±
4. Property located on Tax Map No. 21, Parcel 70.
5. Deed reference: W.H.H. 457/728
6. Area of dedication: 0.501 Ac.±
7. Zoned R-40



William J. Roney

OWNER'S CERTIFICATE:

I, the undersigned, owner of the property shown hereon, my heirs or assigns, adopt this plan of subdivision and do hereby establish the building setback restriction line shown hereon in order to comply with the General Plan of Highways of Howard County, and including the land dedicated hereon for the widening of Maryland State Route 97.

Nancy Valle
Nancy Valle
1/22/74
Date

APPROVED: For private water & private sewerage system, Howard County Health Dept.

William J. Roney
Director
5/9/74
Date

APPROVED: Howard County Office of Planning and Zoning.


William J. Roney
Director
5/15/74
Date

PURDUM WESCHKE
ENGINEERS &
LAND SURVEYORS
677 PARK AVE.
MILCOTT CITY, MD

PROPERTY OF
NANCY VALLE

4th ELECTION DISTRICT HOWARD COUNTY, MD.
JANUARY, 1974
SCALE: 1" = 100'

MD. ROUTE 97

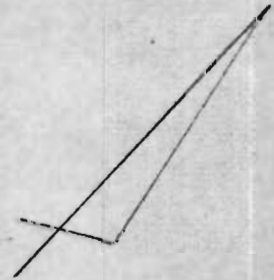

4th Election Dist. Howard County, Md.
JAN. 1974 Scale: 1"=100'

MD. ROUTE 97

S.R.C. PLAT NO. 9599

I.P. 2.2262.00' - L. 19725'
LCHC: N 49° 43' 40" E
197.19' I.P.

N 52° 13' 34" E

745.77'

2 ACRES
+-

1.85 ACRES
+-

9.860 AC.

N 42° 32' 51" W

530.86'

I.P.

I.P.

546° 08' 54" W - 700.78'
10' DIAT ROAD (FORMERLY OLD BALTIMORE ROAD)

CONC. BLOCK
FOUNDATION

2 STORY STONE

POACH...
160' x 102'
FRAME SHED

NAIL IN CONC.
@ FENCE CORNER

WEST SIDE
30' R/W

10' GRAVEL ROAD

S 15° 52' 57" E

Green

PROPERTY OF

NANCY VALLE

4TH ELECTION DISTRICT

HOWARD COUNTY, MD.

SEPTEMBER 21, 1971

SCALE: 1" = 100'

PURDUM & JESCHKE
ENGINEERS & LAND SURVEYORS
3697 PARK AVENUE
ELLCOTT CITY, MARYLAND 21043