



Building Permit Application

Howard County Maryland
Department of Inspections, Licenses and Permits
3430 Court House Drive
Permits: 410-313-2455
www.howardcountymd.gov

DILP 2016 JUL 8 AM 9:00

Date Received: _____

Permit No.: B16003090

Building Address: 5162 Green Bridge Rd
 City: DAYTON State: MD Zip Code: 21036
 Suite/Apt. #: _____ SDP/WP/BA #: _____
 Census Tract: _____ Subdivision: HUNGERFORD
 Section: _____ Area: _____ Lot: #2
 Tax Map: _____ Parcel: _____ Grid: _____
 Zoning: _____ Map Coordinates: _____ Lot Size: _____

Property Owner's Name: RICHARD LEWIS
 Address: 5162 Green Bridge Rd
 City: DAYTON State: MD Zip Code: 21036
 Phone: 783 216 7876 Fax: _____
 Email: _____

Existing Use: SFD
 Proposed Use: SFD w PROPANE TANK
 Estimated Construction Cost: \$ 8,000.00
 Description of Work: INSTALL (1) 500 GALLON
UG PROPANE TANK

Applicant's Name & Mailing Address, (If other than stated herein)
 Applicant's Name: _____
 Address: _____
 City: _____ State: _____ Zip Code: _____
 Phone: _____ Fax: _____
 Email: _____

Occupant or Tenant: _____
 Was tenant space previously occupied? Yes No
 Contact Name: _____
 Address: _____
 City: _____ State: _____ Zip Code: _____
 Phone: _____ Fax: _____
 Email: _____

Contractor Company: AMERICAS
 Contact Person: MICHAEL LARRIMORE
 Address: 8101 DARVEL RUN RD
 City: TESS VA State: MD Zip Code: _____
 License No.: 85321
 Phone: 410 5076083 Fax: _____
 Email: MICHAEL.LARRIMORE@AMERICAS.COM

Engineer/Architect Company: _____
 Responsible Design Prof.: _____
 Address: _____
 City: _____ State: _____ Zip Code: _____
 Phone: _____ Fax: _____
 Email: _____

Commercial Building Characteristics	Residential Building Characteristics	
Height:	<input type="checkbox"/> SF Dwelling <input type="checkbox"/> SF Townhouse	
No. of stories:	Depth	Width
Gross area, sq. ft./floor:	1 st floor:	
	2 nd floor:	
Area of construction (sq. ft.):	Basement:	
	<input type="checkbox"/> Finished Basement	
Use group:	<input type="checkbox"/> Unfinished Basement	
	<input type="checkbox"/> Crawl Space	
Construction type:	<input type="checkbox"/> Slab on Grade	
<input type="checkbox"/> Reinforced Concrete	No. of Bedrooms:	
<input type="checkbox"/> Structural Steel	Multi-family Dwelling	
<input type="checkbox"/> Masonry	No. of efficiency units:	
<input type="checkbox"/> Wood Frame	No. of 1 BR units:	
<input type="checkbox"/> State Certified Modular	No. of 2 BR units:	
	No. of 3 BR units:	
	Other Structure:	
	Dimensions:	
<input checked="" type="checkbox"/> Roadside Tree Project Permit	Footings:	
<input type="checkbox"/> Yes <input type="checkbox"/> No	Roof:	
Roadside Tree Project Permit #	<input type="checkbox"/> State Certified Modular	
	<input type="checkbox"/> Manufactured Home	

Utilities	
Water Supply	
<input type="checkbox"/> Public	
<input type="checkbox"/> Private	
Sewage Disposal	
<input type="checkbox"/> Public	
<input checked="" type="checkbox"/> Private	
Electric:	<input type="checkbox"/> Yes <input type="checkbox"/> No
Gas:	<input checked="" type="checkbox"/> Yes <input type="checkbox"/> No
Heating System	
<input checked="" type="checkbox"/> Electric	<input type="checkbox"/> Oil
<input type="checkbox"/> Natural Gas	<input type="checkbox"/> Propane Gas
<input type="checkbox"/> Other:	
Sprinkler System:	
<input type="checkbox"/> Yes	<input type="checkbox"/> No
Grading Permit Number:	
Building Shell Permit Number:	

THE UNDERSIGNED HEREBY CERTIFIES AND AGREES AS FOLLOWS: (1) THAT HE/SHE IS AUTHORIZED TO MAKE THIS APPLICATION; (2) THAT THE INFORMATION IS CORRECT; (3) THAT HE/SHE WILL COMPLY WITH ALL REGULATIONS OF HOWARD COUNTY WHICH ARE APPLICABLE THERETO; (4) THAT HE/SHE WILL PERFORM NO WORK ON THE ABOVE REFERENCED PROPERTY NOT SPECIFICALLY DESCRIBED IN THIS APPLICATION; (5) THAT HE/SHE GRANTS COUNTY OFFICIALS THE RIGHT TO ENTER ONTO THIS PROPERTY FOR THE PURPOSE OF INSPECTING THE WORK PERMITTED AND POSTING NOTICES.

Applicant's Signature: Donald W. Paquette
 Email Address: Donald.Paquette@americas.com
 Title/Company: Plant Manager

Print Name: Donald W. Paquette
 Date: 7/3/2016

Checks Payable to: DIRECTOR OF FINANCE OF HOWARD COUNTY
 PLEASE WRITE NEATLY & LEGIBLY
 -FOR OFFICE USE ONLY-

AGENCY	DATE	SIGNATURE OF APPROVAL
State Highways		
Building Officials		
PSZA (Zoning)		
PSZA (Engineering)		
Health	<u>8/5/16</u>	<u>Plant Manager</u>

Is Sediment Control approval required for issuance? Yes No
 CONTINGENCY CONSTRUCTION START

DPZ SETBACK INFORMATION
Front:
Rear:
Side:
Side St.:
All minimum setbacks met? <input type="checkbox"/> Yes <input type="checkbox"/> No
Is Entrance Permit Required? <input type="checkbox"/> Yes <input type="checkbox"/> No
Historic District? <input type="checkbox"/> Yes <input type="checkbox"/> No
Lot Coverage for New Town Zone:
SDP/Red-line approval date:

Filing Fee	\$	<u>10</u>
Permit Fee	\$	
Tech Fee	\$	
Excise Tax	\$	
PSFS	\$	
Guaranty Fund	\$	
Add'l per Fee	\$	
Total Fees	\$	
Sub-Total Paid	\$	
Balance Due	\$	
Check	#	

**COMPLETE THIS FORM WHEN DROPPING OFF ANY
CORRESPONDENCE AND/OR PLANS TO THE HOWARD COUNTY
DEPARTMENT OF INSPECTIONS, LICENSES AND PERMITS COUNTER:**

Date: 8/1/2010
To: Robert Freeman
(Person's Name and Division)
From: Amerigas 443-866-5611
(Your Name, Company Name and Telephone Number)
Subject: Project name Richard Lewis
Project site address 5162 Green Bridge Rd Dayton, MD
Permit # B16003090 SDP # 21036
Other information pertinent to this project _____

Please check the attachments below that you are submitting with this transmittal:

- Letter of response to address plan review comment letter
- Revised plans and/or revised details: When submitting for a complete re-review, **duplicate sets shall be submitted.**
- Letter Summarizing Changes
- Energy conservation calculations
- Copies of Revised site plan (be specific).
 - Health Department Request
 - DPZ/ DED Request
 - Applicant's Request
- Two sets of single family dwelling model plans to be placed on permanent file: Model name and/or # _____
- Other _____

Contact Person Information: (Required)

Donald W. Paquette
Please Print Name

Telephone No: 443-866-5611

E-Mail Address: donald.paquette@amerigas.com

PLEASE ASSURE ALL DOCUMENTS AND/OR REVISIONS ARE APPROPRIATELY SIGNED AND SEALED, IF NECESSARY, BY A LICENSED ARCHITECT OR ENGINEER. PLEASE BE ADVISED THAT INSUFFICIENT INFORMATION MAY RESULT IN THE DELAY OF REVIEW BY THE PLANS EXAMINER. THE DEPARTMENT OF INSPECTIONS, LICENSES AND PERMITS WILL CONTACT YOU IF THERE IS A PROBLEM. IN ADDITION, ONCE THE BUILDING PERMIT IS APPROVED BY THE PLAN REVIEW DIVISION AND ALL OTHER REQUIRED SIGNATORY AGENCIES, AND THE BUILDING PERMIT IS READY FOR ISSUANCE, THE PERMIT DIVISION WILL NOTIFY THE APPROPRIATE CONTACT PERSON FOR PERMIT PICK UP. ALL PERMIT STATUS INQUIRIES SHALL BE DIRECTED TO THE PERMIT DIVISION AT 410-313-2455. CODE RELATED QUESTIONS AND PLAN REVIEW INQUIRIES SHALL BE DIRECTED TO THE PLAN REVIEW DIVISION AT 410-313-2436. PLEASE ALLOW A MINIMUM OF FIVE (5) WORKING DAYS FOR ANY PLAN SUBMITTALS TO BE REVIEWED. THANK YOU.

Received by A. Thurman

cc: Plan Review
DPZ
DED

DILP 2016 AUG 1 AM 8:59

Approved 8/3/16 RJE

SITE
LOCAT

SEPTIC WELL 20'
20'

10,000 Sq.Ft. ±
SEPTIC EASEMENT
TO BE ABANDONED

20' x 38' POOL
W/AUTOCOVER

REVISED
Date: 8/18/16

Comments: B16003090
Per Health Dept

277 Ln.Ft., 48" HIGH
FENCE TO CODE
(BY OWNERS FENCE CONTRACTOR)

FILTER
LOCATION

1,280 Sq.Ft., POOL DECK AREA
(BY OWNERS DECK CONTRACTOR)

EXISTING
GARAGE

NOTE: NO ADJACENT WELLS
OR SEPTIC SYSTEMS ARE
WITHIN 100' OF THE
PROPOSED PROJECT


TRIANGLE ROAD

Notes:
(1) Distance from
well to proposed
tank = 120 FEET
(2) Distance from
Septic to proposed
tank = 120 FEET

NEW SEPTIC
RESERVE AREA
(APPROX
10,180 Sq.Ft.)

5162 Green Br.

PRIVATE WELL
& SEPTIC

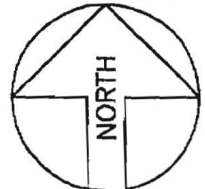

SITE PLAN

1"=80'

LOT 2

HUNGERFORD SUBDIVISION

SYMBOL LEGEND

- EXISTING GRADE
- ▨ PROPOSED SEPTIC DISPOSAL AREA
- ▭ EXISTING SEPTIC DISPOSAL AREA TO BE ABANDONED
- NEW PASSED PERC TEST
- EXISTING PASSED PERC TEST

10,000 Sq.Ft. ±
SEPTIC EASEMENT
TO BE ABANDONED

GENERATOR


Proposed
underground tank

LOT 2
189,050 Sq.Ft.
4.34 Ac.

provided by
home owner
Richard A Lewis
7/26/16

GREENBRIDGE ROAD

P
T
I
O

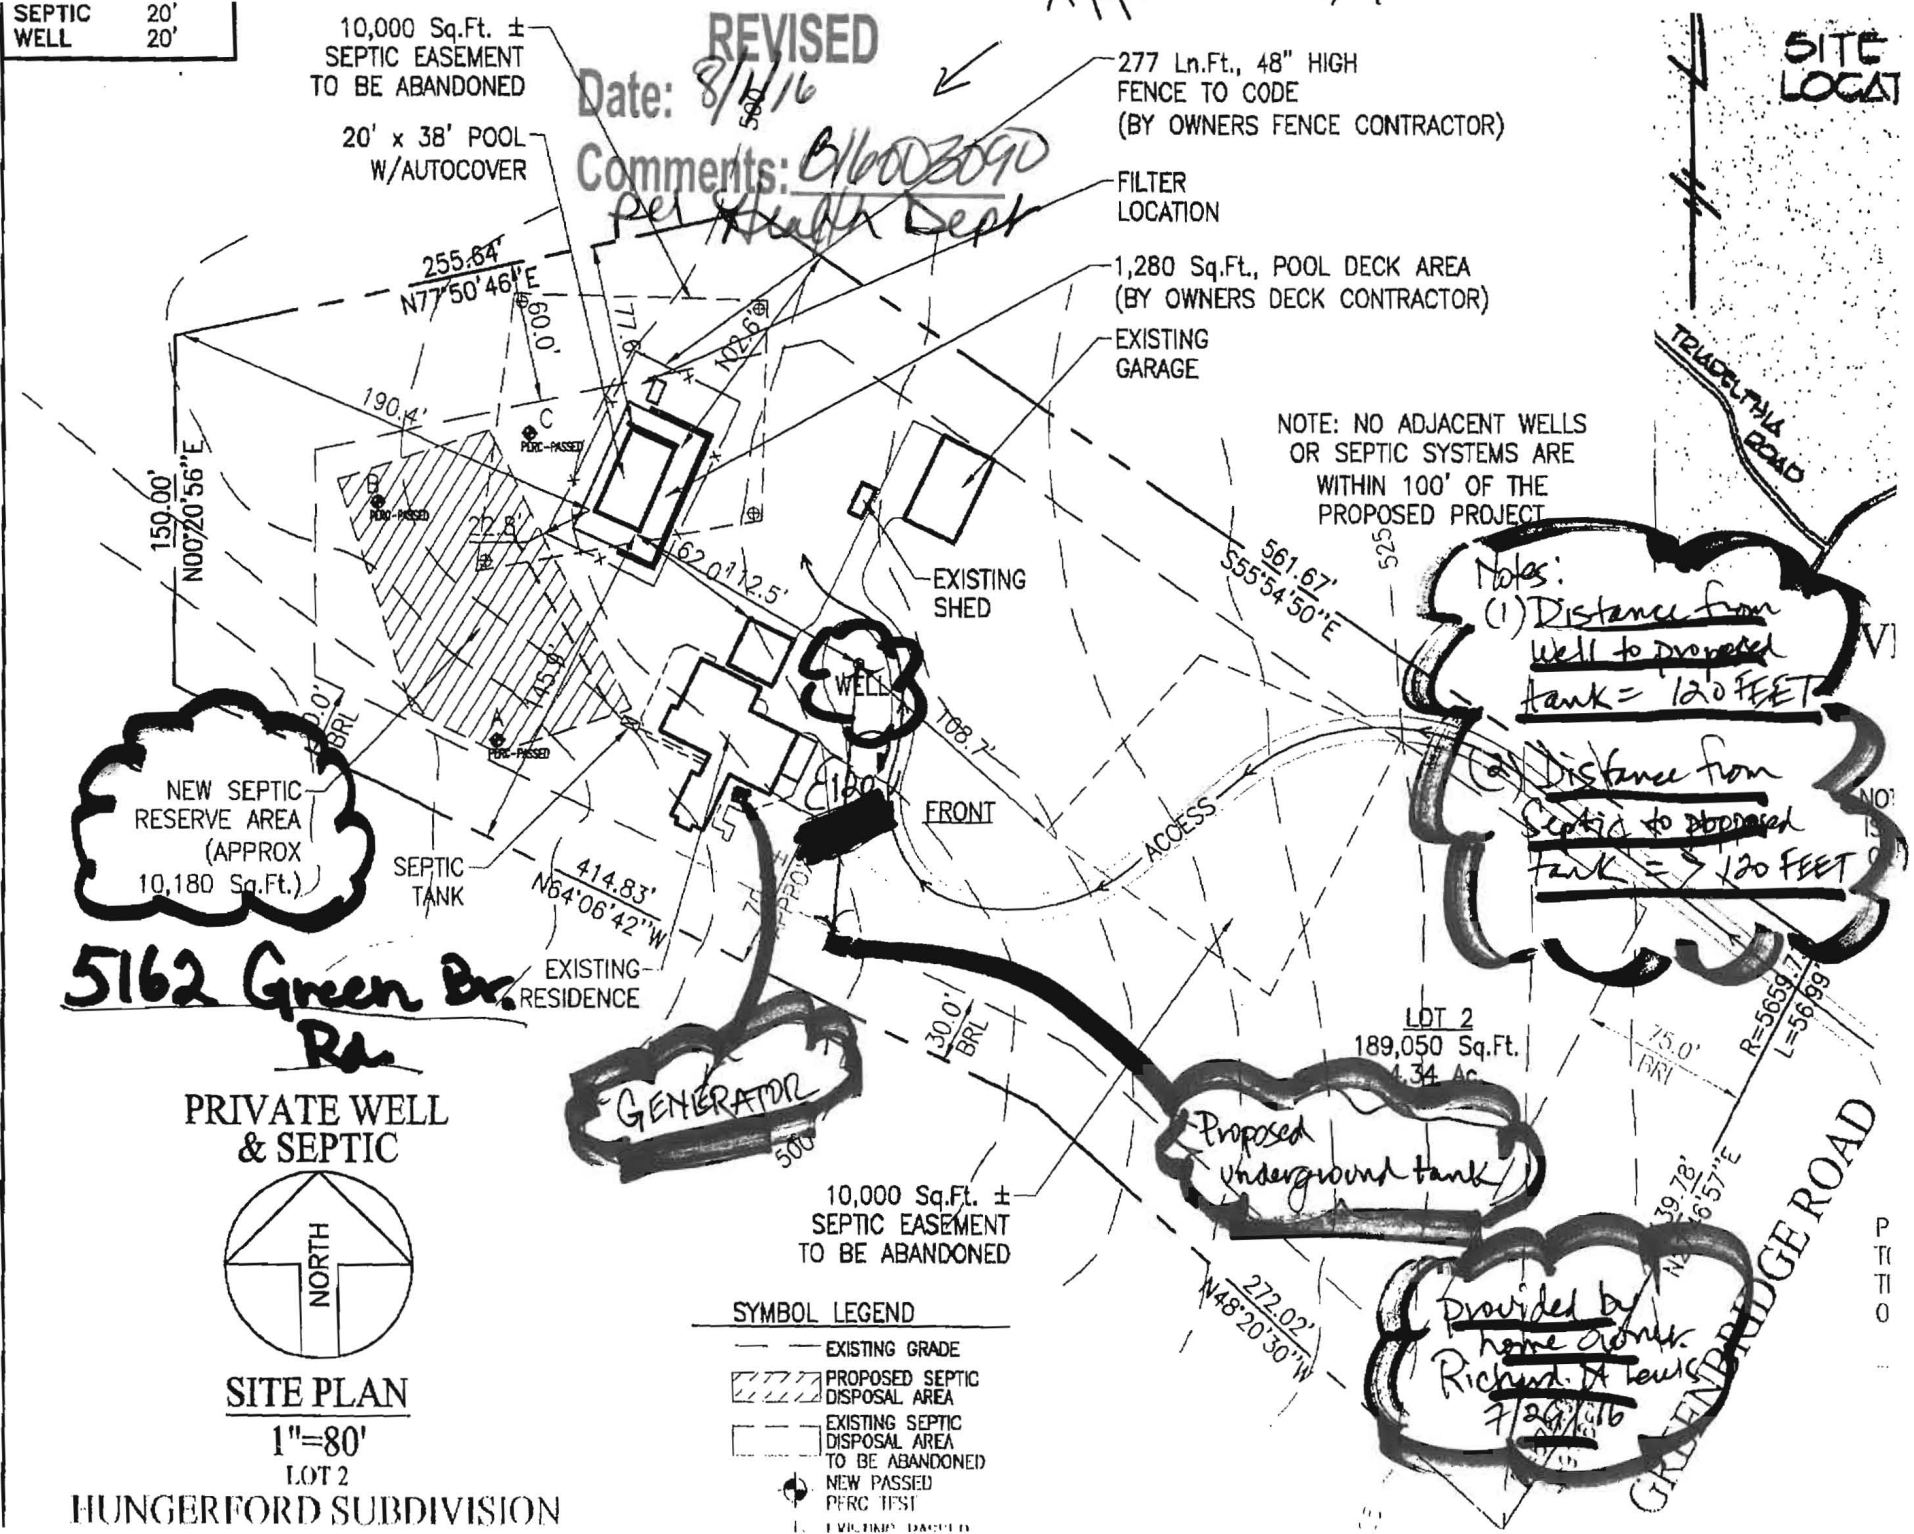

Approved 8/3/16

R/K

SEPTIC WELL 20' 20'

10,000 Sq.Ft. ± SEPTIC EASEMENT TO BE ABANDONED

20' x 38' POOL W/AUTOCOVER

REVISED Date: 8/11/16 Comments: Bilo... Per Health Dept.

277 Ln.Ft., 48" HIGH FENCE TO CODE (BY OWNERS FENCE CONTRACTOR)

FILTER LOCATION

1,280 Sq.Ft., POOL DECK AREA (BY OWNERS DECK CONTRACTOR)

EXISTING GARAGE

NOTE: NO ADJACENT WELLS OR SEPTIC SYSTEMS ARE WITHIN 100' OF THE PROPOSED PROJECT

SITE LOCAT


TRACELINE ROAD

Notes: (1) Distance from well to proposed tank = 120 FEET (2) Distance from Septic to proposed tank = 120 FEET

NEW SEPTIC RESERVE AREA (APPROX 10,180 Sq.Ft.)

5162 Green Br. Rd.

PRIVATE WELL & SEPTIC

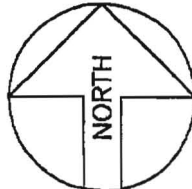

SITE PLAN

1"=80'

LOT 2

HUNGERFORD SUBDIVISION

SYMBOL LEGEND

- EXISTING GRADE
PROPOSED SEPTIC DISPOSAL AREA
EXISTING SEPTIC DISPOSAL AREA TO BE ABANDONED
NEW PASSED PERC TEST

10,000 Sq.Ft. ± SEPTIC EASEMENT TO BE ABANDONED

GENERATOR 500

LOT 2 189,050 Sq.Ft. 4.34 Ac

Proposed underground tank

Provided by home owner Richard A Lewis 7/26/16

GREENBRIDGE ROAD

P 1110

Approved 8/3/16

RJE

SEPTIC WELL 20' 20'

10,000 Sq.Ft. ± SEPTIC EASEMENT TO BE ABANDONED

20' x 38' POOL W/AUTOCOVER

REVISIED Date: 8/11/16

Comments: B/6003090 Per Health Dept.

277 Ln.Ft., 48" HIGH FENCE TO CODE (BY OWNERS FENCE CONTRACTOR)

FILTER LOCATION

1,280 Sq.Ft., POOL DECK AREA (BY OWNERS DECK CONTRACTOR)

EXISTING GARAGE

NOTE: NO ADJACENT WELLS OR SEPTIC SYSTEMS ARE WITHIN 100' OF THE PROPOSED PROJECT

SITE LOCAT




Notes: (1) Distance from well to proposed tank = 120 FEET (2) Distance from Septic to proposed tank = 120 FEET

NEW SEPTIC RESERVE AREA (APPROX 10,180 Sq.Ft.)

5162 Green Br.

PRIVATE WELL & SEPTIC

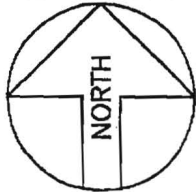

SITE PLAN

1"=80'

LOT 2

HUNGERFORD SUBDIVISION

SYMBOL LEGEND

- EXISTING GRADE
PROPOSED SEPTIC DISPOSAL AREA
EXISTING SEPTIC DISPOSAL AREA
TO BE ABANDONED
NEW PASSED PERC TEST
EXISTING PASSED PERC TEST

10,000 Sq.Ft. ± SEPTIC EASEMENT TO BE ABANDONED

GENERATOR

Proposed underground tank

provided by home owner Richard A Lewis 7/20/16

LOT 2 189,050 Sq.Ft. 4.34 Ac

GREENBRIDGE ROAD

P T I T O