


B 1	6077	SEQUENCE NO (MDE USE ONLY)	STATE OF MARYLAND APPLICATION FOR PERMIT TO DRILL WELL please type	STATE PERMIT NUMBER <u>HO-95-0593</u> <small>fill in this form completely</small>
Date Received (APA) <u>12/13/2006</u>		OWNER INFORMATION		
8 <u>12</u> / <u>13</u> / <u>2006</u>				
15 <u>Gill, Stephen</u>		21 <u>Howard</u>		
15 Last Name Owner First Name 34		8 COUNTY 21		
36 <u>7166 Mink Hollow RD</u>		23 SUBDIVISION 42		
36 Street or RFD 55		SECTION [ ] LOT [ ]		
57 <u>Highland Md</u>		44 45 48 50		
57 Town 70 State 72 Zip 76		52 NEAREST TOWN 71		
DRILLER INFORMATION		MILES FROM TOWN (enter 0 if in town) <u>5</u> M I		
78 <u>Allen Compton MS D 009</u>		73 76 77 78		
78 Driller's Name License No. 81		B 3		
81 <u>Fogles well Drilling</u>		1 2		
81 Firm Name		DIRECTION OF WELL FROM TOWN (CIRCLE BOX)		
81 <u>580 obrecht RD</u>		11 <u>7166 Mink Hollow Rd</u> 30		
81 Address		ON WHICH SIDE OF ROAD (CIRCLE APPROPRIATE BOX)		
81 <u>Allen Compton 12-13-06</u>		34 <u>800</u> 37		
81 Signature Date		DISTANCE FROM ROAD ENTER FT OR MI 38 39		
B 2		TAX MAP: <u>40</u> BLK: <u>1</u> PARCEL <u>10</u>		
1 2		WELL INFORMATION		
APPROX. PUMPING RATE (GAL PER MIN.)		APPROX. PUMPING RATE <u>5</u>		
8 12		8 12		
AVERAGE DAILY QUANTITY NEEDED (GAL PER DAY)		AVERAGE DAILY QUANTITY NEEDED <u>500</u>		
14 20		14 20		
USE FOR WATER (CIRCLE APPROPRIATE BOX)				
<input checked="" type="checkbox"/> DOMESTIC POTABLE SUPPLY & RESIDENTIAL IRRIGATION				
<input type="checkbox"/> FARMING (LIVESTOCK WATERING & AGRICULTURAL IRRIGATION)				
<input type="checkbox"/> INDUSTRIAL, COMMERCIAL, DEWATERING				
<input type="checkbox"/> PUBLIC WATER SUPPLY WELL				
<input type="checkbox"/> TEST, OBSERVATION, MONITORING				
<input type="checkbox"/> GEO-THERMAL				
NOT TO BE FILLED IN BY DRILLER HEALTH DEPARTMENT APPROVAL				
<u>Howard 13 A13958</u>				
COUNTY NAME COUNTY NO.				
STATE SIGNATURE INSERT S → 41				
DATE ISSUED <u>12/13/2006</u> <u>Brian Baker</u> <u>12/13/2007</u>				
43 <u>12/13/2006</u> 48 CO SIGNATURE EXP. DATE				
NORTH GRID <u>489</u> 000 EAST GRID <u>802</u> 000				
50 55 57 63				
APPROXIMATE DEPTH OF WELL <u>300</u> FEET		SHOW MAJOR FEATURES OF BOX & LOCATE WELL WITH AN X		
24 26		SOURCES OF DRILLING WATER		
APPROXIMATE DIAMETER OF WELL <u>6</u> INCH		1.		
NEAREST INCH		2.		
		3.		
METHOD OF DRILLING (circle one)		WRITE THE BOX NUMBER FROM THE MAP HERE		
BORED (or Augered) JETTED Jetted & DRIVEN		E <u>4800</u>		
<input checked="" type="checkbox"/> AIR-ROTARY AIR-PERCussion ROTARY (Hydraulic Rotary)		N <u>8000</u>		
<input type="checkbox"/> CABLE REVERSE-ROTARY DRIVE-POINT		DRAW A SKETCH BELOW SHOWING LOCATION OF WELL IN RELATION TO NEARBY TOWNS AND ROADS AND GIVE DISTANCE FROM WELL TO NEAREST ROAD JUNCTION		
other _____				
REPLACEMENT OR DEEPEMED WELLS (CIRCLE APPROPRIATE BOX)				
<input type="checkbox"/> THIS WELL WILL NOT REPLACE AN EXISTING WELL				
<input checked="" type="checkbox"/> THIS WELL WILL REPLACE A WELL THAT WILL BE ABANDONED AND SEALED				
<input type="checkbox"/> THIS WELL WILL REPLACE A WELL THAT WILL BE USED AS A STANDBY-CONTACT LOCAL APPROVING AUTHORITY FOR POLICY ON STANDBY WELLS				
<input type="checkbox"/> THIS WELL WILL DEEPEM AN EXISTING WELL				
PERMIT NUMBER OF WELL TO BE REPLACED OR DEEPEMED (IF AVAILABLE) 41 _____ 52				
Not to be filled in by driller (MDE OR COUNTY USE ONLY)				
APPROP. PERMIT NUMBER _____ G _____				
PERMIT No. <u>HO-95-0593</u>				
70 71 72 73 74 75 76 77 78 79				
SPECIAL CONDITIONS				
<small>NOTE - APPROVING AUTHORITY SHOULD USE SEPARATE SHEET IF NEEDED.</small>				

SITE INSPECTION SHEET

OWNER: Stephen and Carmen Gill PHONE #: \_\_\_\_\_  
ADDRESS: 7166 Mink Hollow Road CONTRACTOR: Fogles/Compton  
WELL TAG #: \_\_\_\_\_  
SUBDIVISION: \_\_\_\_\_ LOT: \_\_\_\_\_ COUNTY #: \_\_\_\_\_  
PROPOSAL: Well Currently Has Insufficient Yield - Want to Drill Replacement

LOCATION DIAGRAM

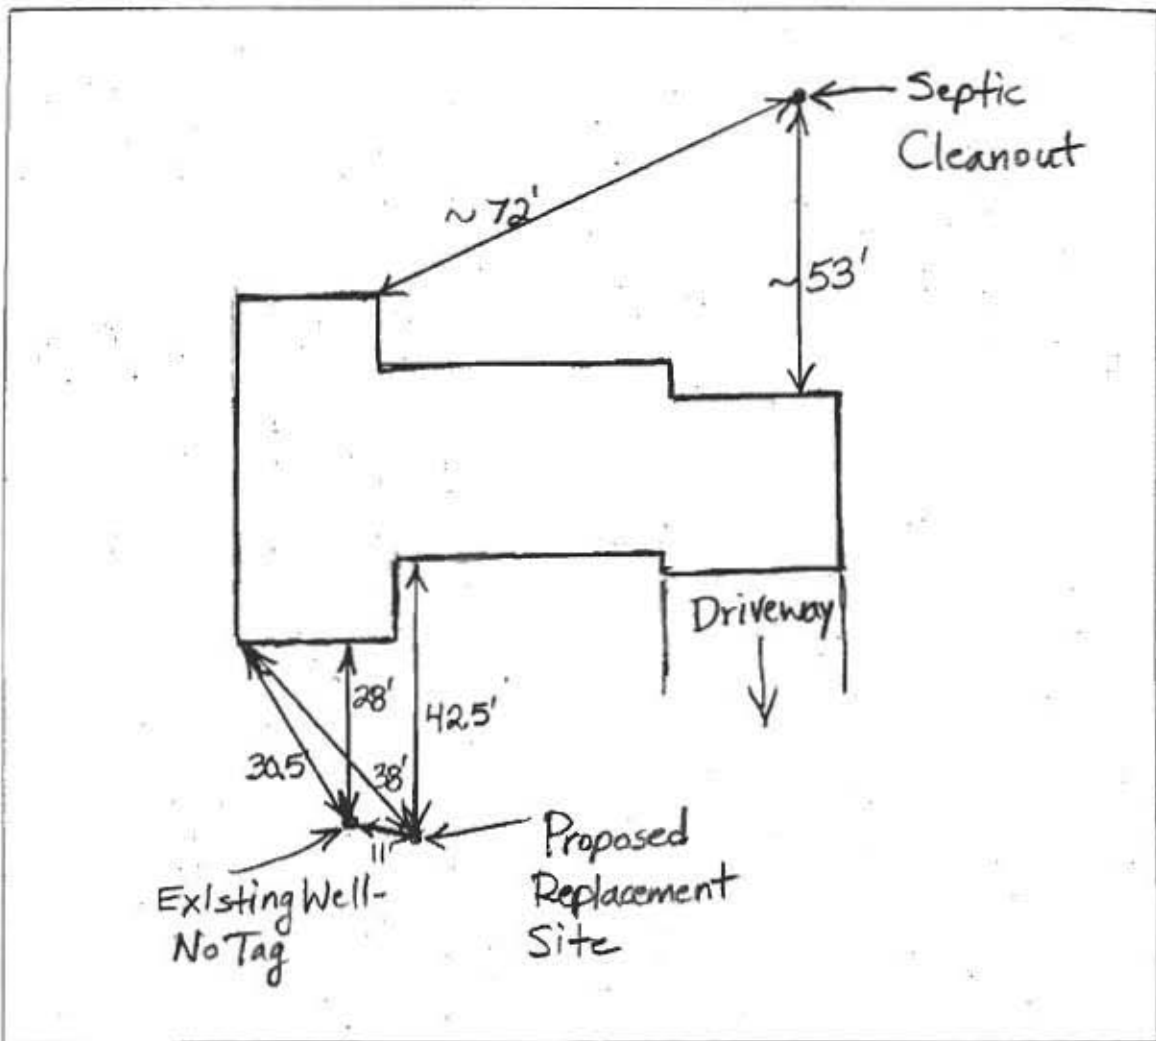

COMMENTS: Seal Old Well

DATE: 12/13/06 INSPECTOR: Bruce Baker



