

Bureau of Environmental Health

8930 Stanford Boulevard, Columbia, MD 21045

Main: 410-313-2640 | Fax: 410-313-2648

TDD 410-313-2323 | Toll Free 1-866-313-6300

www.hchealth.org

Facebook: www.facebook.com/hocohealth

Twitter: HowardCoHealthDep

Maura J. Rossman, M.D., Health Officer

DEMOLITION REQUEST FORM

Information of Property to be Demolished:

EDIN SEJMEOVIC
Current Owner's Name

12934 Folly Quarter Rd ELLICOTT CITY MD 21042
Property Address

Subdivision (if applicable)

Lot #

All Prior Owners' Names (if requested or known)

22 03-298264 382189
Tax Map Parcel # Tax ID #

DPL require DEMO in ORDER TO BUILD NEW HOUSE
Purpose/Reason for Demolition

NEW HOUSE
Future plans of property after demo (i.e. subdivision, parking lot, re-build new house, etc...)

If a subdivision, SDP# Has the structure(s) been deemed unsafe by DILP YES X NO

UTILITY RECORDS:

Property currently connected to public water YES X NO

Property currently connected to public sewer YES X NO

Does the property currently have any wells and/or septic systems X YES NO

Explain: Reuse existing well for new house
DEMO SEPTIC

\*Note: Any wells and/or septic systems that are to remain may require an approved percolation certification plan under Howard County Code Sec. 3.805

\*Note: Any septic systems that are to be abandoned must be done by a septic contractor with documentation of the process.

\*Note: All abandoned wells are to be sealed by a well driller licensed by the Maryland State Board of Well Drillers COMAR Sec 26.04.04.11 Abandonment Standards D (3)

COMMENTS:


EDIN SEJMEOVIC
Applicant's Name (please print)

443-554-4958
Applicant's Phone #

EdinSejmenovic@hotmail.com
Applicant's Email

Applicant's Fax #
2/19/18
Date

Edin Sejmenovic
Applicant's Signature

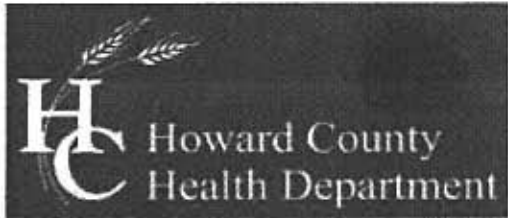

Bureau of Environmental Health

8930 Stanford Boulevard, Columbia, MD 21045

Main: 410-313-2640 | Fax: 410-313-2648

TDD 410-313-2323 | Toll Free 1-866-313-6300

www.hchealth.org

Facebook: www.facebook.com/hocohealth

Twitter: HowardCoHealthDep

Maura J. Rossman, M.D., Health Officer

DEMOLITION REQUEST FORM

Information of Property to be Demolished:

EDIN SEJMOVIC
Current Owner's Name

12934 FOLLY QUARTER RD ELLICOTT CITY MD 21042
Property Address

Subdivision (if applicable)

Lot #

22 03-298264 382189

All Prior Owners' Names (if requested or known)

Tax Map

Parcel #

Tax ID #

DPL REQUIRE DEMO IN ORDER TO BUILD NEW HOUSE
Purpose/Reason for Demolition

NEW HOUSE

Future plans of property after demo (i.e. subdivision, parking lot, re-build new house, etc...)

If a subdivision, SDP# \_\_\_\_\_ Has the structure(s) been deemed unsafe by DILP \_\_\_ YES \_\_\_ X NO

UTILITY RECORDS:

Property currently connected to public water \_\_\_ YES \_\_\_ X NO

Property currently connected to public sewer \_\_\_ YES \_\_\_ X NO

Does the property currently have any wells and/or septic systems \_\_\_ X YES \_\_\_ NO

Explain: REUSE EXISTING WELL FOR NEW HOUSE
DEMO SEPTIC

\*Note: Any wells and/or septic systems that are to remain may require an approved percolation certification plan under Howard County Code Sec. 3.805

\*Note: Any septic systems that are to be abandoned must be done by a septic contractor with documentation of the process.

\*Note: All abandoned wells are to be sealed by a well driller licensed by the Maryland State Board of Well Drillers COMAR Sec 26.04.04.11 Abandonment Standards D (3)

COMMENTS:

EDIN SEJMOVIC
Applicant's Name (please print)

443-554-4958
Applicant's Phone #

EdinSejmovic@hotmail.com
Applicant's Email

Applicant's Fax #

Edin Sejmovic
Applicant's Signature

2/19/18
Date

# PERMIT

P. 1233

A. 1231

SEWAGE DISPOSAL SYSTEM

MARYLAND STATE DEPARTMENT OF HEALTH

HOWARD COUNTY

03-298264

ELLCOTT CITY

DISTRICT 3

INDEXED

DATE 1/20/67

INDEXED

Walter A. Shank IS PERMITTED TO INSTALL X ALTER

ADDRESS Folly Quarter Rd., Ellicott City, Md. PHONE 331-2631

A SEWAGE DISPOSAL SYSTEM LOCATED AT \_\_\_\_\_

SUBDIVISION \_\_\_\_\_ ROAD 12934 Folly Quarter Rd. / Old Rolling Road LOT 8

PROPERTY OWNER Walter A. Shank - Robert Watson

ADDRESS \_\_\_\_\_

SPECIFICATIONS - 3 bedrooms

DRAIN FIELD \_\_\_\_\_ DEPTH \_\_\_\_\_ FEET, BOTTOM AREA \_\_\_\_\_ SQ. FT.

SEEPAGE PITS \_\_\_\_\_ ABSORBENT SIDE-WALL AREA \_\_\_\_\_ SQ. FT.

SEPTIC TANK CAPACITY 720 GALLONS

*Add on Garage*  
BLDG. PERMIT SIGNED  
AND RETURNED 4-13-96  
*Serial # 64310*

FOR GARBAGE GRINDER, INCREASE DISPOSAL AREA 225 & TANK CAPACITY 225.

OTHER Hand Dig 20 x 25 ft.

located 65 ft. from front lot line and 160 ft. from right side lot line as shown when facing lot from Old Rolling Rd. Maximum depth below original grade is 12 ft.

PERMIT VOID AFTER THREE YEARS. *Corrected 4/10/67 - JHK*


PLANS APPROVED BY J. H. Kalsbeke DATE 1/23/67

FILL SEPTIC TANK AND DISTRIBUTION BOX WITH WATER BEFORE CALLING FOR AN INSPECTION. COVER NO WORK UNTIL INSPECTED AND APPROVED.

NEITHER THE HOWARD COUNTY COMMISSIONERS NOR THE HEALTH DEPARTMENT IS RESPONSIBLE FOR THE SUCCESSFUL OPERATION OF ANY SYSTEM.

## NOTIFY THE HEALTH DEPARTMENT 48 HOURS BEFORE EXCAVATIONS ARE TO BE BACK FILLED.

*576557A*

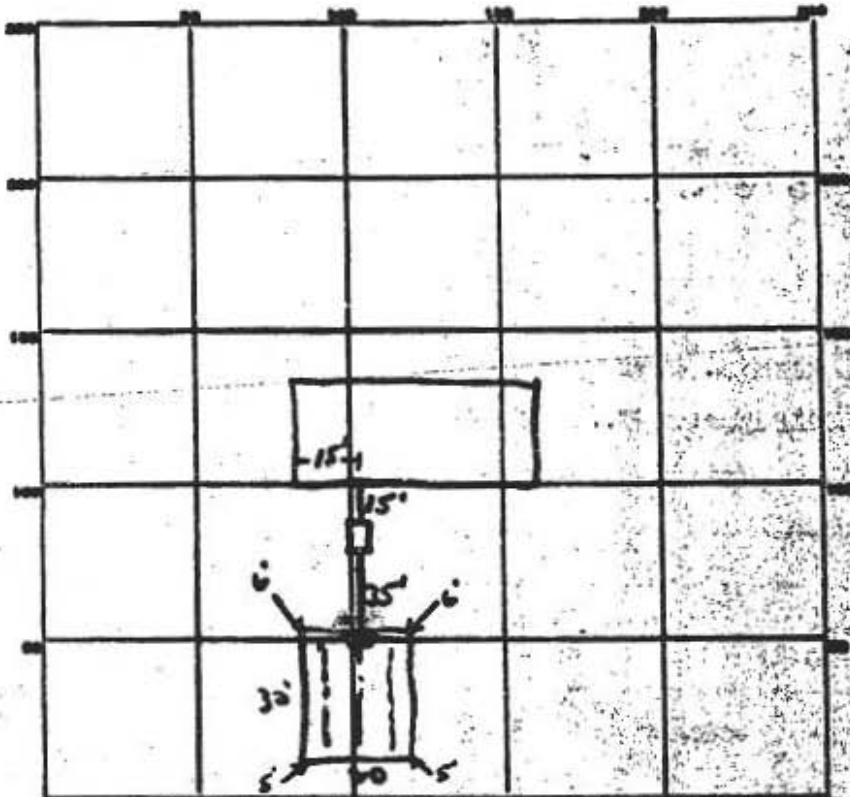

MINIMUM SPACING - 5 FEET ADJOINING HIGHWAY OR SIDE WALK

Old Rolling Rd

PERMIT CARD OK

SEPTIC TANK, LEVEL OK

CLEANOUTS OK

DISTRIBUTION BOX, LEVEL OK

L. Bed

TRENCH DEPTH 6 FT. TRENCH WIDTH 27 FT.

GRAVEL DEPTH 36 IN. TOTAL LENGTH 34 FT.

NUMBER OF TRENCHES 1 TOTAL BOTTOM AREA 744 sq ft

34  
27  
74  
36  
74

SEEPAGE PITS, INSIDE DIAMETER \_\_\_\_\_ FT. DEPTH BELOW INLET \_\_\_\_\_ FT.

ABSORBENT AREA \_\_\_\_\_ SQ. FT.

REMARKS \_\_\_\_\_

\_\_\_\_\_  
\_\_\_\_\_  
\_\_\_\_\_  
\_\_\_\_\_

DATE SYSTEM APPROVED 4/13/67

INSPECTOR JH Kolman