

HOWARD COUNTY HEALTH DEPARTMENT
APPLICATION-SEWAGE DISPOSAL TESTING

Application No. 40

District 6c

Date 11 August 1958

TO: THE COUNTY HEALTH OFFICER
Ellicott City, Maryland

I, hereby, apply for the necessary tests in order to construct (or re-construct) a sewage disposal system.

PROPERTY OWNER Harry and Gladys Latt

Address Avondale Street Laurel Md. Phone _____

LOCATION OF PROPERTY: Subdivision _____ Lot No. _____

Road Corner of Bryant ave and 216, E. Side

OCCUPANT OF PROPERTY _____

Address _____ Phone _____

PERSON TO CONSTRUCT PLANT John G. Hoffmann Jr.

Address Box 540A Scaggville Rd. Laurel Md. Phone Pky, 5-3142

SIZE OF LOT 150X 180

TYPE OF BUILDING TO BE SERVED Residence

SYSTEM TO SERVE _____ PEOPLE _____ NO. OF BEDROOMS 4

PERMIT NUMBER _____ FEE _____

SIGNATURE OF APPLICANT John C. Hoffmann Jr.


APPROVED BY William W. Berlin DATE 8/14/58

REJECTED BY _____ DATE _____

REASONS FOR REJECTION _____

FOR TEST FINDINGS, SEE OTHER SIDE.

440

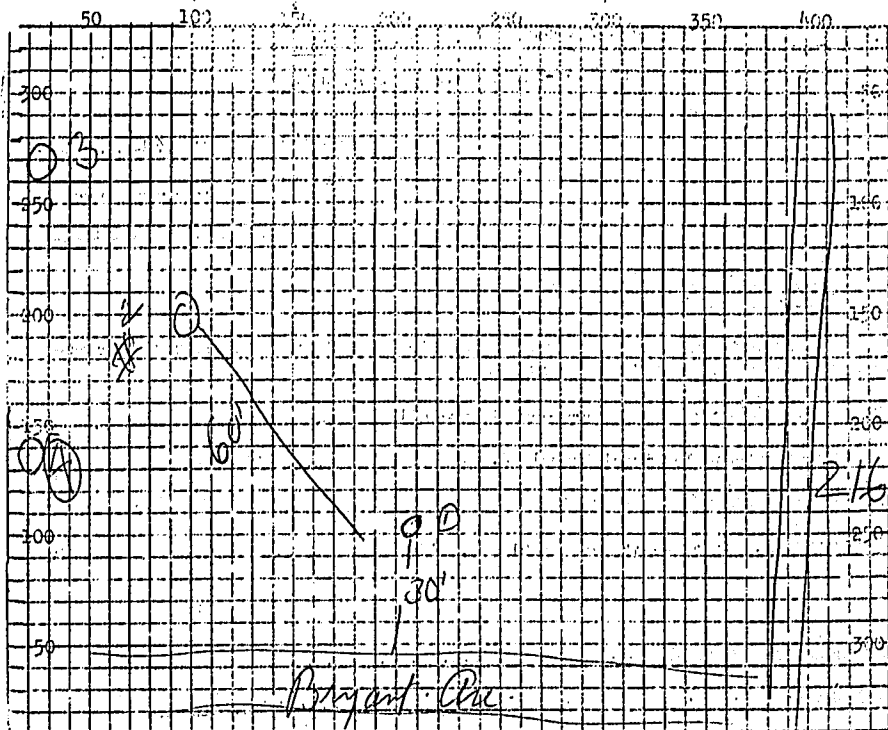

Above: Sketch property showing dimensions, location and numbers of test holes distance to adjoining wells and slope of ground. Each square = 10 ft.

LAST PREVIOUS RAIN _____

RAINFALL FOR YEAR _____

DATE	TEST NO.	TEST DEPTH	PRE-WET 6"		TOTAL		
			START	STOP	START	STOP	
8/14	# 1	3	1:35	1:46	1:46	2"	25'
	4	3	1:36	1:46	1:46	2"	25'

SOIL AUGER FINDING: _____

TEST CONDUCTED BY _____

DATE 8/14/58

ALSO, PRESENT _____

SIGNATURE

John C. Hoffman Jr.

REMARKS: _____

TITLE _____