

HOWARD COUNTY HEALTH DEPARTMENT
PERMIT-SEWAGE DISPOSAL SYSTEM

File

INDEXED

Permit No. A 40 P-23
District 6
Date 8-15-58

Reeley, Richard

is permitted to

Install

Alter

a sewage disposal system located: Corner of Bryant Avenue and 216 - East side

Property Owner Harry and Gladys Lett

Address Avondale Street, Laurel

Location _____

SPECIFICATIONS:

TILE FIELDS Length Width Depth Bottom area 3 ft. 333 sq. ft.

SEEPAGE PITS Number Inside Diam. Depth below inlet

Absorbent area

SEPTIC TANK CAPACITY 500 gallon

OTHER: _____

FEE \$1.00


PLANS APPROVED BY: Milton M. Beekman, Sanitarian

Fill septic tank and distribution box with water before calling for inspection.

No work is to be covered until inspected and approved.

Neither the Howard County Commissioners nor the Health Department is responsible for the successful operation of any installation.

A40

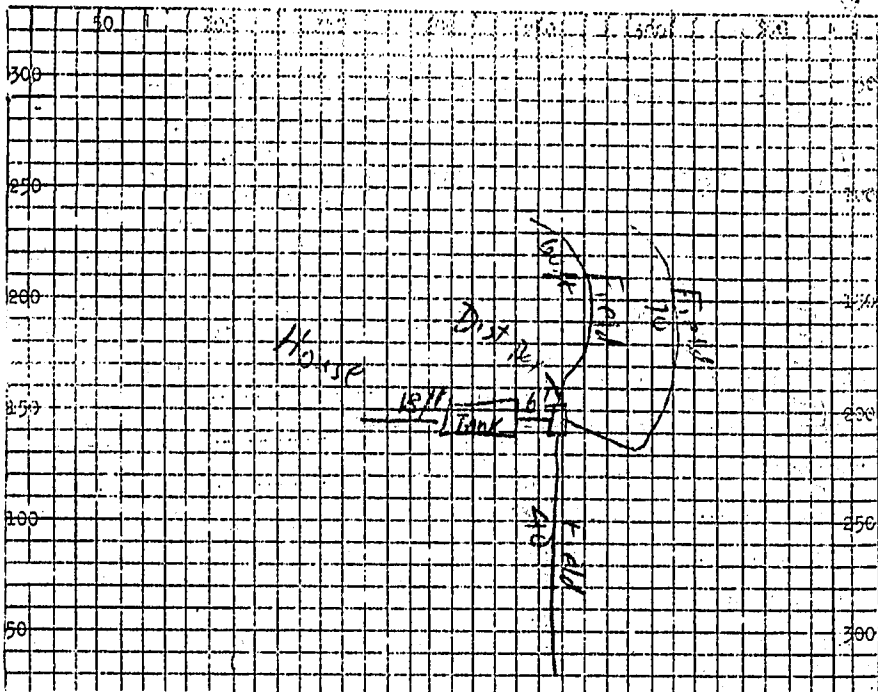

Each square = 10 feet.

Locate system with reference to house and adjoining properties & Perc. Tests.

PERMIT CARD 500 gal tank 3335411

Septic Tank 750 gal Distance from Ground Surface Filled

Level Cleanouts Concrete 6' feet apart

Distribution Box: Filled Level

Tile Field:

Depth of Tile

Width of Trenches 1 1/2'

Grade Board

Total Length 170'

Gravel Depth

Fall

No. of Trenches

Backfill on Hand

Seepage Pit:

Inside Diameter

Depth below inlet

Remarks:

Impacted soils

400' better area

Fields Not of equal Length

Date System Approved and Ready for Covering

Inspector *RB*

7x6 x 3 1/2
42
25
10
6
97

170
25
550
190
425