

Preliminary

APPLICATION

21261

SEWAGE DISPOSAL TESTING

STATE OF MARYLAND - DEPARTMENT OF HEALTH AND MENTAL HYGIENE

HOWARD COUNTY HEALTH DEPARTMENT
ENVIRONMENTAL HEALTH SERVICES
P. O. BOX 476, ELLICOTT CITY, MARYLAND 21043
TELEPHONE 465-9000, EXT. 356

Septic Tank { 1-3 bedrooms / 1000 gallon
4 bedrooms / 1250 gallon
DATE 3/24/75

*Very well to have 125 sq ft.
effective absorbent leeward area per bedroom
below vent to inlet to be 4' below original grade
and maximum depth 12'. Location: 155' from
right property line and 230' from front property line
when facing lot from secondary lane. See hole
(1+2)*

TO THE COUNTY HEALTH OFFICER,
ELLICOTT CITY, MARYLAND

I, HEREBY, APPLY FOR THE NECESSARY TEST IN ORDER TO CONSTRUCT (OR RECONSTRUCT) A SEWAGE DISPOSAL SYSTEM.

PROPERTY OWNER John Mikolasko and A. A. Krometis

ADDRESS 2205 Foxley Road, Timonium, Md. 21093

PHONE 252-3478
WORK: 765-2930 (Westinghouse)

PROPERTY LOCATION

SUBDIVISION (Rose Mary Estates)

LOT NO. 7

ROAD AND DESCRIPTION 3442 Rosemary Lane

SIZE OF LOT 5.043 acres

TYPE BLDG. (3) or 4 bedrooms
NUMBER OF BEDROOMS

IF NOT SINGLE RESIDENCE DESCRIBE _____

THE SYSTEM INSTALLED UNDER THIS APPLICATION IS ACCEPTABLE ONLY UNTIL PUBLIC FACILITIES BECOME AVAILABLE.

SIGNATURE OF APPLICANT /s/ John Mikolasko

BLDG. PERMIT SIGNED
AND RETURNED 4/22/77
31256

APPROVED BY C. H. Stecker FOR Ray Well DATE 8/1/90

REJECTED BY _____ FOR _____ DATE _____


HOLD PENDING FURTHER TESTS _____ DATE _____

REASONS FOR REJECTION OR HOLDING 6/25 Certified plat with the hole
OK

THIS IS NOT A PERMIT

505'

A. 21261

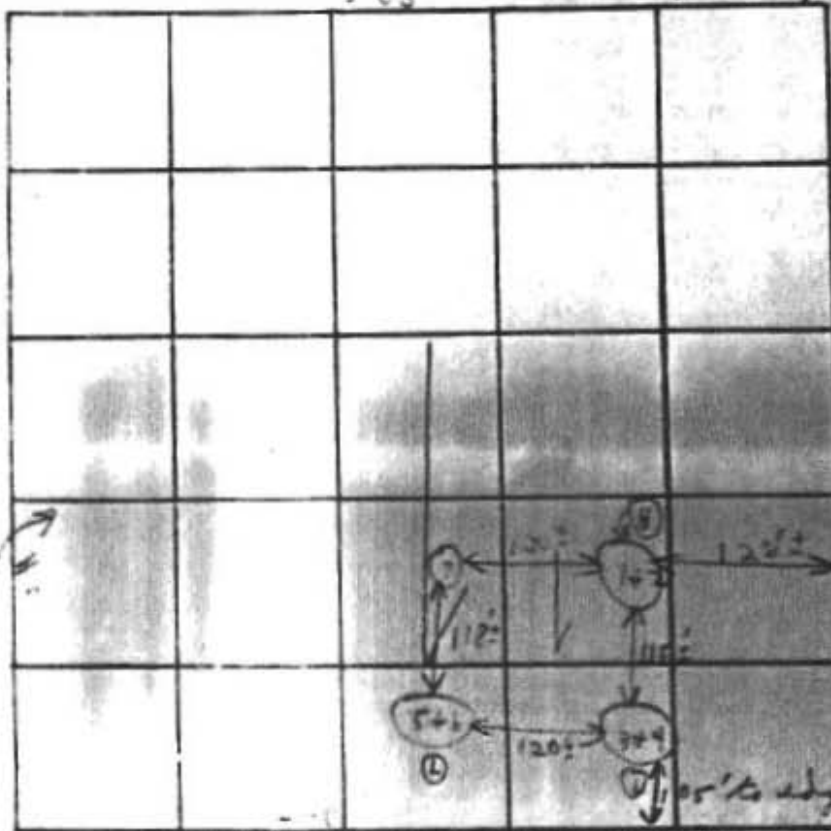

INDICATE NORTH - NAME ADJOINING ROADWAY AS BASE LINE

Rosemary Lane

DATE	TEST NO	DEPTN	PRE-WET		TEST - 1" DROP		TIME
			START	STOP	START	STOP	
1/27/75	1	4'	10:57	11:00	11:00	11:02	6mm
	2	12'	10:57	11:01	11:01	11:10	9mm
	3	5'	11:00	11:02	11:02	11:06	4mm
	4	10 1/2'	11:00	11:02	11:02	11:11	9mm
	5	2'	11:07	11:09	11:09	11:12	3mm
	6	12'	11:12	11:15	11:15	11:23	8mm
	7	10 1/2'	Vertical secula		To 1-2		
						65	41

Sandy
below clay

125 g soil
4"

9mm


REMARKS Open Cold

TYPE OF SOIL _____

TESTED BY C. G. S. ALSO PRESENT: J. French
Harold S.

Part of Appas Dec '82
 Plotted as 62871
 16' x 27'

LOT 8A

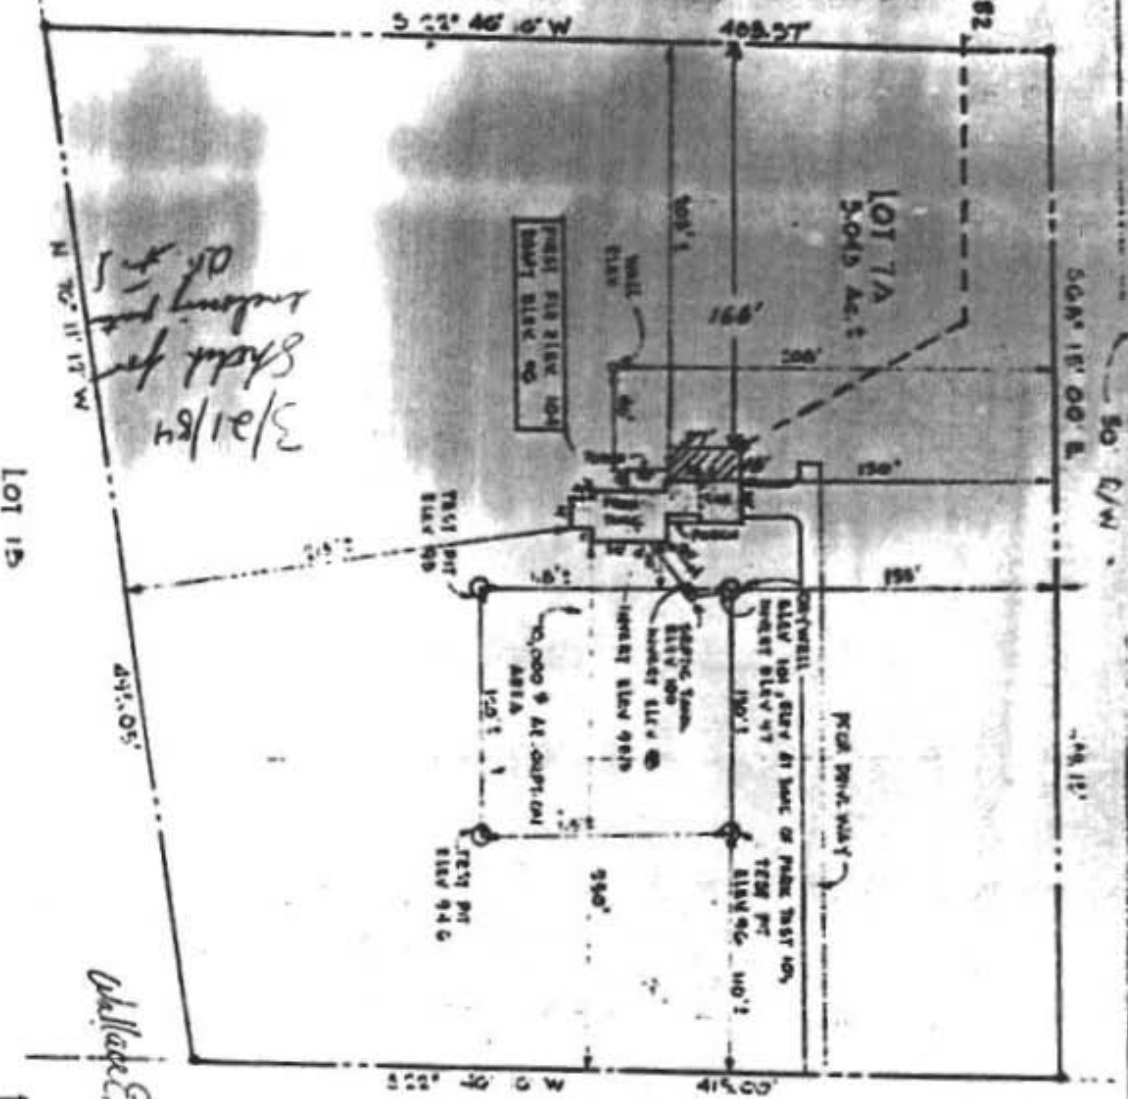

*3/21/84
 Shedd for
 looking at
 or to*

I CERTIFY THAT THE ABOVE MEASUREMENTS
 ELEVATIONS ARE ACCURATE SUBJECT TO THE PRECISION

Francis J. J...

Challenger, Challis

ROSEMARY LANE (50' WIDE)

W & N
 A ELEV
 1980 200