

APPLICATION

PERCOLATION TESTING

A 38736

P _____

HOWARD COUNTY HEALTH DEPARTMENT
BUREAU OF ENVIRONMENTAL HEALTH
P.O. BOX 476 ELLICOTT CITY, MARYLAND 21043
TELEPHONE: 461-9933

DISTRICT 4

DATE 12/17/86

TO: THE COUNTY HEALTH OFFICER
ELLICOTT CITY, MARYLAND

I, HEREBY, APPLY FOR THE NECESSARY TEST IN ORDER TO CONSTRUCT (OR RECONSTRUCT) A SEWAGE DISPOSAL SYSTEM.

PROPERTY OWNER Roy W. Crum + Wife Trinity Builders

ADDRESS 791 Morgan Station Rd PHONE 489-4995

PROSPECTIVE BUYER Hemphill Partnership

ADDRESS 10176 Baltimore National Pike Suite 210 PHONE 465-5855

PROPERTY LOCATION:

SUBDIVISION Morgan Station (Crum Property) LOT NO. LOT 28 Prelim
X 20/21/87

ROAD AND DESCRIPTION E/S Morgan Station Rd north of Old Frederick Rd
890 THE OLD STATION COURT

TAX MAP 3 PARCEL # 9

SIZE OF LOT 3 acres TYPE BLDG. SFD
(SINGLE FAMILY DWELLING OR COMMERCIAL)

THE SYSTEM INSTALLED UNDER THIS APPLICATION IS ACCEPTABLE ONLY UNTIL PUBLIC FACILITIES BECOME AVAILABLE. I FULLY UNDERSTAND THE FEE CONNECTED WITH THE FILING OF THIS PERC TEST APPLICATION IS NON-REFUNDABLE UNDER ANY CIRCUMSTANCES. I ALSO AGREE TO COMPLY WITH ALL M.O.S.H.A. REQUIREMENTS IN TESTING THIS LOT.

Mark S. Keil
(SIGNATURE OF APPLICANT)

APPROVED BY S. Abel FOR Shallow Sep. DATE 6-29-88

REJECTED BY _____ FOR _____ DATE _____


HOLD PENDING FURTHER TESTS _____ DATE _____

REASONS FOR REJECTION OR HOLDING 4/30/87 PERC OK Hold for Plat

BLDG. PERMIT SIGNED
AND RETURNED 7/22/88
SFD BP 19738

THIS IS NOT A PERMIT

Lot 35
Copy Reader
SOIL PROFILE

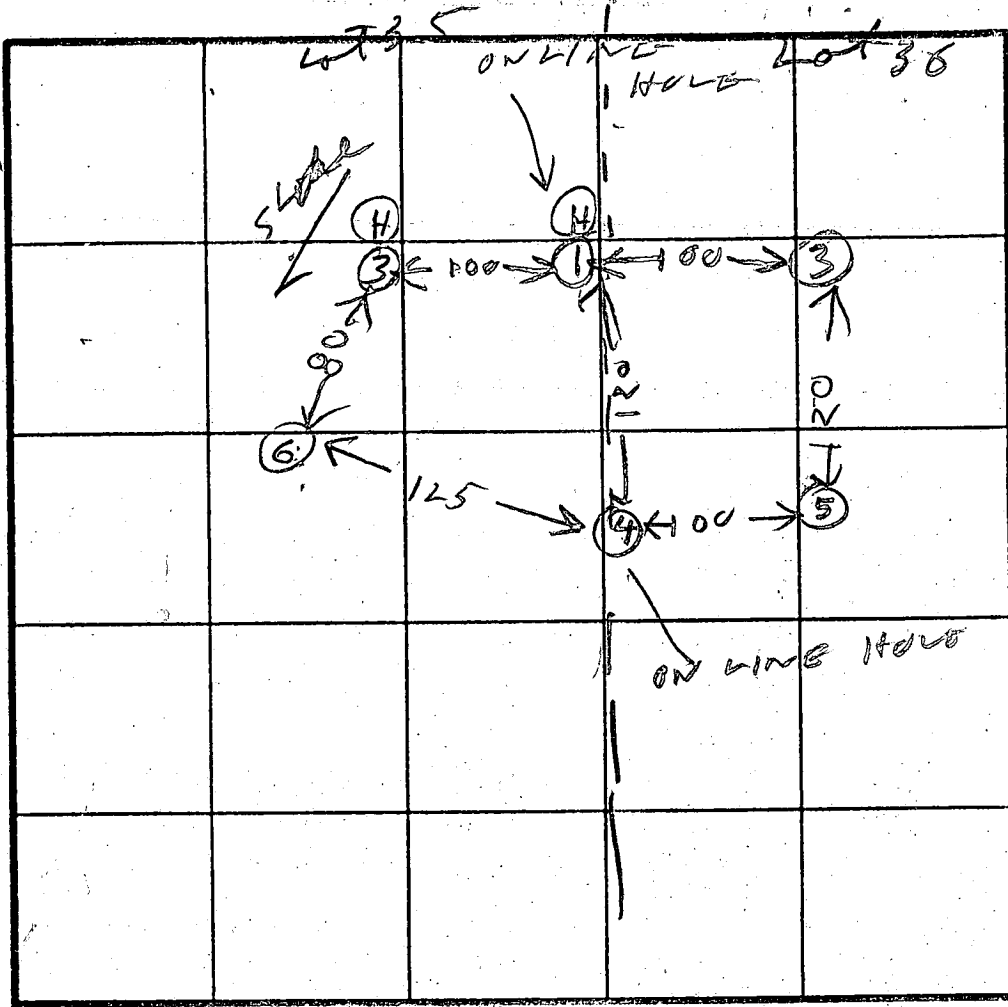

for lot 36

⑥
Clay
2 1/2
Pink
Brown
Sand
Loam
100%
Substrate
11

①
CLAY
2
Purple
Brown
Sand
Loam
11

④
Brown
Clay
Pink
Brown
Sand
Loam
100%
Substrate
11

③
CLAY
2 1/2
Brown
Sand
Loam
100%
Substrate
11

INDICATE NORTH - NAME ADJOINING ROADWAY AS BASE LINE

DATE	TEST NO.	DEPTH	PRE-WET		TEST : 1" DROP		TIME
			START	STOP	START	STOP	
4/30/97	1S	3.5	1243	1250	1250	100	10
	1D	7	1243	100	100	121	21
	1V	11	OK				
	2V	11.5	OK				
	3V	11	OK				
	4S	3.5	130	133	133	142	9
	4V	11	OK				
	5S	2	135	132	132	142	4
	5V	9.5	OK				
	6S	2.5	138	140	140	146	6
	6V	11	OK				

̄ Perc
12 min
200 #/BR
INLET 3"
BOTTOM
5"

REMARKS 4/30/97 Lot lines changed & Perc Area changed from original test plan

TYPE OF SOIL _____ TESTED BY _____ ALSO PRESENT _____