



Building Permit Application

Howard County Maryland
Department of Inspections, Licenses and Permits
3430 Court House Drive
Permits: 410-313-2455
www.howardcountymd.gov

Date Received: _____

Permit No.: _____

Building Address: 3201 Parliament Place
 City: West Friendship State: MD Zip Code: 21794
 Suite/Apt. # _____ SDP/WP/BA #: _____
 Census Tract: _____ Subdivision: 0000
 Section: _____ Area: _____ Lot: #1
 Tax Map: 0022 Parcel: 0548 Grid: 0003
 Zoning: _____ Map Coordinates: _____ Lot Size: 3.03 AC

Property Owner's Name: Eric & Elizabeth Pellak
 Address: 3201 Parliament Place
 City: West Friendship State: MD Zip Code: 21794
 Phone: 240-755-0157 Fax: _____
 Email: pinepellak@gmail.com

Applicant's Name & Mailing Address, (if other than stated herein)
 Applicant's Name: Owner
 Address: _____
 City: _____ State: _____ Zip Code: _____
 Phone: _____ Fax: _____
 Email: _____

Existing Use: Ground Level Patio
 Proposed Use: Spa platform
 Estimated Construction Cost: \$ Free
 Description of Work: As-built Spa on concrete slab

Contractor Company: Owner
 Contact Person: _____
 Address: _____
 City: _____ State: _____ Zip Code: _____
 License No.: _____
 Phone: _____ Fax: _____
 Email: _____

Occupant or Tenant: Eric and Elizabeth Pellak
 Was tenant space previously occupied? Yes No
 Contact Name: Eric Pellak
 Address: 3201 Parliament Place
 City: West Friendship State: MD Zip Code: 21794
 Phone: 240-755-0157 Fax: _____
 Email: pinepellak@gmail.com

Engineer/Architect Company: _____
 Responsible Design Prof.: _____
 Address: _____
 City: _____ State: _____ Zip Code: _____
 Phone: _____ Fax: _____
 Email: _____

Commercial Building Characteristics	Residential Building Characteristics	
Height:	<input checked="" type="checkbox"/> SF Dwelling <input type="checkbox"/> SF Townhouse	
No. of stories:	<u>Depth</u>	<u>Width</u>
Gross area, sq. ft./floor:	1 st floor:	
	2 nd floor:	
Area of construction (sq. ft.):	Basement:	
	<input checked="" type="checkbox"/> Finished Basement	
Use group:	<input type="checkbox"/> Unfinished Basement	
	<input type="checkbox"/> Crawl Space	
Construction type:	<input type="checkbox"/> Slab on Grade	
<input type="checkbox"/> Reinforced Concrete	No. of Bedrooms:	
<input type="checkbox"/> Structural Steel	Multi-family Dwelling	
<input type="checkbox"/> Masonry	No. of efficiency units:	
<input type="checkbox"/> Wood Frame	No. of 1 BR units:	
<input type="checkbox"/> State Certified Modular	No. of 2 BR units:	
	No. of 3 BR units:	
	Other Structure:	
	Dimensions:	
<input checked="" type="checkbox"/> Roadside Tree Project Permit	Footings:	
<input type="checkbox"/> Yes <input checked="" type="checkbox"/> No	Roof:	
Roadside Tree Project Permit #	<input type="checkbox"/> State Certified Modular	
	<input type="checkbox"/> Manufactured Home	

Utilities	
Water Supply	
<input type="checkbox"/> Public	
<input checked="" type="checkbox"/> Private	
Sewage Disposal	
<input type="checkbox"/> Public	
<input checked="" type="checkbox"/> Private	
Electric: <input type="checkbox"/> Yes <input type="checkbox"/> No	
Gas: <input type="checkbox"/> Yes <input type="checkbox"/> No	
Heating System	
<input checked="" type="checkbox"/> Electric <input type="checkbox"/> Oil	
<input type="checkbox"/> Natural Gas <input type="checkbox"/> Propane Gas	
<input type="checkbox"/> Other:	
Sprinkler System:	
<input type="checkbox"/> Yes <input checked="" type="checkbox"/> No	
Grading Permit Number:	
Building Shell Permit Number:	

THE UNDERSIGNED HEREBY CERTIFIES AND AGREES AS FOLLOWS: (1) THAT HE/SHE IS AUTHORIZED TO MAKE THIS APPLICATION; (2) THAT THE INFORMATION IS CORRECT; (3) THAT HE/SHE WILL COMPLY WITH ALL REGULATIONS OF HOWARD COUNTY WHICH ARE APPLICABLE THERETO; (4) THAT HE/SHE WILL PERFORM NO WORK ON THE ABOVE REFERENCED PROPERTY NOT SPECIFICALLY DESCRIBED IN THIS APPLICATION; (5) THAT HE/SHE GRANTS COUNTY OFFICIALS THE RIGHT TO ENTER ONTO THIS PROPERTY FOR THE PURPOSE OF INSPECTING THE WORK PERMITTED AND POSTING NOTICES.

Applicant's Signature: [Signature]
 pinepellak@gmail.com
 Email Address
 Title/Company

Print Name: Eric . Pellak
 10 August 2016
 Date


Checks Payable to: DIRECTOR OF FINANCE OF HOWARD COUNTY
 PLEASE WRITE NEATLY & LEGIBLY
 -FOR OFFICE USE ONLY-

AGENCY	DATE	SIGNATURE OF APPROVAL
State Highways		
Building Officials		
PSZA (Zoning)		
PSZA (Engineering)		
Health	<u>8/16/16</u>	<u>H. Oswald</u>

Is Sediment Control approval required for issuance? Yes No
 CONTINGENCY CONSTRUCTION START

DPZ SETBACK INFORMATION
Front:
Rear:
Side:
Side St.:
All minimum setbacks met? <input type="checkbox"/> Yes <input type="checkbox"/> No
Is Entrance Permit Required? <input type="checkbox"/> Yes <input type="checkbox"/> No
Historic District? <input type="checkbox"/> Yes <input type="checkbox"/> No
Lot Coverage for New Town Zone:
SDP/Red-line approval date:

Filing Fee	\$
Permit Fee	\$
Tech Fee	\$
Excise Tax	\$
PSFS	\$
Guaranty Fund	\$
Add'l per Fee	\$
Total Fees	\$
Sub- Total Paid	\$
Balance Due	\$
Check	#

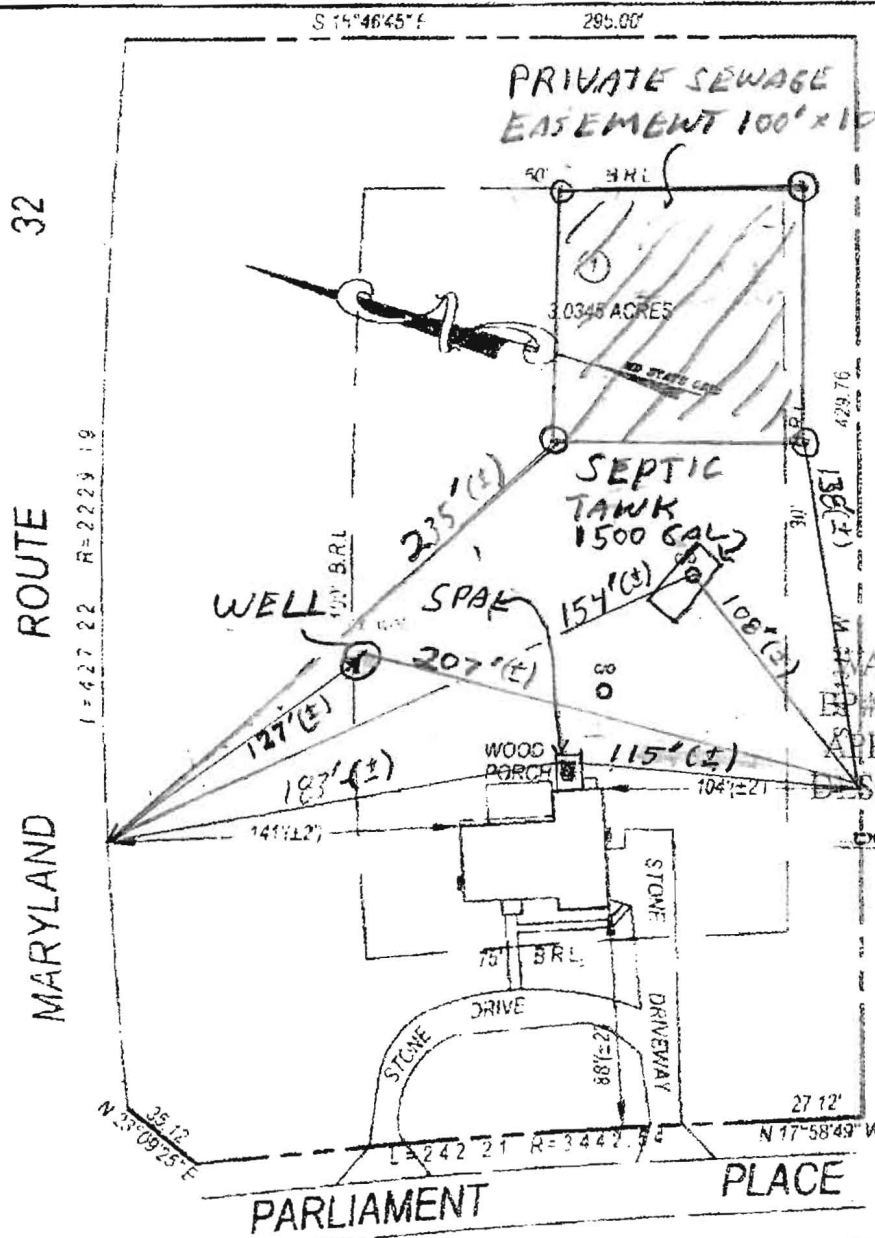


APPROVED
WALK-THRU BUILDING PERMIT
A# _____
APP. SAN H. Oswald DATE 8/8/10
DESC. OF WORK: Install spa on concrete slab

2. JDC PLOTTING LOCATION DRAWING BY JDCPT 10/10/2008 10:51:11 AM

LOCATION DRAWING
LOT #1
PLAT OF CORRECTION
LOTS 1 THRU 16, SECTION 1
KINGS GRANT
RECORDED PLAT # 852H
3RD ELECTION DISTRICT
HOWARD COUNTY MARYLAND

- NOTES**
- All fence lines must be verified by a boundary survey
 - A statement of minimum advice is an integral part of the plat and is detailed on the attached general notes
 - The property shown herein is not affected by the Flood Hazard Zone as shown on Flood Insurance Rate Map for Carroll County, Maryland Panel No. 15 of 45, Community Panel No. 2400440015 B as prepared by the National Flood Insurance Program, revision date DECEMBER 4 1966

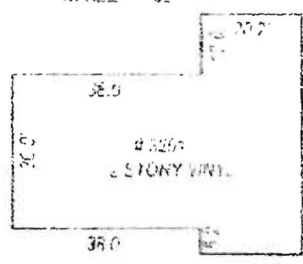

A licensed Maryland Surveyor, either personally prepared the Location Drawing as shown hereon, or was in responsible charge over the preparation and the surveying work reflected hereon in compliance with chapters 001, 03 to 12 of the Maryland Minimum Standards and Practice for Land Surveyors. I warrant that the property owners have not been assembled or deceived. We assume no responsibility for liability for any rights-of-way or easements, recorded or unrecorded, not appearing on the record plat, and/or encroachments in the field related to hereon.

$1/16" = 4.7'$
Signed this 10th day of October 2008
Surveyor's Signature



Date: OCTOBER 10, 2008
BPR Job No. 08-001-07E
Scale: 1 inch = 60' feet

Also known as # 3201 PARLIAMENT PLACE