

APPLICATION

PERCOLATION TESTING

A 43249

P _____

HOWARD COUNTY HEALTH DEPARTMENT
BUREAU OF ENVIRONMENTAL HEALTH
P.O. BOX 476 ELLICOTT CITY, MARYLAND 21043
TELEPHONE 461-9933

DISTRICT 4

DATE 12/9/88

TO: THE COUNTY HEALTH OFFICER
ELLICOTT CITY, MARYLAND

I HEREBY APPLY FOR THE NECESSARY TEST IN ORDER TO CONSTRUCT (OR RECONSTRUCT) A SEWAGE DISPOSAL SYSTEM.

PROPERTY OWNER Egwood Farm Inc C/O Land Design + Development

ADDRESS 8307 Main St PHONE 461-4620

PROSPECTIVE BUYER N/A

ADDRESS _____ PHONE _____

PROPERTY LOCATION:

SUBDIVISION Clark Sycamore Valley LOT NO. 12 New #11 final

ROAD AND DESCRIPTION Roxbury + Dorsey Mill

TAX MAP 21 PARCEL # 6

SIZE OF LOT - 3.4 AC. TYPE BLDG. SFD
(SINGLE FAMILY DWELLING OR COMMERCIAL)

THE SYSTEM INSTALLED UNDER THIS APPLICATION IS ACCEPTABLE ONLY UNTIL PUBLIC FACILITIES BECOME AVAILABLE. I FULLY UNDERSTAND THE FEE CONNECTED WITH THE FILING OF THIS PERC TEST APPLICATION IS NON-REFUNDABLE UNDER ANY CIRCUMSTANCES. I ALSO AGREE TO COMPLY WITH ALL M.O.S.H.A. REQUIREMENTS IN TESTING THIS LOT.

Mal D. Rein
(SIGNATURE OF APPLICANT)

APPROVED BY _____ FOR _____ DATE _____

REJECTED BY _____ FOR _____ DATE _____

HOLD PENDING FURTHER TESTS _____ DATE _____

REASONS FOR REJECTION OR HOLDING _____

HD-216

THIS IS NOT A PERMIT


A 43249

New # 11

#12

+ #13

SOIL PROFILE

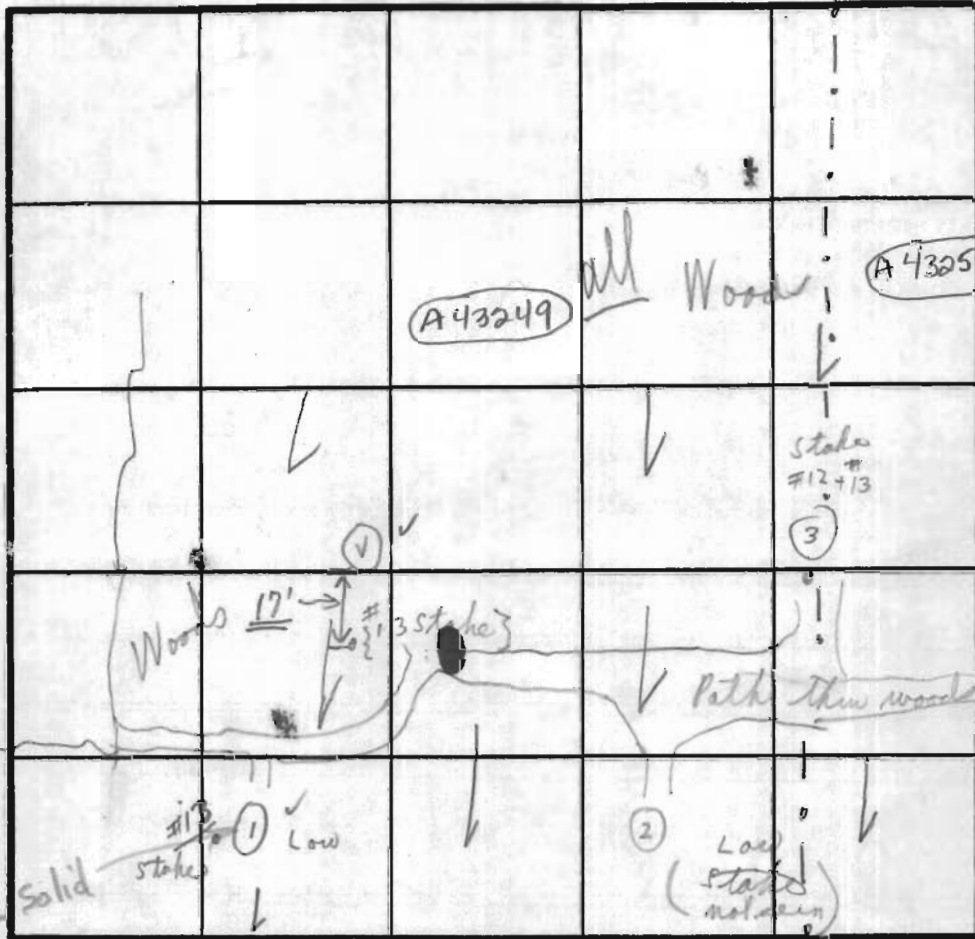

In 4
Bot 6
180' BR

A43250

Unfilled
average 29 in
240-300 ft on
Repairs

INDICATE NORTH - NAME ADJOINING ROADWAY AS BASE LINE.

DATE	TEST NO.	DEPTH	PRE-WET		TEST - 1" DROP		TIME
			START	STOP	START	STOP	
1/10/89	①	6'	2:12	2:20	2:20	2:49	29 min
Tues	②	10 1/2'				Solid	
	⑦	6'	2:43	2:45	2:45	2:48	3 min
		12' 8"				Visual light loam	
	③	4'	2:27	2:29	2:29	2:32	3 min
		7 1/2'	2:25	2:26	2:26	2:28	2 min
	④						
	(⑤) solid	6 1/2'	2:37	2:38	2:38	2:41	3 min
	⑥	3 1/2' 12'	Loam		Visual		No test ok

Poorer loam

1'-4' clay
Sandy loam
4'-12' 8"

Sandy loam
Clay to
bedded
Loam

(1'-4' 3 1/2' clay)
Sandy loam

Note
Poured own water
Note 20% small rock
Some surface rock

{ Dry to }
12'

{ Dry to }
12 1/2'

REMARKS Tests per stake; Tests on heavy woods
or no notes (Note 2 backhoes + 5 men all day)

TYPE OF SOIL

TESTED BY C.K.P.

ALSO PRESENT { Name as rest of day }