



# HOWARD COUNTY HEALTH DEPARTMENT

62939

DATE 3/21/18

Received From

Fogles Septic Clean PHONE # 775-5670

For

Minor Repair - 1718 Heatherwood way

- CASH
- CHECK

NO.

60301

fifty-five Dollars

\$

55.00

Received By

O'Leary



**Bureau of Environmental Health**  
 8930 Stanford Boulevard, Columbia, MD 21045  
 Main: 410-313-2640 | Fax: 410-313-2648  
 TDD 410-313-2323 | Toll Free 1-866-313-6300  
[www.hchealth.org](http://www.hchealth.org)  
 Facebook: [www.facebook.com/hocohealth](http://www.facebook.com/hocohealth)

Maura J. Rossman, M.D., Health Officer

RECEIPT DATE: 3/29/18 **ONSITE SEWAGE DISPOSAL SYSTEM** P 562939

INSTALLATION APPROVAL DATE: 04/03/2018 **PERMIT** A \_\_\_\_\_  
**MINOR REPAIR**

PROPERTY ADDRESS: 1718 Heatherwood Way

SUBDIVISION: Heatherwood LOT: 9 TAX ID: 03-307441

CONTRACTOR: Fogle's Septic Clean Inc. EMAIL: kim@foglesinc.com

CONTRACTOR ADDRESS: 580 Obrecht Road, Sykesville, MD 21784 PHONE: 410-795-5670

PROPERTY OWNER: Sharon Watts Curington EMAIL: \_\_\_\_\_

OWNER ADDRESS: 1718 Heatherwood Way, Sykesville, MD 21784 PHONE: 410-375-0882

NUMBER OF BEDROOMS: 4 SEPTIC TANK SIZE: 1250 DRAINFIELD SIZE/TYPE: EXISTING (1983)  
EXISTING SPEC 1983 EXISTING SPEC 1983


LOCATION:	
NOTES:	Replacing rust-leaden pipe in trench/box.

ISSUED BY: K. Wolf ISSUE DATE: 4/3/18 EXPIRATION DATE: 4/3/19

- NOTE: CONTRACTOR MUST SCHEDULE AN INSPECTION AND GAIN APPROVAL OF ALL COMPONENTS PRIOR TO COVERING
- NOTE: AN ELECTRICAL PERMIT IS REQUIRED FOR INSTALLATION OF ANY ELECTRICAL COMPONENTS OF THE SYSTEM
- NOTE: MDE RECOMMENDS SEPTIC TANKS, BAT, AND OTHER PRETREATMENT UNITS BE PUMPED AT A FREQUENCY ADEQUATE TO ENSURE THAT SOLIDS ARE NOT DISCHARGED TO THE DISPOSAL AREA

**NEITHER THE HOWARD COUNTY COUNCIL NOR THE HEALTH DEPARTMENT IS RESPONSIBLE FOR THE SUCCESSFUL OPERATION OF ANY SYSTEM.  
 PERMITTEE RESPONSIBLE FOR OBTAINING FINAL APPROVAL ON THIS PERMIT.  
 CALL 410-313-1771 FOR INSPECTION OF SEPTIC SYSTEM.**

NOT TO SCALE

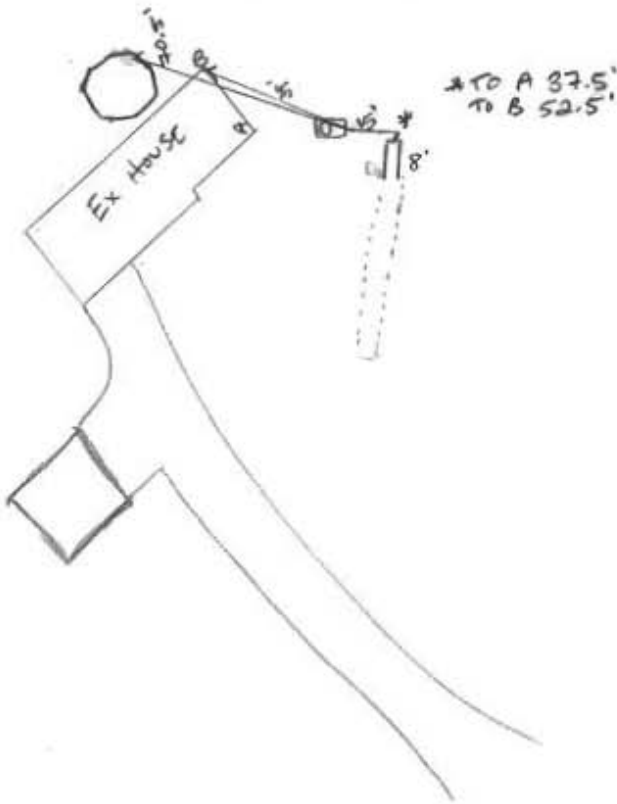

**TRENCH/DRAINFIELD DATA**

WIDTH	INLET	BOTTOM
_____	_____	_____
NUMBER OF TRENCHES <u>1</u>		
TOTAL LENGTH _____		
ABSORPTION AREA _____		
DISTRIBUTION BOX LEVEL _____		
DISTRIBUTION BOX BAFFLE _____		
DISTRIBUTION BOX PORT _____		

**SEPTIC TANK DATA - EXISTING**

SEPTIC TANK I LEVEL \_\_\_\_\_ w/ following install

MANUFACTURER \_\_\_\_\_

CAPACITY \_\_\_\_\_ GAL

SEAM LOC \_\_\_\_\_

TANK LID DEPTH \_\_\_\_\_

BAFFLES YES (1/0)

BAFFLE FILTER \_\_\_\_\_

MANHOLE LOC \_\_\_\_\_

6" PORT LOC Inlet

WATERTIGHT TEST \_\_\_\_\_

SLOTTED \_\_\_\_\_ + RISER

DATE ON LID \_\_\_\_\_

PUMP/SEPTIC TANK LEVEL \_\_\_\_\_

MANUFACTURER \_\_\_\_\_

CAPACITY \_\_\_\_\_ GAL

SEAM LOC \_\_\_\_\_

TANK LID DEPTH \_\_\_\_\_

BAFFLES \_\_\_\_\_

BAFFLE FILTER \_\_\_\_\_

MANHOLE LOC \_\_\_\_\_

6" PORT LOC \_\_\_\_\_

WATERTIGHT TEST \_\_\_\_\_

SLOTTED \_\_\_\_\_

DATE ON LID \_\_\_\_\_

HEATHERWOOD ROAD NAME WAY

PRE-CONSTRUCTION:

\_\_\_\_\_

\_\_\_\_\_

\_\_\_\_\_

\_\_\_\_\_

INSTALLATION: 04/03/2018. Minor Repair completed. Tank riser installed over inlet of S.T. 6" Baffle installed on inlet. 15' of effluent line installed from S.T. to Trench. 8' of trench pipe was replaced. Repair was caused by tree root infiltration.

\_\_\_\_\_

\_\_\_\_\_

FINAL INSPECTOR

DATE OF APPROVAL 04/03/2018



Bureau of Environmental Health

8930 Stanford Boulevard, Columbia, MD 21045

Main: 410-313-2640 | Fax: 410-313-2648

TDD 410-313-2323 | Toll Free 1-866-313-6300

www.hchealth.org

Facebook: www.facebook.com/hocohealth

Twitter: HowardCoHealthDep

Dr. Maura J. Rossman, M.D., Health Officer

INFORMATION FORM - SEPTIC SYSTEM REPAIR/UPGRADE

Reason for Request:

- Reason for Request:
- [ ] Failing System
- [ ] System relocation for proposed addition
- [ ] System upgrade for proposed addition
- [x] Inadequate treatment zone
- [ ] Collapsed septic tank
- [ ] Collapsed drywell

Has the septic tank been pumped within the last month?

- Has the septic tank been pumped within the last month?
- [ ] Yes Date pumped:
- [x] No

Was a visual inspection of the septic tank and/or drain fields conducted?

- Was a visual inspection of the septic tank and/or drain fields conducted?
- [x] Yes Explain observations:
- [ ] No

Existing system design

- Existing system design
- [ ] Drywell
- [ ] Trench
- [ ] Mound
- [ ] Unknown
- [ ] Other:

Was a visual inspection of the sewage line conducted?

- Was a visual inspection of the sewage line conducted?
- [x] Yes
- [ ] No

Blockage leading to the tank

- Blockage leading to the tank
- [x] Yes Explain:
- [ ] No

Blockage leading to the field

- Blockage leading to the field
- [x] Yes Explain:
- [ ] No

Is discharge surfacing on the ground?

- Is discharge surfacing on the ground?
- [ ] Yes
- [ ] No

Additional Comments:

\*For REPAIRS, are the owners proposing, or do they plan to add in the future, any additions or modifications to the property, i.e. pools, living space additions, garages, etc? This information must be disclosed at the time of this application. The Health Department will not be able to accommodate requests in the field for property modifications unrelated to the repair request. Such requests may require an additional fee, testing, and submittal of a Percolation Certification Plan, if the property does not meet current Code and Regulation.

Septic Contractor: Eagle's Septic Clean Contractor's Phone: 410-795-5670
Contractor's Address: 580 Obrecht Rd Sykesville Md 21784

Property Address: 1718 Heatherwood Way County file:

Subdivision: Heatherwood Lot: 4 Year Built: 1983

Owner's Name: Sharon Walls Curington Owner's Phone: 410-375-0882

Name of previous owners: Oswald Existing bedrooms: 4
Proposed bedrooms:

Has this request been previously discussed with a Sanitarian? (Name):
Public Sewer available/nearby: NO

\*A Sanitarian will be in contact within three business days, depending upon the urgency of the situation, to coordinate the scheduling/review of the repair or upgrade.

\*Prior to scheduling inspections, scaled plans should be submitted to clarify the nature of the addition.\*

Print out a copy of Real Property Data via Dept. of Taxation website Indexed file found

If public sewer may be nearby, verify whether sewer is technically "available" through the Bureau of Engineering.

If sewer is available and the property is within the Metropolitan District, connection to sewer is required. If the owner believes reason for exemption exists, the owner should justify the request in writing.

If soil/site conditions are limited and sewer and/or Metro District status is not conducive to connection, the Sanitarian may recommend pursuit of Emergency Sewer Extension or Emergency Metro District Inclusion. The Owner should contact the Bureau of Utilities for details.

No permit is to be issued nor inspection to be scheduled without prior fee collection at the office unless an emergency situation exists. The contractor is to notify office of the emergency situation as soon as possible.