



Building Permit Application

Howard County Maryland
Department of Inspections, Licenses and Permits
3430 Court House Drive
Permits: 410-313-2455
www.howardcountymd.gov

Date Received: _____

Permit No. _____

Building Address: 6976 MINK HOLLOW RD
 City: HIGHLAND State: MD Zip Code: _____
 Suite/Apt # _____ SDP/WP/BA #: _____
 Census Tract: _____ Subdivision: _____
 Section: _____ Area: _____ Lot: _____
 Tax Map: _____ Parcel: _____ Grid: _____
 Zoning: _____ Map Coordinates: _____ Lot Size: _____

Existing Use: SINGLE FAMILY DETACHED
 Proposed Use: SAME
 Estimated Construction Cost: \$ 9K
 Description of Work: ADD A POWDER ROOM TO EXISTING FINISHED BASEMENT

Occupant/Tenant Name _____
 Was tenant space previously occupied? Yes No
 Contact Name: _____
 Address: _____
 City: _____ State: _____ Zip Code: _____
 Phone: _____ Fax: _____
 Email: _____

Property Owner's Name: ROBERT & SALLY JOHNSON
 Address: 8976 MINK HOLLOW RD
 City: HIGHLAND State: MD Zip Code: _____
 Phone: _____ Fax: _____
 Email: SJOHNSON56@GMAIL.COM

Applicant's Name & Mailing Address, (If other than stated herein)
 Applicant's Name: MAT MALANOSKI
 Address: 8670 RESERVOIR RD
 City: FULTON State: MD Zip Code: 20759
 Phone: 301 509 7786 Fax: _____
 Email: MALANOSKI@VERIZON.NET

Contractor Company: SPRINGBROOK-WADSWORTH INC
 Contact Person: MAT MALANOSKI
 Address: 8670 RESERVOIR RD
 City: FULTON State: MD Zip Code: 20759
 License No.: 29392
 Phone: 301 604 6409 Fax: _____
 Email: _____

Engineer/Architect Company: _____
 Responsible Design Prof.: _____
 Address: _____
 City: _____ State: _____ Zip Code: _____
 Phone: _____ Fax: _____
 Email: _____

| Commercial Building Characteristics | Residential Building Characteristics | |
|--|---|-------|
| Height | <input checked="" type="checkbox"/> SF Dwelling <input type="checkbox"/> SF Townhouse | |
| No. of stories: | Depth | Width |
| Gross area, sq. ft./floor: | 1 st floor: | |
| | 2 nd floor: | |
| Area of construction (sq. ft.): | Basement: | |
| | <input checked="" type="checkbox"/> Finished Basement | |
| Use group: | <input checked="" type="checkbox"/> Unfinished Basement | |
| | <input type="checkbox"/> Crawl Space | |
| <u>Construction type:</u> | <input type="checkbox"/> Slab on Grade | |
| <input type="checkbox"/> Reinforced Concrete | No. of Bedrooms: | |
| <input type="checkbox"/> Structural Steel | <u>Multi-family Dwelling</u> | |
| <input type="checkbox"/> Masonry | No. of efficiency units: | |
| <input type="checkbox"/> Wood Frame | No. of 1 BR units: | |
| <input type="checkbox"/> State Certified Modular | No. of 2 BR units: | |
| | No. of 3 BR units: | |
| | Other Structure: | |
| | Dimensions: | |
| <input checked="" type="checkbox"/> Roadside Tree Project Permit | Footings: | |
| <input type="checkbox"/> Yes <input type="checkbox"/> No | Roof: | |
| Roadside Tree Project Permit # | <input type="checkbox"/> State Certified Modular | |
| | <input type="checkbox"/> Manufactured Home | |

| Utilities | |
|---|---|
| Electric: | <input checked="" type="checkbox"/> Yes <input type="checkbox"/> No |
| Gas: | <input type="checkbox"/> Yes <input checked="" type="checkbox"/> No |
| Water Supply | |
| <input type="checkbox"/> Public | |
| <input checked="" type="checkbox"/> Private | |
| Sewage Disposal | |
| <input type="checkbox"/> Public | |
| <input checked="" type="checkbox"/> Private | |
| Heating System | |
| <input type="checkbox"/> Electric | <input checked="" type="checkbox"/> Oil |
| <input type="checkbox"/> Natural Gas | <input type="checkbox"/> Propane Gas |
| <input type="checkbox"/> Other: | |
| Sprinkler System: | |
| <input type="checkbox"/> Yes | <input checked="" type="checkbox"/> No |
| Grading Permit Number: | |
| Building Shell Permit Number: | |

THE UNDERSIGNED HEREBY CERTIFIES AND AGREES AS FOLLOWS: (1) THAT HE/SHE IS AUTHORIZED TO MAKE THIS APPLICATION, (2) THAT THE INFORMATION IS CORRECT, (3) THAT HE/SHE WILL COMPLY WITH ALL REGULATIONS OF HOWARD COUNTY WHICH ARE APPLICABLE THERETO; (4) THAT HE/SHE WILL PERFORM NO WORK ON THE ABOVE REFERENCED PROPERTY NOT SPECIFICALLY DESCRIBED IN THIS APPLICATION, (5) THAT HE/SHE GRANTS COUNTY OFFICIALS THE RIGHT TO ENTER ONTO THIS PROPERTY FOR THE PURPOSE OF INSPECTING THE WORK PERMITTED AND POSTING NOTICES

Applicant's Signature: MAT MALANOSKI Print Name: MATTHEW MALANOSKI
 Email Address: MALANOSKI@VERIZON.NET Date: 10/26/17
 Title/Company: OWNER


Checks Payable to: DIRECTOR OF FINANCE OF HOWARD COUNTY
 "PLEASE WRITE NEATLY & LEGIBLY"
 -FOR OFFICE USE ONLY-

| AGENCY | DATE | SIGNATURE OF APPROVAL |
|--------------------|-----------------|-----------------------|
| State Highways | | |
| Building Officials | | |
| PSZA (Zoning) | | |
| PSZA (Engineering) | | |
| Health | <u>10/26/17</u> | <u>[Signature]</u> |

Is Sediment Control approval required for issuance? Yes No
 CONTINGENCY CONSTRUCTION START

| DPZ SETBACK INFORMATION |
|---|
| Front: |
| Rear: |
| Side: |
| Side St.: |
| All minimum setbacks met? <input type="checkbox"/> Yes <input type="checkbox"/> No |
| Is Entrance Permit Required? <input type="checkbox"/> Yes <input type="checkbox"/> No |
| Historic District? <input type="checkbox"/> Yes <input type="checkbox"/> No |
| Lot Coverage for New Town Zone: |
| SDP/Red-line approval date: |

| | |
|----------------|----|
| Filing Fee | \$ |
| Permit Fee | \$ |
| Tech Fee | \$ |
| Excise Tax | \$ |
| PSFS | \$ |
| Guaranty Fund | \$ |
| Add'l per Fee | \$ |
| Total Fees | \$ |
| Sub-Total Paid | \$ |
| Balance Due | \$ |
| Check | # |

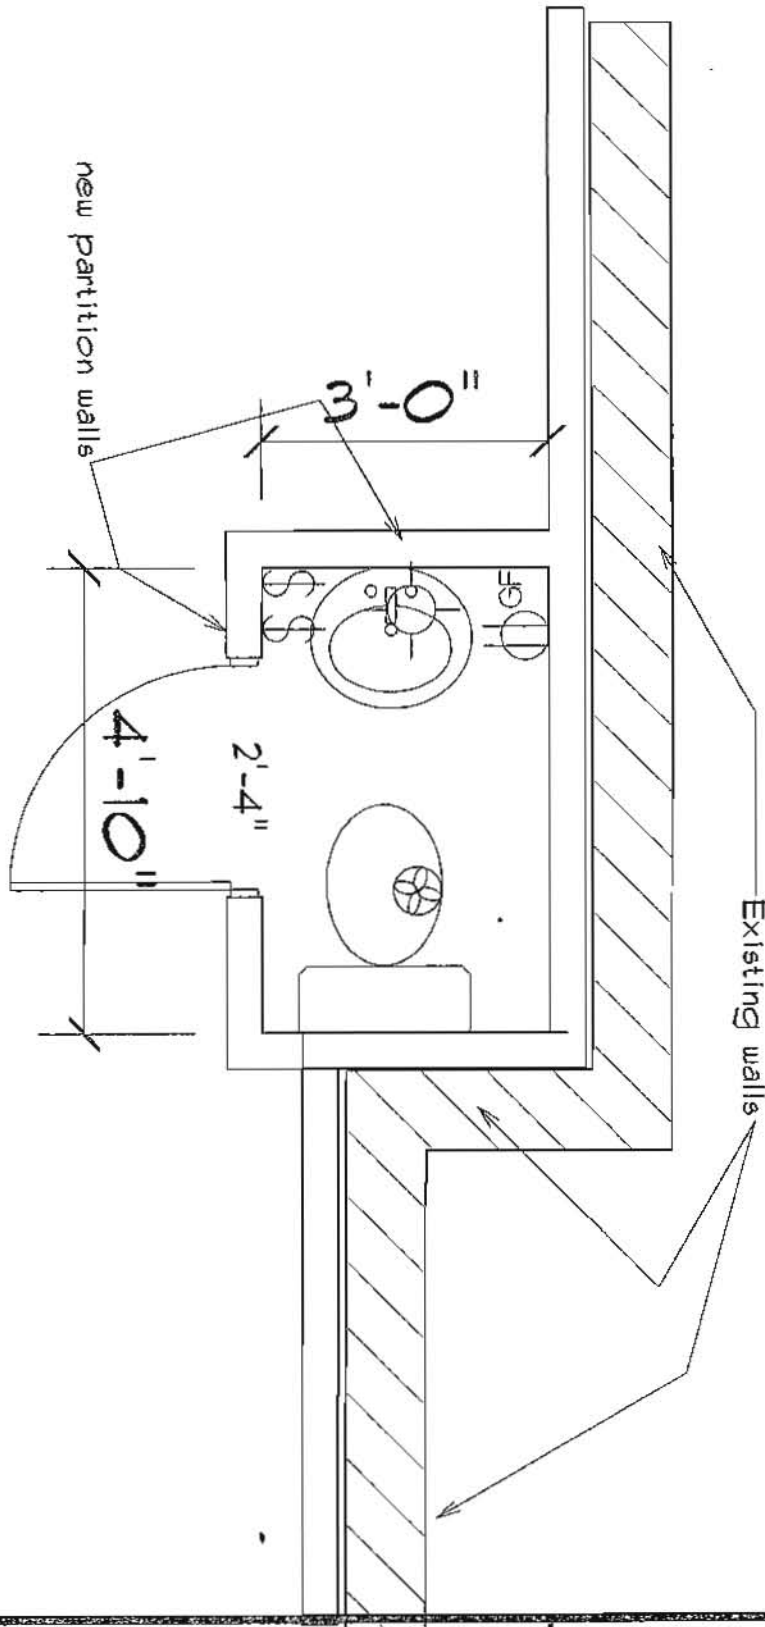

existing finished basement
(open family room)

APPROVED

WALKTHRU BUILDING PERMIT

BP#

APP. SAN

DESC. OF WORK

DATE: 10/26/17

Paulin Peason

as shown

 **Springbrook**
Home Improvements
8670 Reservoir Road, Fulton, MD
phone 301.604.6909 Fax 301.604.6956
Email-Malanoski@verizon.net

Proposed Powder Room

Rodger and Sally Johnson
6976 Mink Hollow Road
Highland


PAGE #

DRAWN BY: MM

SCALE: 1/2" = 1'


DATE: October 26, 2017

APPROVED
 WALK-THRU BUILDING PERMIT
 BP# _____ A# _____
 APP. SAN _____ DATE: 10/26/17
 DESC. OF WORK: Powder Room
 OK as shown

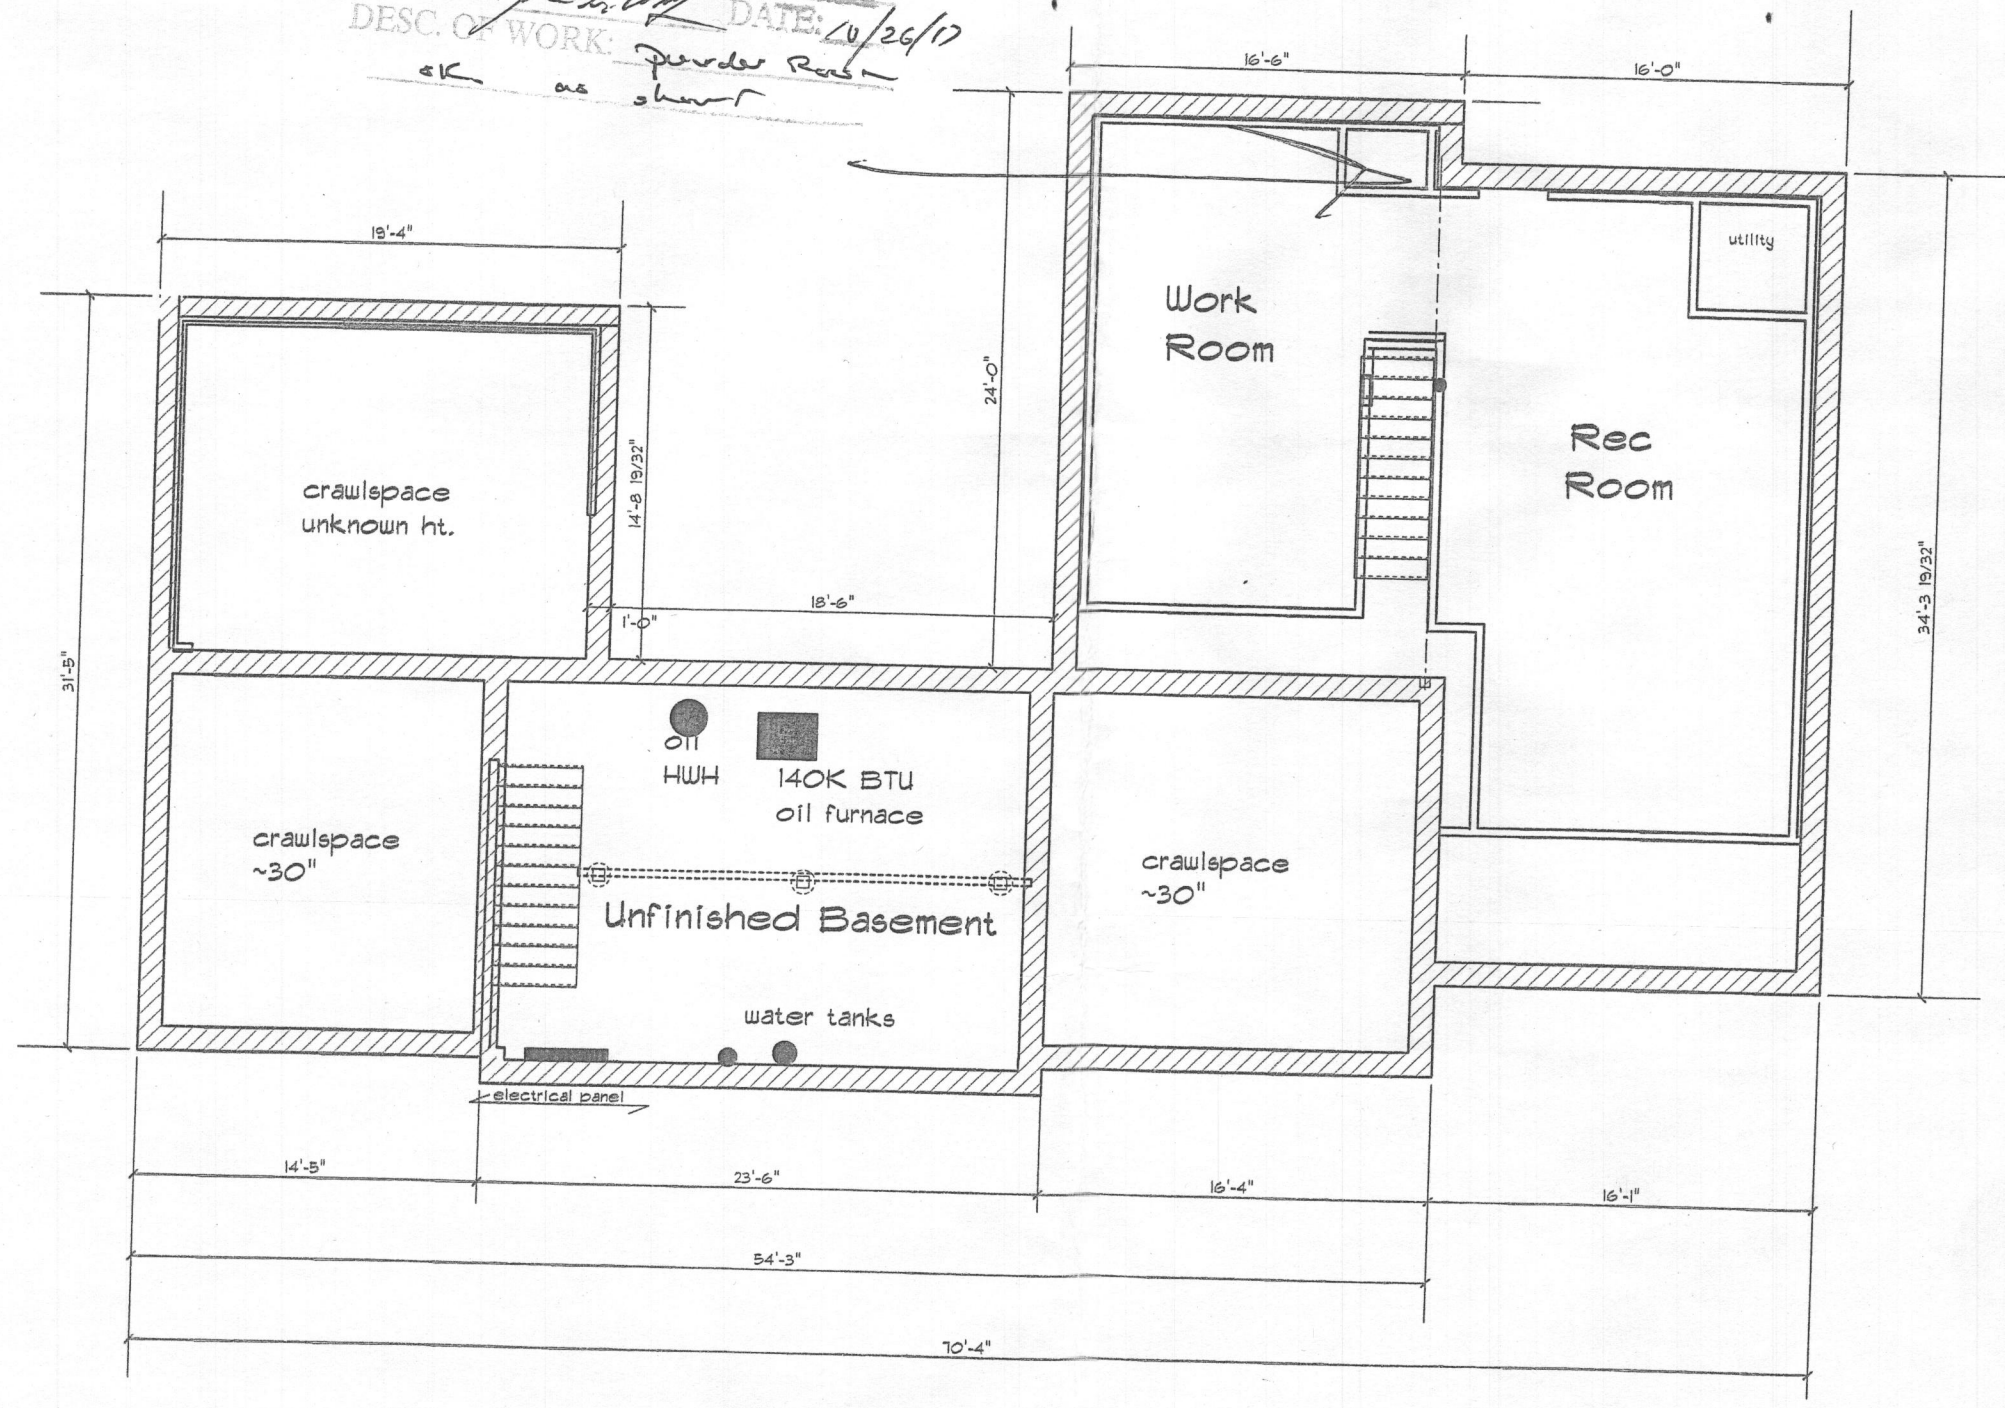

Existing Foundation Plan

Rodger and Sally Johnson
 6976 Mink Hollow Road
 Highland

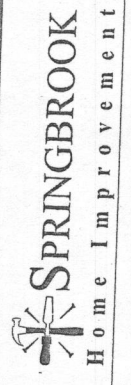


8670 Reservoir Road, Fulton, MD
 phone 301.604.6909 Fax 301.604.6956
 Email: Malanoski@verizon.net

Page # 1

DRAWN BY: MM

SCALE 1/4" = 1'

DATE October 26, 2017

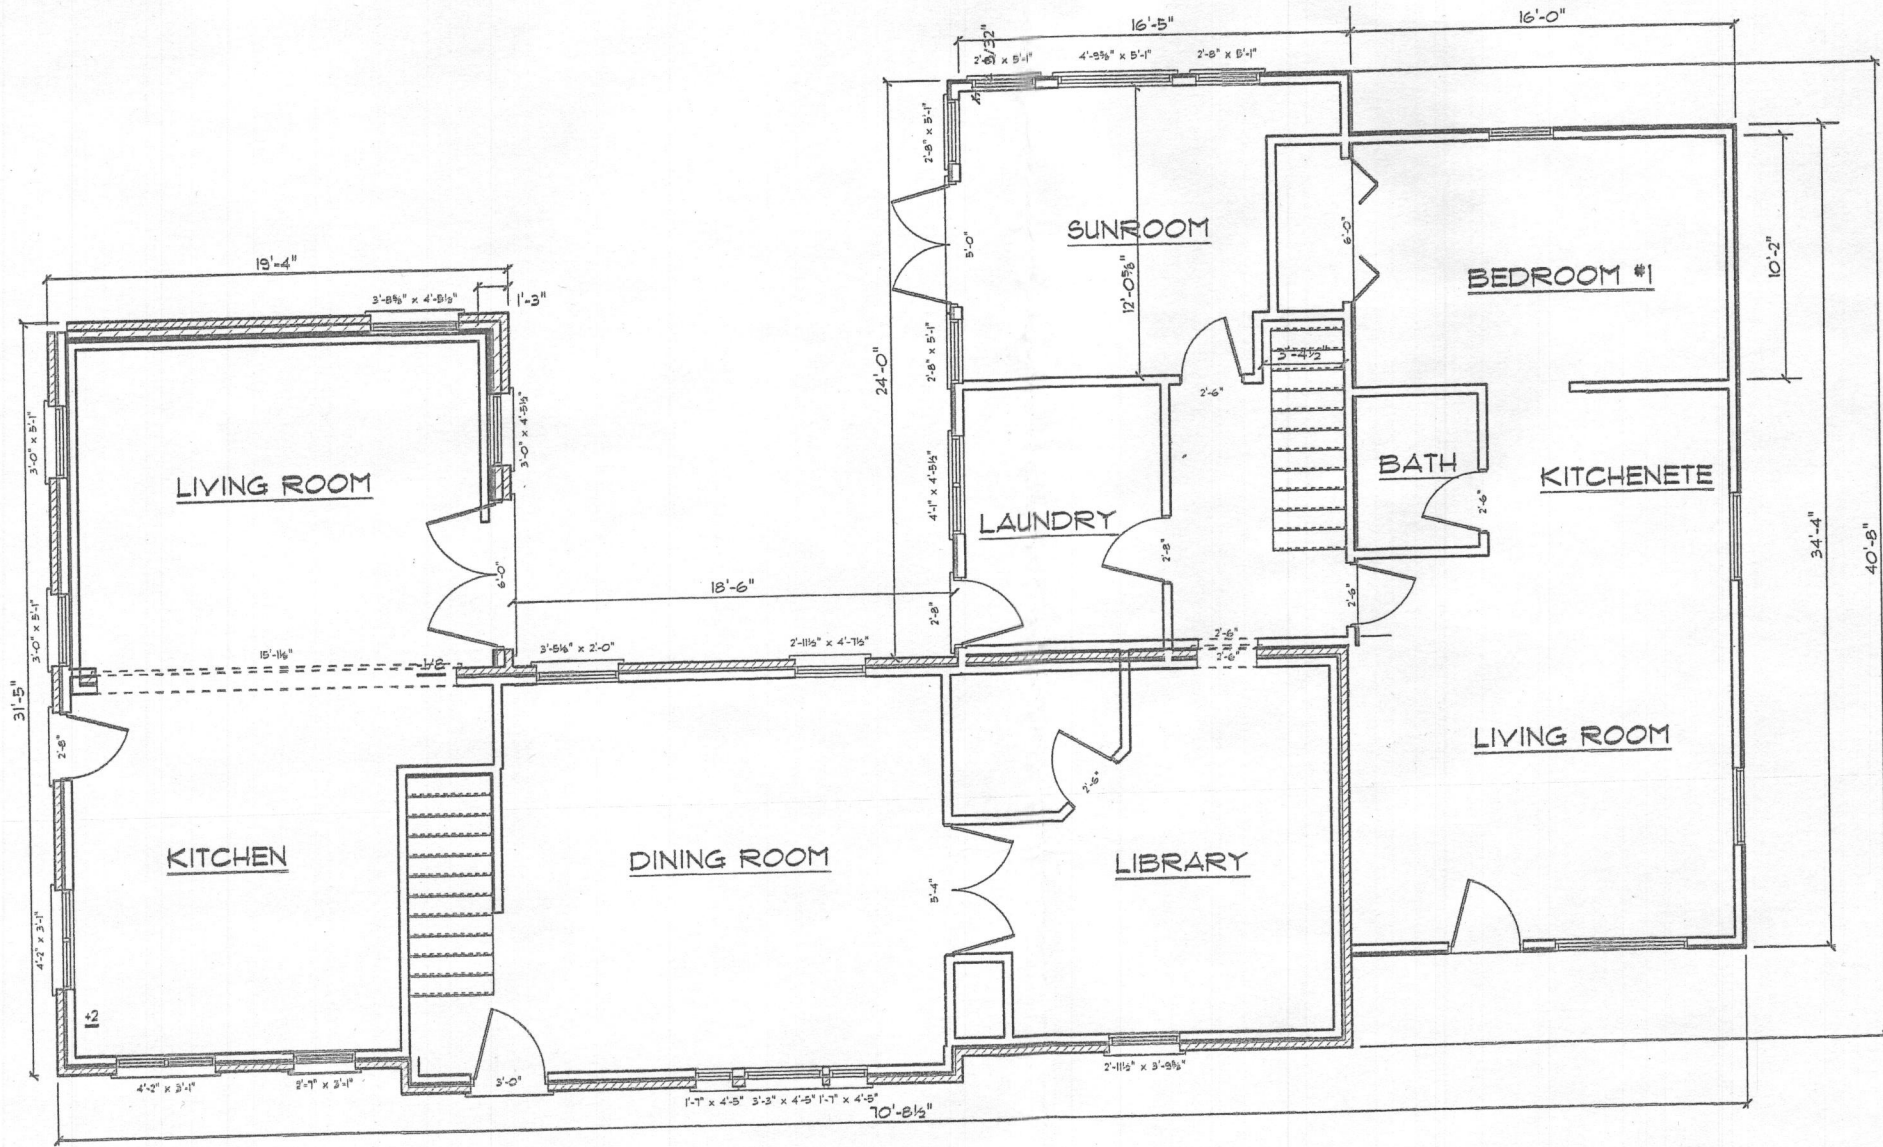

SPRINGBROOK
 Home Improvements
 8670 Reservoir Road, Fulton, MD
 phone 301.604.6909 Fax 301.604.6956
 Email-Malanoski@verizon.net

Existing First Floor Plan

Rodger and Sally Johnson
 6976 Mink Hollow Road
 Highland

Page # 2

DRAWN BY: MM

SCALE 1/4" = 1'

DATE October 26, 2007