



Building Permit Application

Howard County Maryland
 Department of Inspections, Licenses and Permits
 3430 Court House Drive
 Permits: 410-313-2455
 www.howardcountymd.gov

Date Received: _____

Permit No.: _____

Building Address: 11030 Fuzzy Hollow Way
 City: Marietta State: MD Zip Code: 21104
 Suite/Apt. # _____ SDP/WP/BA #: _____
 Census Tract: _____ Subdivision: _____
 Section: _____ Area: _____ Lot: 6
 Tax Map: _____ Parcel: _____ Grid: _____
 Zoning: _____ Map Coordinates: _____ Lot Size: _____

Property Owner's Name: Timmy Woo
 Address: 11030 Fuzzy Hollow Way
 City: Marietta State: MD Zip Code: 21104
 Phone: _____ Fax: _____
 Email: _____

Applicant's Name & Mailing Address, (If other than stated herein)
 Applicant's Name: Josh Simpson
 Address: SAB
 City: _____ State: _____ Zip Code: _____
 Phone: _____ Fax: _____
 Email: _____

Existing Use: SFD
 Proposed Use: SFD
 Estimated Construction Cost: \$ 8,500
 Description of Work: Construct 29x14 deck w/STEPS

Contractor Company: Fence & Deck Connection
 Contact Person: Josh Simpson
 Address: 6057 Veterans Hwy
 City: Millersville State: MD Zip Code: 21108
 License No.: 45780
 Phone: 410-969-4444 Fax: _____
 Email: permit@fenceanddeckconnect.com

Occupant/Tenant Name: _____
 Was tenant space previously occupied? Yes No
 Contact Name: _____
 Address: _____
 City: _____ State: _____ Zip Code: _____
 Phone: _____ Fax: _____
 Email: _____

Engineer/Architect Company: _____
 Responsible Design Prof.: _____
 Address: _____
 City: _____ State: _____ Zip Code: _____
 Phone: _____ Fax: _____
 Email: _____

Commercial Building Characteristics	Residential Building Characteristics	
Height:	<input checked="" type="checkbox"/> SF Dwelling	<input type="checkbox"/> SF Townhouse
No. of stories:	Depth Width	
Gross area, sq. ft./floor:	1 st floor:	
	2 nd floor:	
Area of construction (sq. ft.):	Basement:	
	<input type="checkbox"/> Finished Basement	
Use group:	<input type="checkbox"/> Unfinished Basement	
	<input type="checkbox"/> Crawl Space	
Construction type:	<input type="checkbox"/> Slab on Grade	
<input type="checkbox"/> Reinforced Concrete	No. of Bedrooms:	
<input type="checkbox"/> Structural Steel	Multi-family Dwelling	
<input type="checkbox"/> Masonry	No. of efficiency units:	
<input type="checkbox"/> Wood Frame	No. of 1 BR units:	
<input type="checkbox"/> State Certified Modular	No. of 2 BR units:	
	No. of 3 BR units:	
	Other Structure:	
	Dimensions:	
<input checked="" type="checkbox"/> Roadside Tree Project Permit	Footings:	
<input type="checkbox"/> Yes <input checked="" type="checkbox"/> No	Roof:	
Roadside Tree Project Permit #	<input type="checkbox"/> State Certified Modular	
	<input type="checkbox"/> Manufactured Home	

Utilities	
Electric:	<input checked="" type="checkbox"/> Yes <input type="checkbox"/> No
Gas:	<input type="checkbox"/> Yes <input checked="" type="checkbox"/> No
Water Supply	
<input type="checkbox"/> Public	
<input type="checkbox"/> Private	
Sewage Disposal	
<input type="checkbox"/> Public	
<input type="checkbox"/> Private	
Heating System	
<input type="checkbox"/> Electric	<input type="checkbox"/> Oil
<input type="checkbox"/> Natural Gas	<input type="checkbox"/> Propane Gas
<input type="checkbox"/> Other:	
Sprinkler System:	
<input type="checkbox"/> Yes	<input checked="" type="checkbox"/> No
Grading Permit Number:	
Building Shell Permit Number:	

THE UNDERSIGNED HEREBY CERTIFIES AND AGREES AS FOLLOWS: (1) THAT HE/SHE IS AUTHORIZED TO MAKE THIS APPLICATION; (2) THAT THE INFORMATION IS CORRECT; (3) THAT HE/SHE WILL COMPLY WITH ALL REGULATIONS OF HOWARD COUNTY WHICH ARE APPLICABLE THERETO; (4) THAT HE/SHE WILL PERFORM NO WORK ON THE ABOVE REFERENCED PROPERTY NOT SPECIFICALLY DESCRIBED IN THIS APPLICATION; (5) THAT HE/SHE GRANTS COUNTY OFFICIALS THE RIGHT TO ENTER ONTO THIS PROPERTY FOR THE PURPOSE OF INSPECTING THE WORK PERMITTED AND POSTING NOTICES.

Applicant's Signature: _____
 Email Address: permit@fenceanddeckconnect.com
 Title/Company: _____

Print Name: Josh Simpson
 Date: 11/9/17

Checks Payable to: DIRECTOR OF FINANCE OF HOWARD COUNTY
 PLEASE WRITE NEATLY & LEGIBLY
 -FOR OFFICE USE ONLY-

AGENCY	DATE	SIGNATURE OF APPROVAL
State Highways		
Building Officials		
PSZA (Zoning)		
PSZA (Engineering)		
Health	<u>11-9-17</u>	<u>[Signature]</u>
Is Sediment Control approval required for issuance? <input type="checkbox"/> Yes <input type="checkbox"/> No		
<input type="checkbox"/> CONTINGENCY CONSTRUCTION START		

DPZ SETBACK INFORMATION
Front:
Rear:
Side:
Side St.:
All minimum setbacks met? <input type="checkbox"/> Yes <input type="checkbox"/> No
Is Entrance Permit Required? <input type="checkbox"/> Yes <input type="checkbox"/> No
Historic District? <input type="checkbox"/> Yes <input type="checkbox"/> No
Lot Coverage for New Town Zone:
SDP/Red-line approval date:

Filing Fee	\$
Permit Fee	\$
Tech Fee	\$
Excise Tax	\$
PSFS	\$
Guaranty Fund	\$
Add'l per Fee	\$
Total Fees	\$
Sub-Total Paid	\$
Balance Due	\$
Check	#

Distribution of Copies: White: Building Officials Green: PSZA,Zoning Yellow: PSZA,Engineering Pink: Health Gold: SHA


WOODFORD DRIVE
(PUBLIC - LOCAL)
50' RW

FUZZY HOLLOW WAY
(PRIVATE STREET)
VARIABLE WIDTH RW

APPROVED
WALK-THRU BUILDING PERMIT

- NOTES:
1. ACCURACY OF BUILDING MEASUREMENTS: 0.1'
 2. ACCURACY OF SETBACK DIMENSIONS: 0.3'
 3. ACCURACY OF ELEVATIONS: 0.1'
 4. THE PROPERTY SHOWN HEREON LIES IN ZONE "X" AS SHOWN ON FLOOD INSURANCE RATE MAP NO. 24027C0060D DATED: 11/06/2013.
 5. BEARINGS AND DISTANCES SHOWN HEREON ARE FROM A SUBDIVISION PLAT ENTITLED "MELCHIOR PROPERTY, LOTS 3 THROUGH 6 AND NONBUILDABLE PRESERVATION PARCEL A" SHEETS 1-5 OF 5, RECORDED IN PLATS #22758-22762


DATE: 11-9-11
with
Steps
Approved
Shown

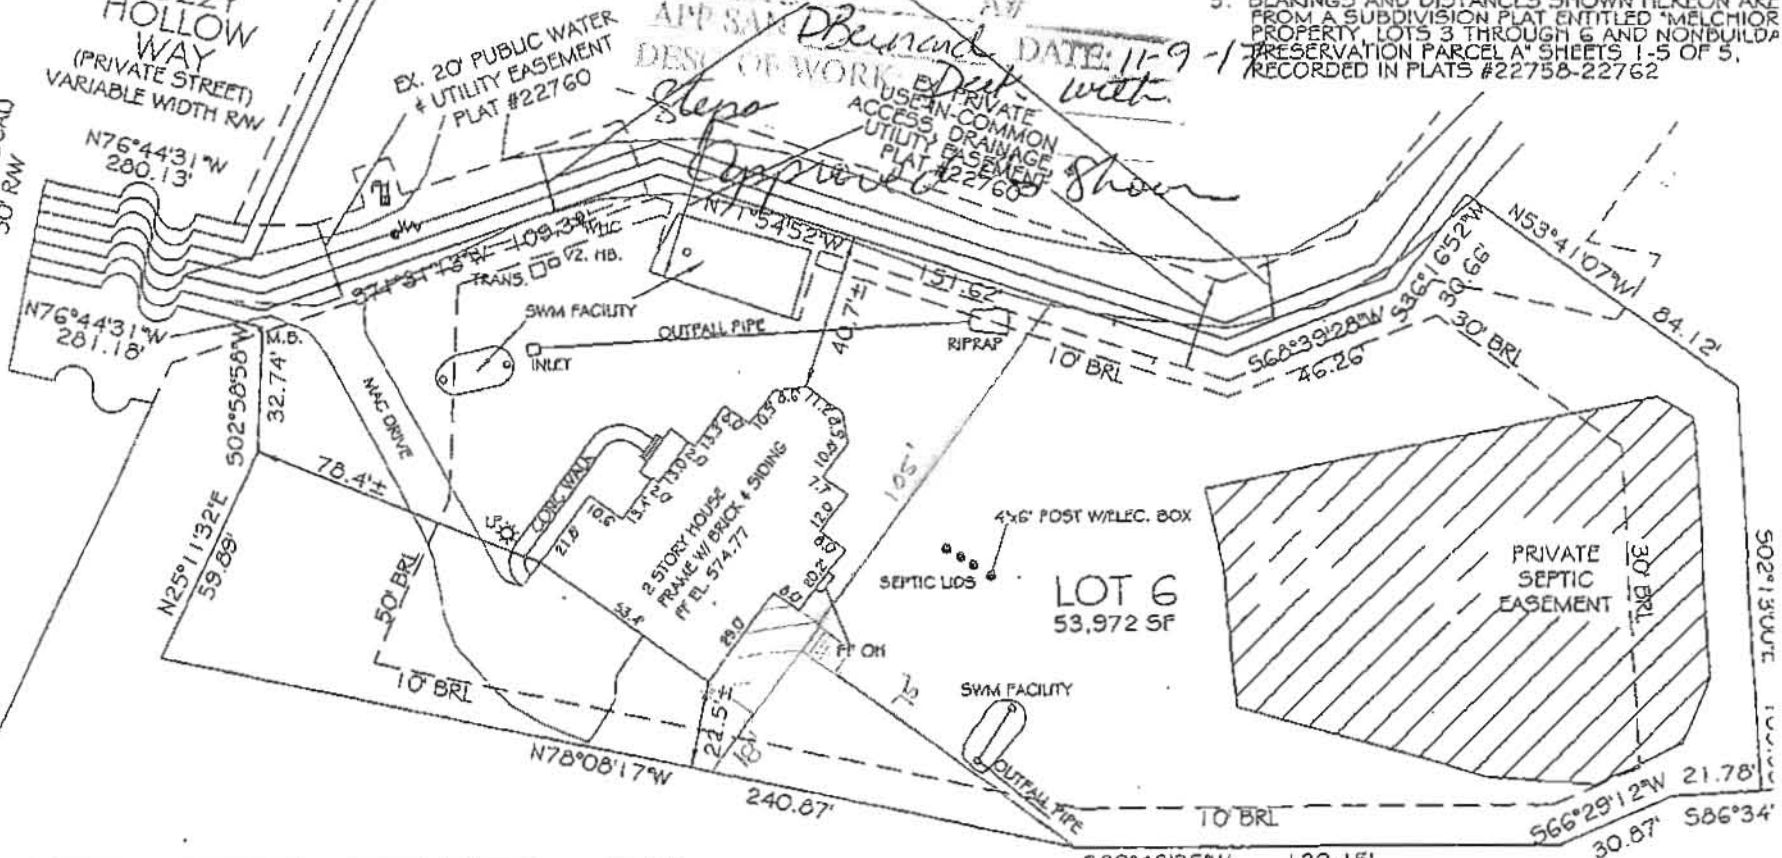

THE INFORMATION SHOWN HAS BEEN ESTABLISHED BY CURRENT ACCEPTABLE SURVEY PROCEDURES AND FROM AVAILABLE RECORD INFORMATION. THIS DRAWING IS NOT TO BE USED FOR THE ESTABLISHMENT OF PROPERTY LINES, LOCATION OF FENCES, GARAGES, BUILDINGS, OR OTHER FUTURE IMPROVEMENTS. IT WAS PREPARED UNDER MY DIRECT SUPERVISION AND REVIEW IN ACCORDANCE WITH SEC. 09.13.06.06 OF THE ANNOTATED CODE OF MD.

G. Scott Shanaberger
G. SCOTT SHANABERGER PROFESSIONAL LAND SURVEYOR
LICENSE EXPIRATION DATE 4/2/2018
SHANABERGER & LANE
8726 TOWN AND COUNTRY BLVD., SUITE 201 LAND SURVEYOR
ELLCOTT CITY, MD. 21043
(410)461-9563 FAX: (410)461-9693

FINAL LOCATION DRAWING
LOT 6 MELCHIOR PROPERTY
11130 FUZZY HOLLOW WAY
PLAT # 22758-22762
TAX MAP 10 GRID 13 PARCEL 184
3rd ELECTION DISTRICT HOWARD COUNTY,
SCALE: 1"=50' DATE: 11/23/2016

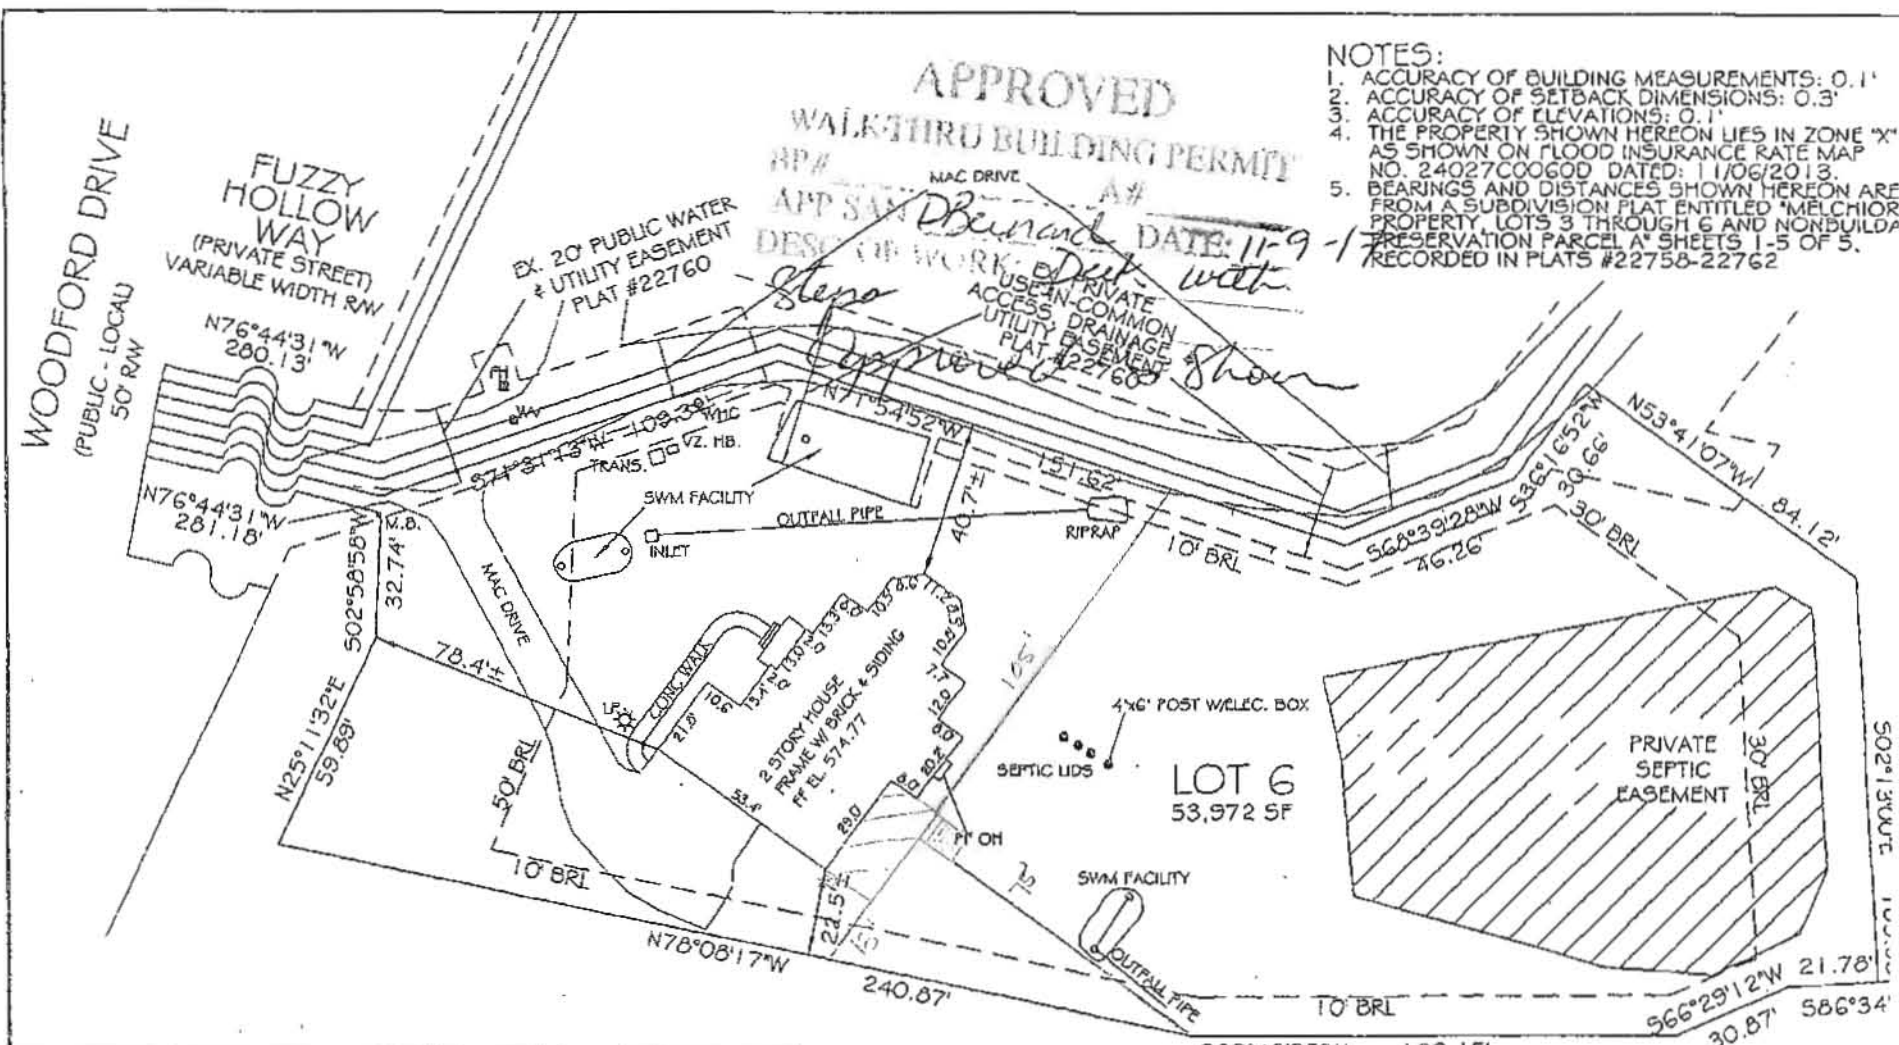

- NOTES:
1. ACCURACY OF BUILDING MEASUREMENTS: 0.1'
 2. ACCURACY OF SETBACK DIMENSIONS: 0.3'
 3. ACCURACY OF ELEVATIONS: 0.1'
 4. THE PROPERTY SHOWN HEREON LIES IN ZONE "X" AS SHOWN ON FLOOD INSURANCE RATE MAP NO. 24027C0060D DATED: 11/06/2013.
 5. BEARINGS AND DISTANCES SHOWN HEREON ARE FROM A SUBDIVISION PLAT ENTITLED "MELCHIOR PROPERTY, LOTS 3 THROUGH 6 AND NONBUILDABLE PRESERVATION PARCEL A" SHEETS 1-5 OF 5, RECORDED IN PLATS #22758-22762

APPROVED
 WALKTHRU BUILDING PERMIT
 RP# _____ MAC DRIVE _____ A# _____
 APP SAN Bernard DATE: 11-9-17
 DESCRIBED WORK: Deck with steps
 USE IN PRIVATE ACCESS COMMON UTILITY DRAINAGE PLAT #22760

THE INFORMATION SHOWN HAS BEEN ESTABLISHED BY CURRENT ACCEPTABLE SURVEY PROCEDURES AND FROM AVAILABLE RECORD INFORMATION. THIS DRAWING IS NOT TO BE USED FOR THE ESTABLISHMENT OF PROPERTY LINES, LOCATION OF FENCES, GARAGES, BUILDINGS, OR OTHER FUTURE IMPROVEMENTS. IT WAS PREPARED UNDER MY DIRECT SUPERVISION AND REVIEW IN ACCORDANCE WITH SEC. 09.13.06.06 OF THE ANNOTATED CODE OF MICHIGAN.

G. Scott Shanaberger
 G. SCOTT SHANABERGER PROFESSIONAL LAND SURVEYOR
 LICENSE EXPIRATION DATE 4/2/2018
 SHANABERGER & LANE
 8726 TOWN AND COUNTRY BLVD., SUITE 201 LAND SURVEYOR
 ELICOTT CITY, MD. 21043
 (410)461-9563 FAX: (410)461-9693

FINAL LOCATION DRAWING
 LOT 6 MELCHIOR PROPERTY
 11130 FUZZY HOLLOW WAY
 PLAT # 22758-22762
 TAX MAP 10 GRID 13 PARCEL 184
 3rd ELECTION DISTRICT HOWARD COUNTY,
 SCALE: 1"=50' DATE: 11/23/2016

1=50