


INDICATE NORTH - NAME ADJOINING ROADWAY AS BASE LINE  
Rt 97

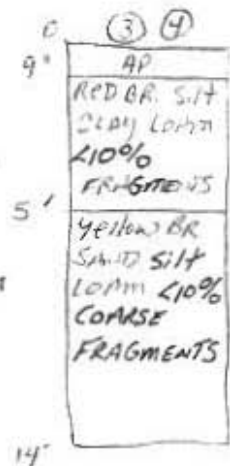

DATE	TEST NO.	DEPTH	PRE-WET		TEST - 1" DROP		TIME	
			START	STOP	START	STOP		
2/20/86	1 S	4.5'	9:58	10:00	10:00	10:03	3min	
	1 m	8.5'	10:37	10:39	10:39	10:42	3min	
	1 V	14'	uniform soil structure below 4'					
	2 S	5'	10:04	10:08	10:08	10:13	5min	
	2 V	14'	same as hole #1					
	3 S	5.5'	10:16	10:19	10:19	10:24	5min	
	3 V	14'	uniform soil below 5'					
	4 S	6'	10:26	10:29	10:29	10:35	6min	
	4 V	14'	same as #3					
	A	CLAY TO 8'	ABANDONED - WATER ENTERING HOLE FROM SATURATED CLAY ZONE					
	B	SOLID ROCK AT 9'; FRACKURED ROCK AT 5.5'						
	C	CLAY TO 6'	WATER ENTERING HOLE FROM SATURATED CLAY ZONE					

EH-12-1079

REMARKS \_\_\_\_\_

TYPE OF SOIL \_\_\_\_\_

TESTED BY S. Abel ALSO PRESENT SKIP, CRAIG