


CHAO-LIU RESIDENCE
5007 CRAPE MYRTLE CT
ELLIOTT CITY, MD 21042

PRO-BUILT CONSTRUCTION, INC.
13330 CLARKSVILLE PIKE
HIGHLAND, MD 20777

WALNUT CREEK
LOT 60

SCALE 1" = 60'

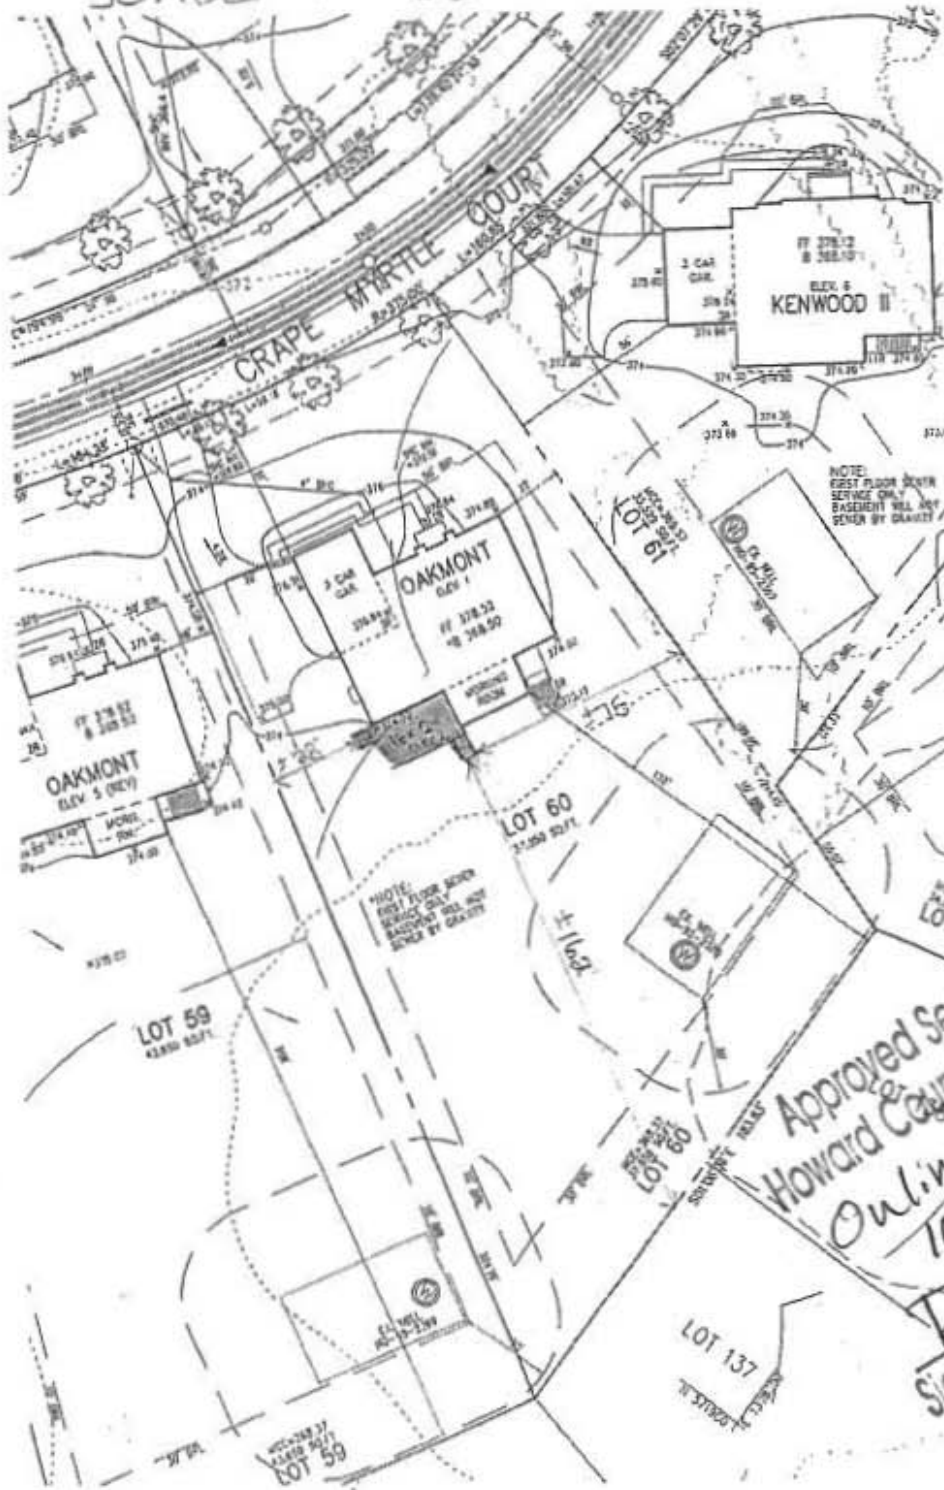

Approved Septic System Plan
Howard County Health Department
Online Permit for Deck
16' x 24' x 5' with 2 sets Stairs
B. B. B. B.
Signature as illustrated Date
B18001048

B18001048 - online

OK' R. Bucher, Health Dept.
4/6/2018

Name *
 CHAO WEI
 Address Line 1
 5007 CRAPE MYRTLE CT
 Address Line 2
 Address Line 3
 Mail City Mail State Mail Zip Code
 ELLICOTT CITY MD 21042
 Phone Primary
 978-697-5093 Yes
 E-mail
 Cell Number Fax Number

Professionals (This section is not required.)

Search Reset Clear

License # * Business Name
 08010020247 PRO BUILT CONSTRUCTION
 License Type * First Name Middle Name Last Name
 MHIC Ind EDWARD PACYLOWSKI
 Primary Address Line 1
 Yes 13330 CLARKSVILLE PIKE
 Address Line 2
 City State ZIP Code
 HIGHLAND MD 20777-9701
 Phone 1 Phone 2 Fax
 3018540821 3018549632
 E-mail
 EDWARD@PROBUILTCONSTRUCTION.COM

Applicant (This section is not required.)

Search As Owner As Lic. Prof As Contact

Type * First Name MI Last Name
 Applicant EDWARD PACYLOWSKI
 Relationship Full Name
 Applicant EDWARD PACYLOWSKI
 Primary Organization Name
 Yes PRO BUILT CONSTRUCTION
 Street Address
 13330 CLARKSVILLE PIKE
 Address Line 2
 City State Zip Code
 HIGHLAND MD 20777-9701
 Phone Cell Fax
 3018540821 3018549632
 E-mail *
 EDWARD@PROBUILTCONSTRUCTION.COM

Addtl Info

Est Construction Cost * Housing Units * Number of Buildings * Public Owned
 15000 0 0 No
 Construction Type

Menu Save Reset Cancel Help

Record Detail * (This section is required.)

Permit Type	Permit Number	Opened Date
Building/Residential/Misc/Deck	B18001048	04/05/2018
Description of Work		
SFD/ CONSTRUCT 16' X 24' X 5' OPEN DECK WITH STEPS		

check spelling

Address * (This section is required.)

Search Reset Clear Get Parcel & Owner

Street #	Street Name	Street Type	
5007	CRAPE MYRTLE	CT	
Unit Type	Unit #	X Coordinate	Y Coordinate
--Select--		-76.94443	39.23738
City	State	Zip Code	Primary
ELLCOTT CITY	MD	21042	Yes

Parcel * (This section is required.)

Search Reset Clear Get Address & Owner

GIS ID *	Parcel	Parcel Area	Land Value	Improved Value	Exemption Value	Plan Area
1101196	49	37850	338400	1185800	847400	RURAL

Legal Description
IMPSLOT 60 37,850 SQ [5007 CRAPE MYRTLE CT] WALNUT CREEK PHASE 2

check spelling

Block	Lot	Census Tract	Council Dist	Supervisor Dist	Map #	DAP Zone	Primary
	80	605101	5				Yes

Plan Area	State Tax Id	Subdivision Name
	1405595201	Walnut Creek

Section	Area	Tax Map
		28

Grid	Zoning District	ADC Map
28-12	RC-DEO	4933-J3

SDP No.	Final Plan No.	WP File No.
	F-07-076	

Record Plat No.	WS Contract No.	FDP No.
22227-2224		

Owner Occupied	Year Built	Historic District
<input type="radio"/> Yes <input type="radio"/> No	2015	<input type="radio"/> Yes <input checked="" type="radio"/> No

Historic District Registry No.	Stat Area	Flood Plain
	5-02A	<input type="radio"/> Yes <input checked="" type="radio"/> No

Building No

Owner * (This section is required.)

Search Reset Clear