


Online Submission

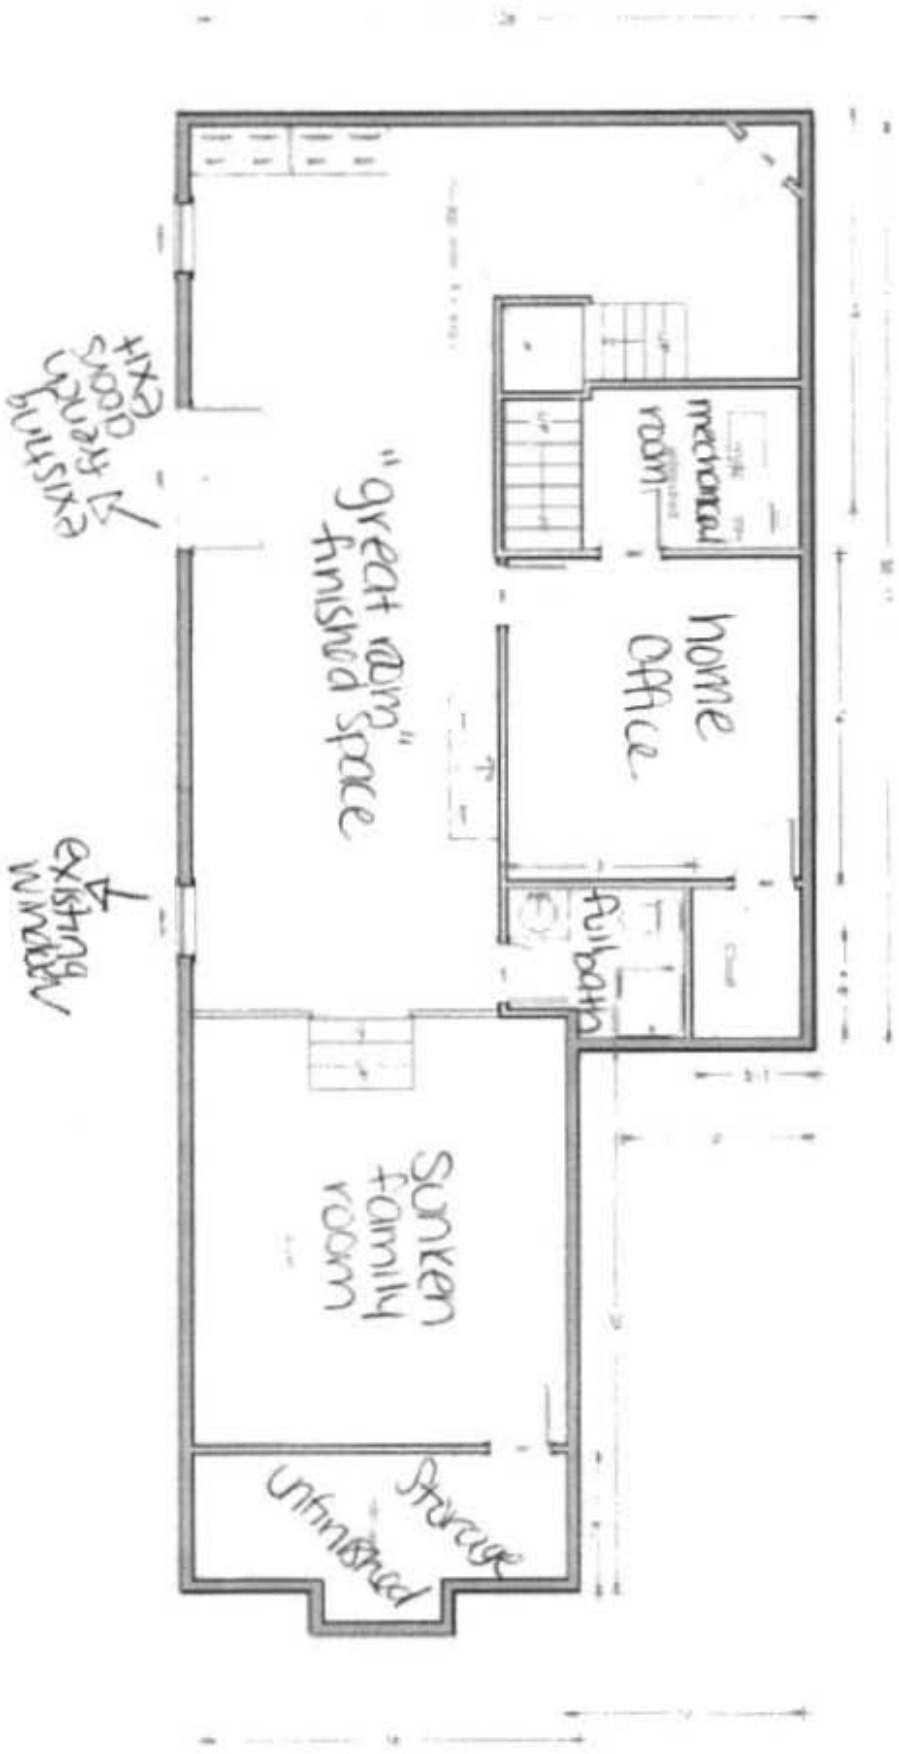

DUBERWELN Basement Layout