

Menu Save Reset Cancel Help

Record Detail * (This section is required)

Permit Type	Permit Number	Opened Date
Building/Residential/Misc/Porch	B18001454	05/03/2018
Description of Work		
SFD/CONSTRUCT 14'X18' SCREENED IN PORCH ON EXISTING DECK		

[check spelling](#)

Address * (This section is required)

Search Reset Clear Get Parcel & Owner

Street #	Street Name	Street Type	
12217	HAYLAND FARM	WAY	
Unit Type	Unit #	X Coordinate	Y Coordinate
--Select--		-76.95197	39.24024
City	State	Zip Code	Primary
ELLCOTT CITY	MD	21042	Yes

APPROVED
WALK-THRU BUILDING PERMIT
 BP# _____ A# _____
 APP. SAN Robert Freeman DATE: 5/9/18
 DESC. OF WORK: Screened porch
on existing deck, 14' x 18'

Parcel * (This section is required)

Search Reset Clear Get Address & Owner

GIS ID *	Parcel	Parcel Area	Land Value	Improved Value	Exemption Value	Plan Area
1104072	49	33234	333800	1283700	949900	RURAL
Legal Description						
IMPSLOT 87 33,234 SQ[] 12217 HAYLAND FARM WAY[] WALNUT CREEK PHASE 3						

[check spelling](#)

Block	Lot	Census Tract	Council Dist	Supervisor Dist	Map #	DAP Zone	Primary
	87	605101	5				Yes
Plan Area	State Tax Id	Subdivision Name					
	1405597896	Walnut Creek					
Section	Area	Tax Map					
		28					
Grid	Zoning District	ADC Map					
28-11	RC-DEO	4933-H2					
SDP No.	Final Plan No.	WP File No.					
	F-07-076						
Record Plat No.	WS Contract No.	FDP No.					
23233-2324							
Owner Occupied	Year Built	Historic District					
<input type="radio"/> Yes <input checked="" type="radio"/> No		<input type="radio"/> Yes <input checked="" type="radio"/> No					
Historic District Registry No.	Stat Area	Flood Plain					
	5-02A	<input type="radio"/> Yes <input checked="" type="radio"/> No					
Building No							

Owner * (This section is required.)

Search Reset Clear

Name *

SAJEWICZ CHRISTOPHER M

Address Line 1

12217 HAYLAND FARM WAY

Address Line 2

Address Line 3

Mail City Mail State Mail Zip Code

ELLICOTT CITY MD 21042

Phone Primary

202-258-0658 Yes

E-mail

Cell Number Fax Number

Professionals (This section is not required.)

Search Reset Clear

License # * Business Name

08010020247 PRO BUILT CONSTRUCTION

License Type * First Name Middle Name Last Name

MHIC Ind EDWARD PACYLOWSKI

Primary Address Line 1

Yes 13330 CLARKSVILLE PIKE

Address Line 2

City State ZIP Code

HIGHLAND MD 20777-9701

Phone 1 Phone 2 Fax

3018540821 3018549632

E-mail

EDWARD@PROBUILTCONSTRUCTION.COM

Applicant (This section is not required.)

Search As Owner As Lic. Prof As Contact

Type * First Name MI Last Name

Applicant EDWARD PACYLOWSKI

Relationship Full Name

Applicant EDWARD PACYLOWSKI

Primary Organization Name

Yes PRO BUILT CONSTRUCTION

Street Address

13330 CLARKSVILLE PIKE

Address Line 2

City State Zip Code

HIGHLAND MD 20777-9701

Phone Cell Fax

3018540821 3018549632

E-mail *

EDWARD@PROBUILTCONSTRUCTION.COM

Addl Info

Est Construction Cost *	Housing Units *	Number of Buildings *	Public Owned
<input type="text" value="15000"/>	<input type="text" value="0"/>	<input type="text" value="0"/>	<input type="text" value="No"/>
Construction Type			
<input type="text" value="434 - Additions, Alterations, and Conversions - Residential"/>			

PORCH INFORMATION

PORCH INFORMATION

Capital Project-No Fee *	Capital Project Number	Fee Exempt *	Roadside Tree Project Permit *	Roadside Tree Project Permit #
<input type="radio"/> Yes <input checked="" type="radio"/> No	<input type="text"/>	<input type="radio"/> Yes <input checked="" type="radio"/> No	<input type="radio"/> Yes <input checked="" type="radio"/> No	<input type="text"/>
Existing Use *	Type of Porch *	Type of Porch Foundation *	Total Square Footage *	
<input type="text" value="SFD"/>	<input type="text" value="Screened Porch"/>	<input type="text" value="Existing Deck"/>	<input type="text" value="252"/> SQFT	
Water Supply	Sewage Disposal	Expiration Date		
<input type="text" value="Private"/>	<input type="text" value="Private"/>	<input type="text" value="10/31/2018"/>		

PAYMENT INFORMATION


Check 1	Payee 1	Check 2	Payee 2	SAP Doc No	SAP Entered
<input type="text" value="0"/>	<input type="text" value="ON LINE PAYMENT"/>	<input type="text"/>	<input type="text"/>	<input type="text"/>	<input type="text"/>

Submit Cancel




LOCATION DRAWING
 12217 HAYLAND FARM WAY
 LOT #7
WALNUT CREEK
 LARKSVILLE (46) ELECTION DISTRICT
 HOWARD COUNTY MARYLAND

SCALE 1" = 50'
 MARYLAND STATE PLANE
 DATUM (MAD 83/91)

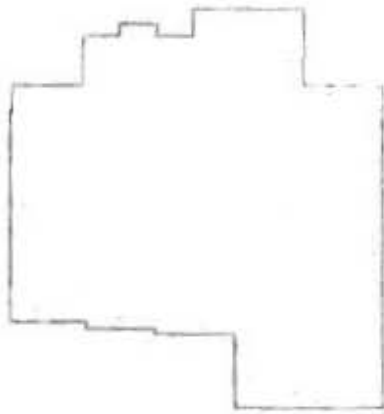

SCALE 1" = 30'

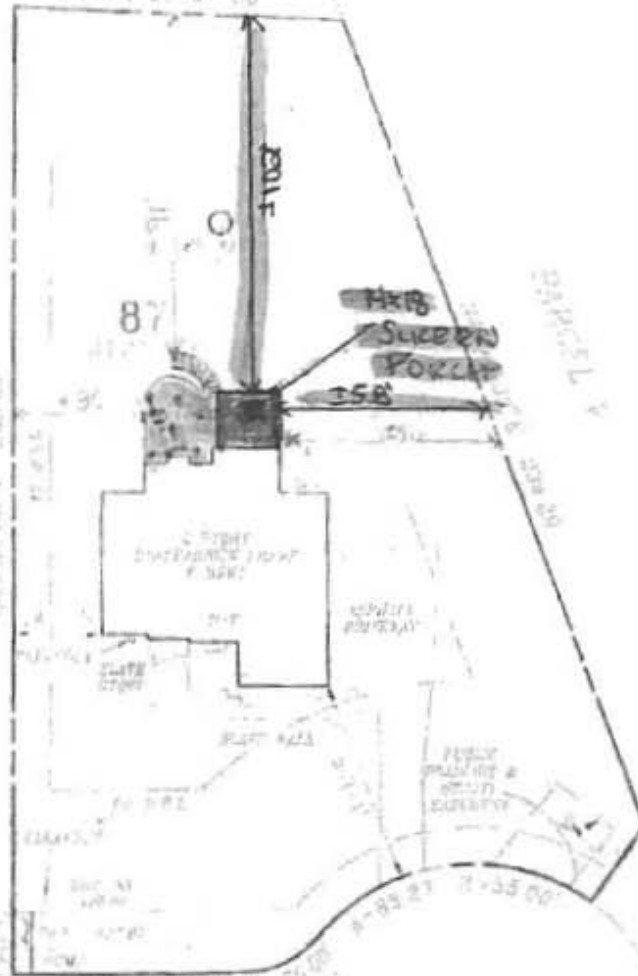

THIS SUBJECT PROPERTY DOES NOT BE WITHIN A FLOOD HAZARD ZONE AS SHOWN ON FOP FLOOD INSURANCE STUDIES

APPROVED

WALK-THRU BUILDING PERMIT

BP# _____ A# _____
 APP. SAN Robert Treason DATE: 5/4/18
 DESC. OF WORK: Screened porch
 on existing deck, 14' x 15'

HAYLAND FARM WAY

ZONE: RR-DEO & RC-DEO

PERMIT NUMBER 815002563

SURVEYORS CERTIFICATE

CPJ Charles P. Johnson & Associates, Inc.
 12217 Hayland Farm Way, Suite 300, Silver Spring, MD 20910, PH: 431-7000, FAX: 301-434-1014
 www.cpj.com - Silver Spring, MD - Gaithersburg, MD - Annapolis, MD - Elkridge, MD - Frederick, MD - P.O. Box, VA

2-10-16

P. B. B. L.

ID	WR	CR	RDB	RDB
09-10-2015				
1	09	03	791	8887

Dwg: N:\43354\DWG\880-87 Xref.