

C1 7912

SEQUENCE NO. (MDE USE ONLY)

STATE OF MARYLAND WELL COMPLETION REPORT

FILL IN THIS FORM COMPLETELY PLEASE PRINT OR TYPE

THIS REPORT MUST BE SUBMITTED WITHIN 45 DAYS AFTER WELL IS COMPLETED.

COUNTY NUMBER A50387-A

ST/CO USE ONLY DATE RECEIVED

DATE WELL COMPLETED

Depth of Well

PERMIT NO. FROM "PERMIT TO DRILL WELL"

DATE RECEIVED grid

DATE WELL COMPLETED 072396

Depth of Well 345

PERMIT NO. H0-94-0803

OWNER Trinity Custom Homes STREET OR RD Park Overlook Ct TOWN Glenelg SUBDIVISION Benson Branch Est SECTION LOT 15

WELL LOG

Not required for driven wells

STATE THE KIND OF FORMATIONS PENETRATED, THEIR COLOR, DEPTH, THICKNESS AND IF WATER BEARING

Table with columns: DESCRIPTION, FEET (FROM, TO), check if water bearing. Rows include Top Soil, Sandy, Sand Stone, MICKA, Sand Stone, MICKA, Flint Rock, MICKA.

GROUTING RECORD

WELL HAS BEEN GROUTED (Y/N), TYPE OF GROUTING MATERIAL (CEMENT/BENTONITE CLAY), NO. OF BAGS, NO. OF POUNDS, DEPTH OF GROUT SEAL.

CASING RECORD

MAIN CASING TYPE (PL/ST/CO/OT), Nominal diameter top (main) casing, Total depth of main casing.

OTHER CASING (if used)

Table for OTHER CASING with columns for diameter and depth.

SCREEN RECORD

screen type or open hole (ST/BR/PL/HO/OT), insert appropriate code below.

NUMBER OF UNSUCCESSFUL WELLS

WELL HYDROFRACTURED (Y/N)

CIRCLE APPROPRIATE LETTER A WELL WAS ABANDONED AND SEALED WHEN THIS WELL WAS COMPLETED. E ELECTRIC LOG OBTAINED. P TEST WELL CONVERTED TO PRODUCTION WELL.

I HEREBY CERTIFY THAT THIS WELL HAS BEEN CONSTRUCTED IN ACCORDANCE WITH COMAR 26.04.04 "WELL CONSTRUCTION" AND IN CONFORMANCE WITH ALL CONDITIONS STATED IN THE ABOVE CAPTIONED PERMIT...

TYPE: MWD/MSD/MGD DRILLERS LIC. NO. 116

DRILLERS SIGNATURE (Handwritten signature)

SITE SUPERVISOR (sign. of driller or journeyman responsible for sitework if different from permittee)

DEPTH (nearest ft.)

DEPTH grid with handwritten values: 42, 345

GRAVEL PACK IF WELL DRILLED WAS FLOWING WELL INSERT F IN BOX 68

MDE USE ONLY (NOT TO BE FILLED IN BY DRILLER) T (E.R.O.S.) W Q

TELESCOPE CASING LOG INDICATOR OTHER DATA


C 3


PUMPING TEST

HOURS PUMPED (3), PUMPING RATE (4), METHOD USED TO MEASURE PUMPING RATE (Bucket), WATER LEVEL BEFORE/WHEN PUMPING, TYPE OF PUMP USED (S).

PUMP INSTALLED

DRILLER WILL INSTALL PUMP (NO), TYPE OF PUMP INSTALLED, CAPACITY: GALLONS PER MINUTE, PUMP HORSE POWER, PUMP COLUMN LENGTH, CASING HEIGHT (+/-), LAND SURFACE (2).

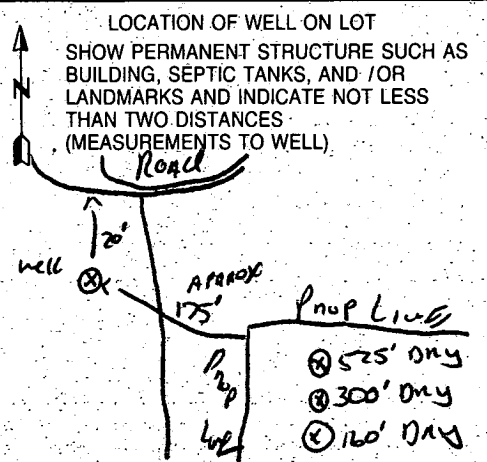

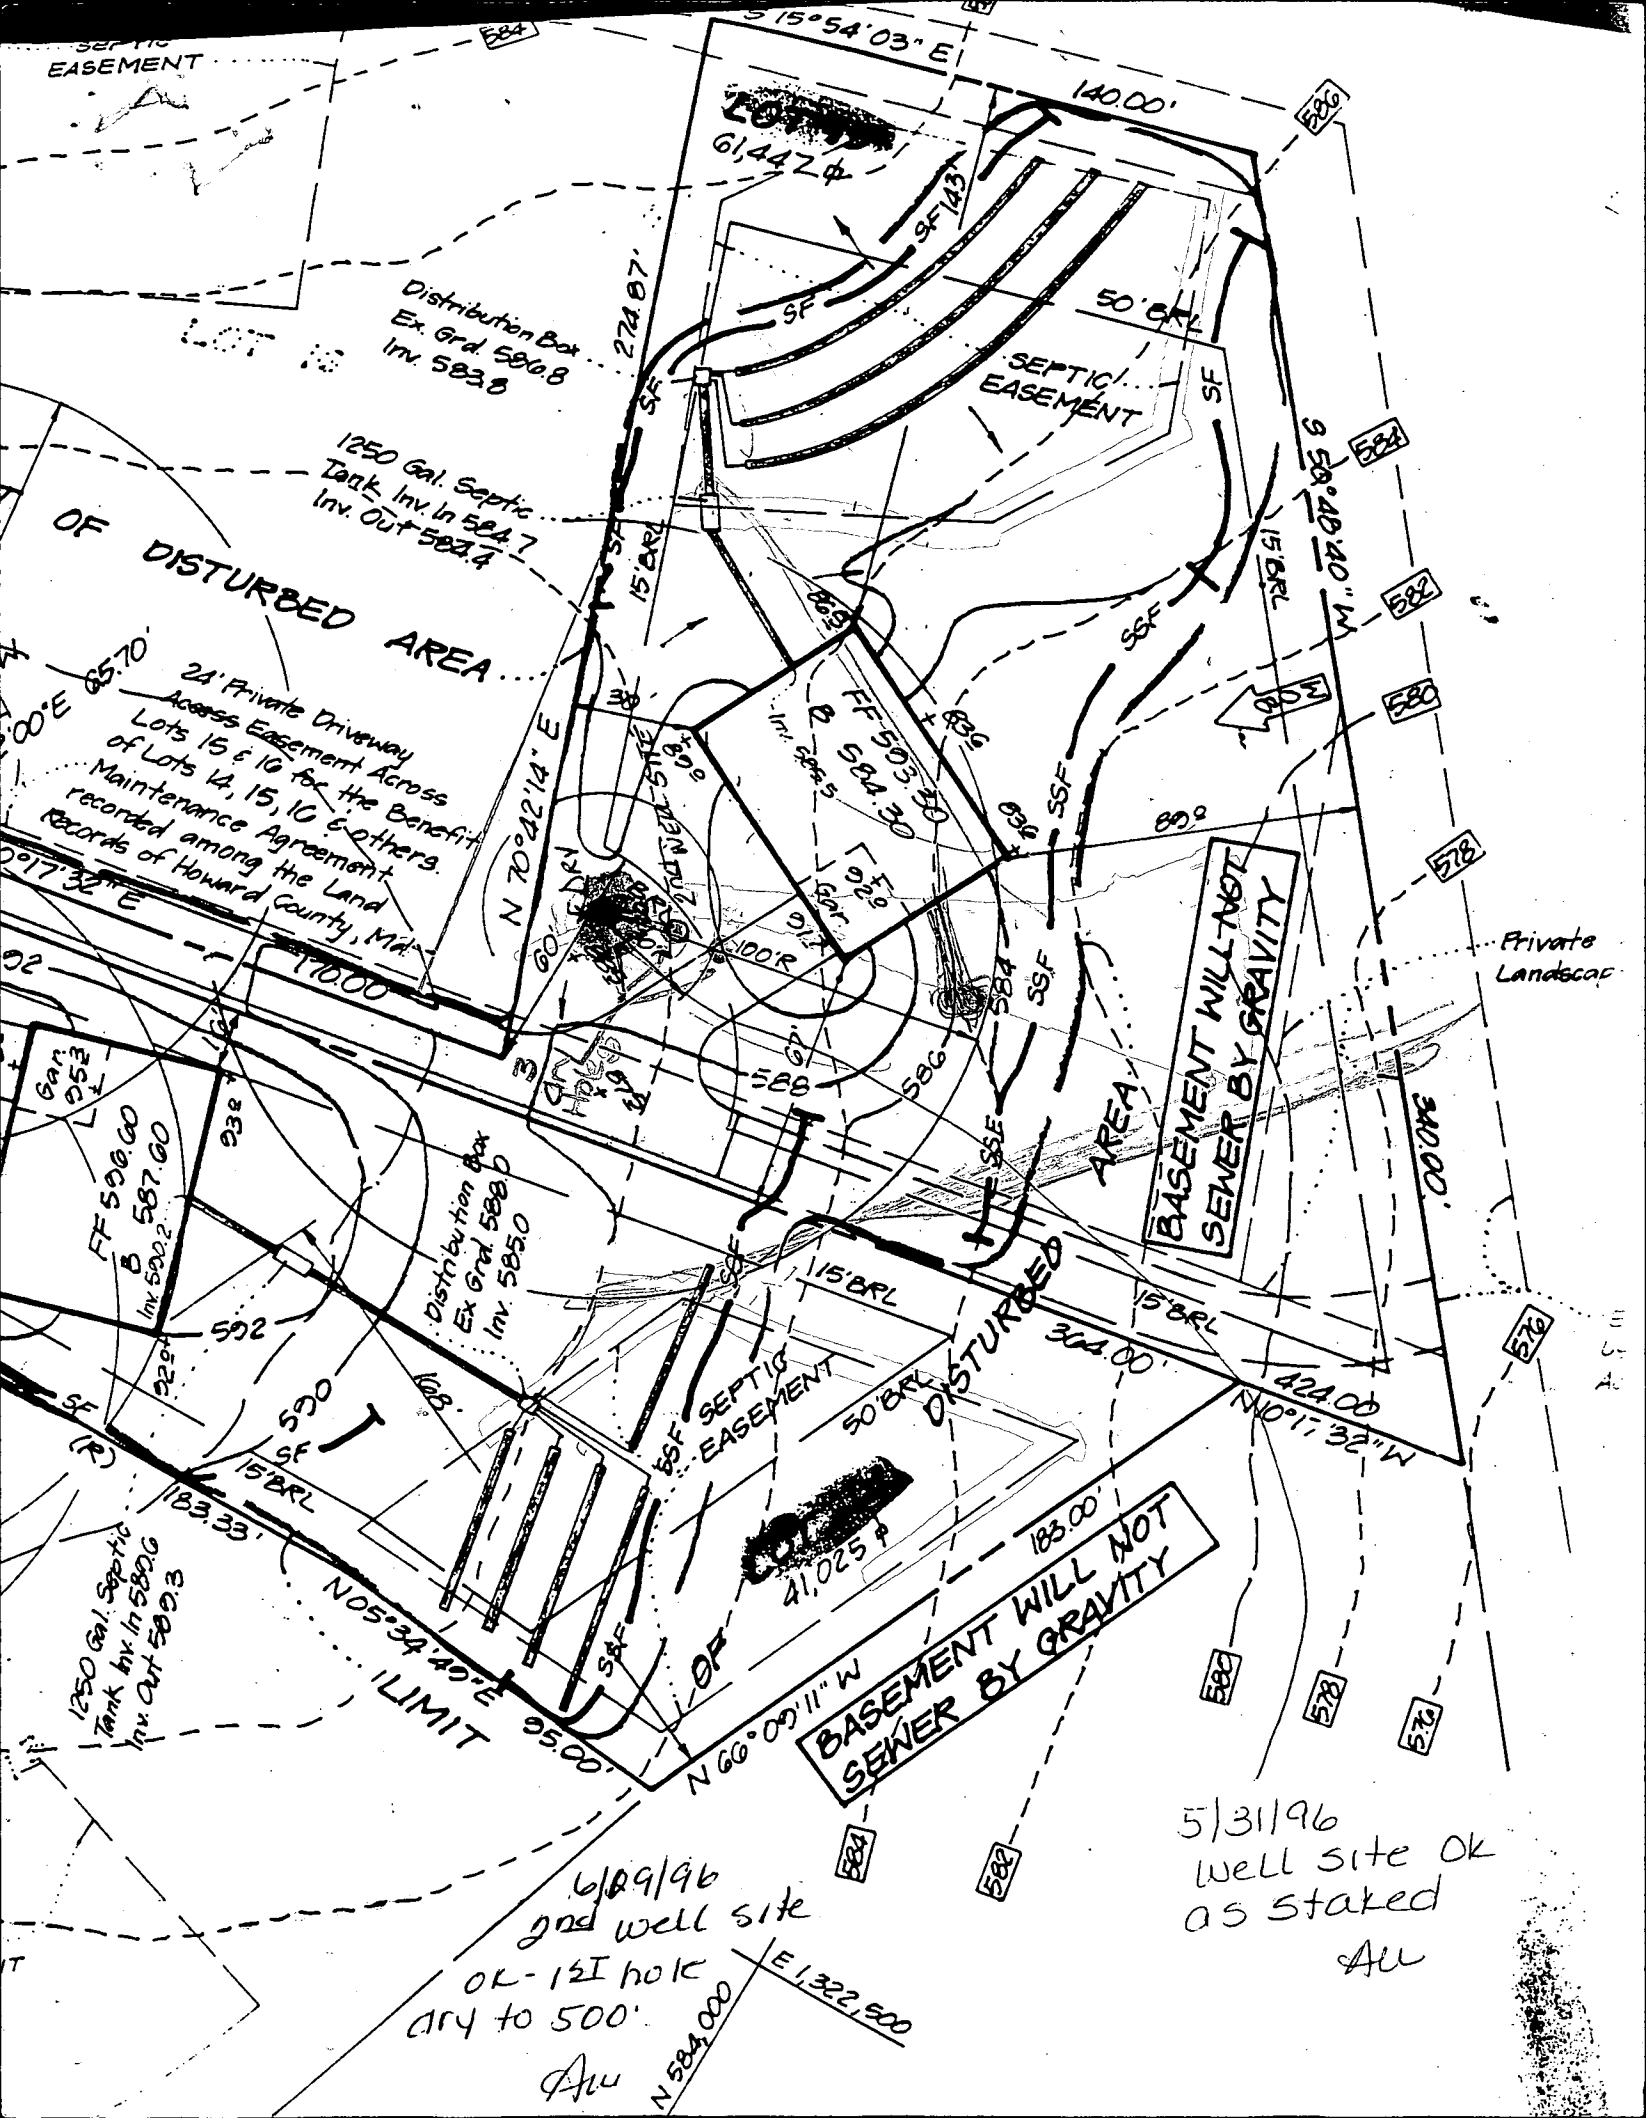

Distribution Box
Ex. Grd. 580.8
Inv. 583.0

1250 Gal. Septic
Tank Inv. In 584.7
Inv. Out 583.4

OF DISTURBED AREA

24' Private Driveway
Access Easement Across
Lots 15 & 16 for the Benefit
of Lots 14, 15, 16 & others.
Maintenance Agreement
recorded among the Land
Records of Howard County, Md.

BASEMENT WILL NOT
SEWER BY GRAVITY

BASEMENT WILL NOT
SEWER BY GRAVITY


Distribution Box
Ex. Grd. 588.0
Inv. 585.0

1250 Gal. Septic
Tank Inv. In 580.6
Inv. Out 580.3

6/29/96
2nd well site
OK - 12" hole
dry to 500'

5/31/96
well site OK
as stated
All

All N 584.000 E 1,322.500

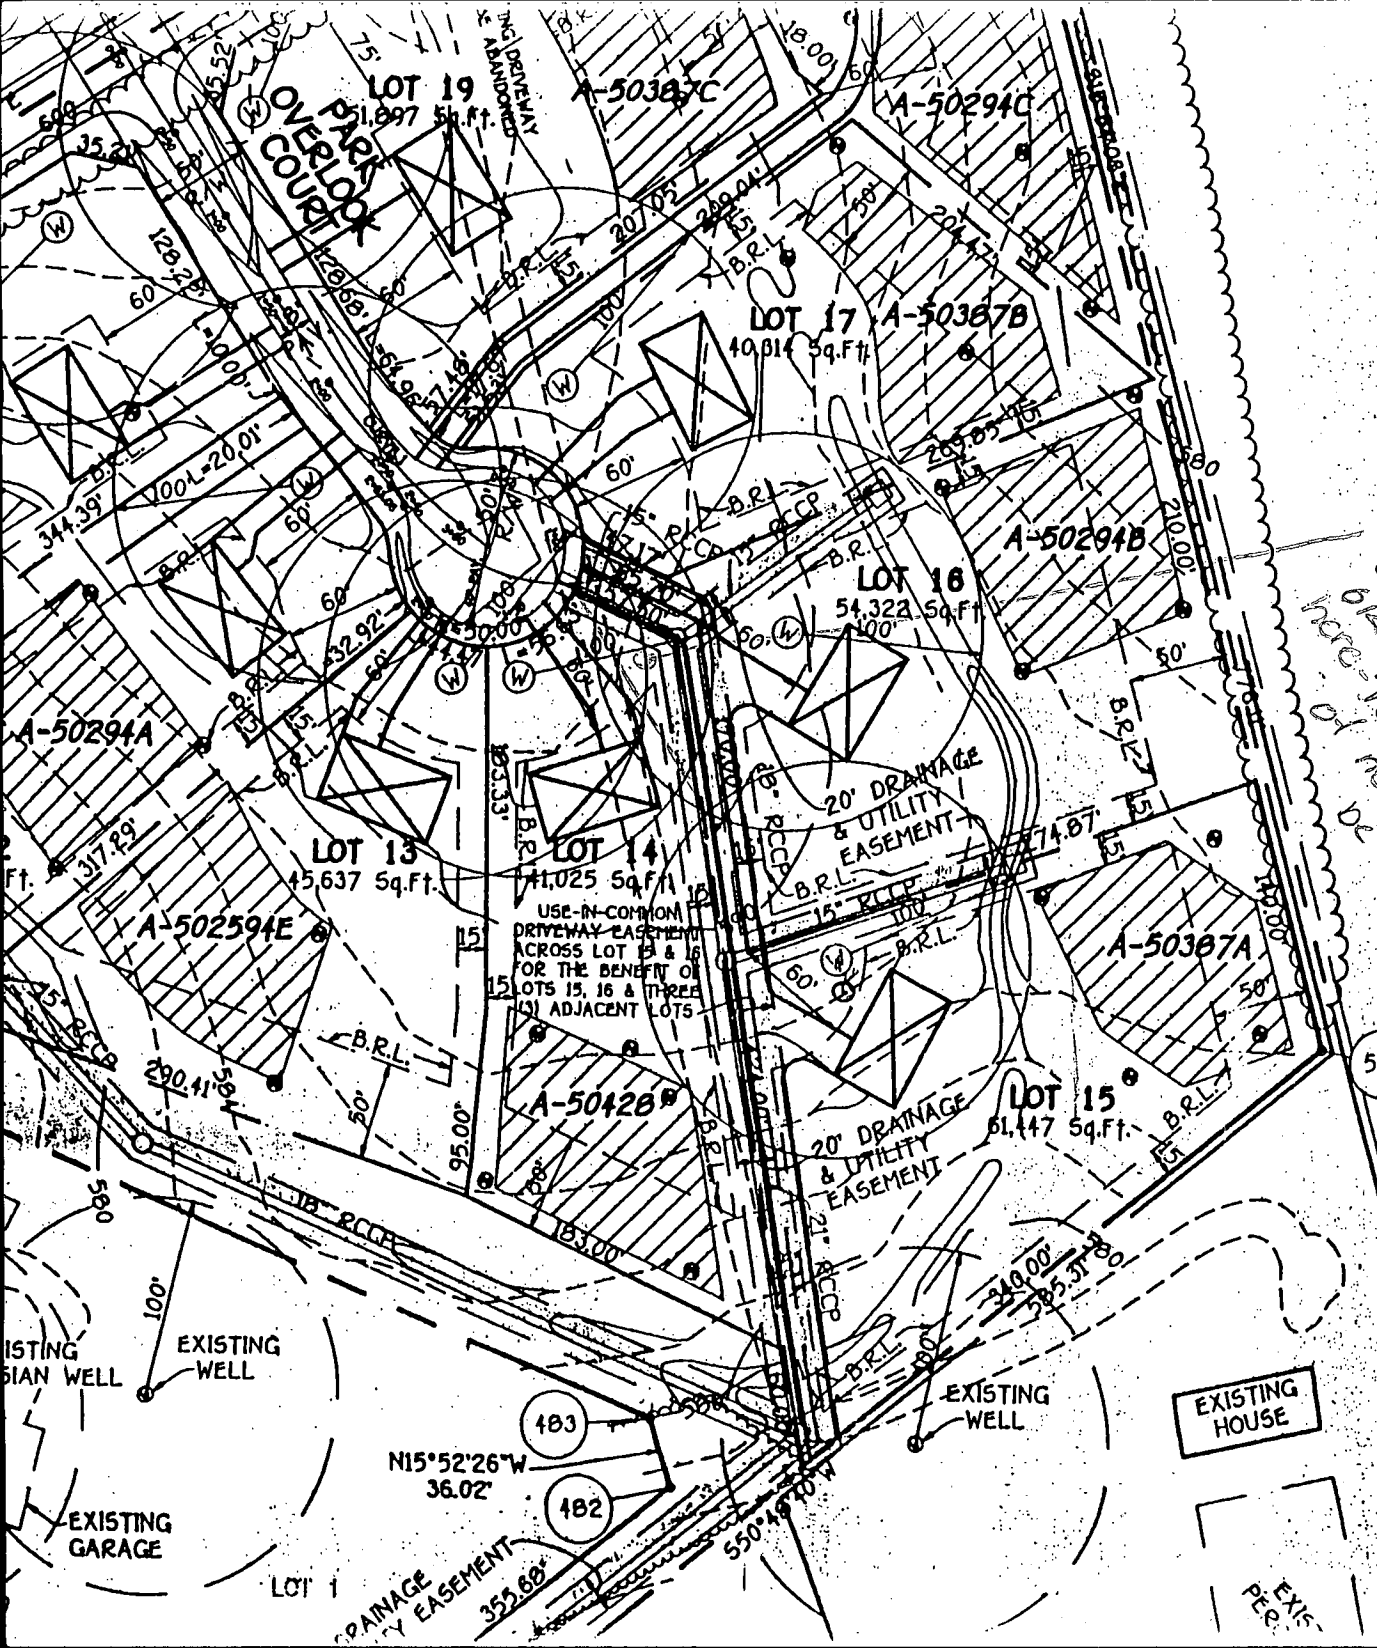

7/18/96
 All site work will be done prior to drilling
 more re-records will be necessary to building permit
 Any Mr. Mullen
 Signed
 Prelim Plan

N15°52'26"W
 36.02'

DRAINAGE EASEMENT
 355.88'

EXISTING HOUSE

EXIST. PER.

595

483

482

LOT 1