

APPLICATION

PERCOLATION TESTING

A 36600

P _____

HOWARD COUNTY HEALTH DEPARTMENT
BUREAU OF ENVIRONMENTAL HEALTH
P.O. BOX 476 ELLICOTT CITY, MARYLAND 21043
TELEPHONE: 461-9933

DISTRICT 3rd

DATE 2-17-86

TO: THE COUNTY HEALTH OFFICER
ELLICOTT CITY, MARYLAND

I, HEREBY, APPLY FOR THE NECESSARY TEST IN ORDER TO CONSTRUCT (OR RECONSTRUCT) A SEWAGE DISPOSAL SYSTEM.

PROPERTY OWNER J. C. Mathenley Blair and Pat Boyd Williamsburg Builders - 997-8800

ADDRESS Shinnick Hill Farm Rt 32 West Friendship PHONE 445-5578
489-4642

PROSPECTIVE BUYER Howard County Land Services Inc

ADDRESS 10176 Bollinger Material Pike PHONE 465-5855

PROPERTY LOCATION: ~~660000~~ KING'S GRANT # NEW 8

SUBDIVISION Mathenley Property LOT NO. 29 PLAT 6/86

ROAD AND DESCRIPTION 3212 Parliament Pl.

TAX MAP 22 PARCEL # 7

SIZE OF LOT 3.3 ac. TYPE BLDG. Single Family
(SINGLE FAMILY DWELLING OR COMMERCIAL)

THE SYSTEM INSTALLED UNDER THIS APPLICATION IS ACCEPTABLE ONLY UNTIL PUBLIC FACILITIES BECOME AVAILABLE. I FULLY UNDERSTAND THE FEE CONNECTED WITH THE FILING OF THIS PERC TEST APPLICATION IS NON-REFUNDABLE UNDER ANY CIRCUMSTANCES. I ALSO AGREE TO COMPLY WITH ALL M.O.S.H.A. REQUIREMENTS IN TESTING THIS LOT.

J. C. Mathenley
(SIGNATURE OF APPLICANT)

APPROVED BY _____ FOR _____ DATE _____

REJECTED BY _____ FOR _____ DATE _____


HOLD PENDING FURTHER TESTS _____ DATE _____

REASONS FOR REJECTION OR HOLDING 7/21/86 - Perc OK / hold for Plat R/H

BLDG. PERMIT SIGNED AND RETURNED 12/6/91
Serial # 40530 -
SFD - 4 Bedrooms

BLDG. PERMIT SIGNED AND RETURNED 7/11/89
Serial # 20965
SFD - 5 Bedrooms

THIS IS NOT A PERMIT

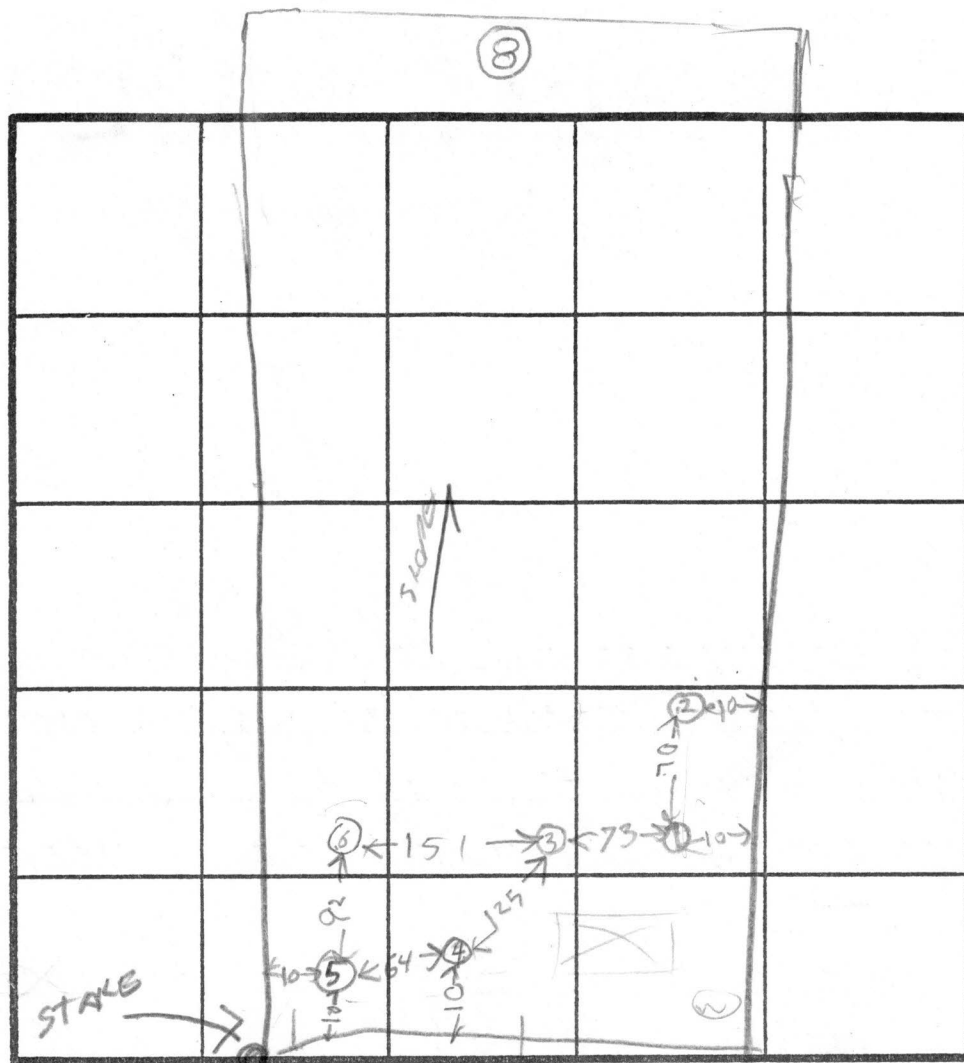

HOLE ELEVATION
 ① ④ HIGH
 ③ ⑤ MEDIUM
 ⑥ ② = LOW

SOIL PROFILE
 0'
 BROWN CLAY
 3'
 BROWN & PINK SAND LOAM 10% SAPROLITE
 11'

② ① ③
 RED BROWN CLAY
 3'
 LIGHT BROWN SAND LOAM & 100% SAPROLITE
 12'

⑥
 ALL LIGHT BROWN SAND LOAM & 200% SAPROLITE
 11'

INDICATE NORTH - NAME ADJOINING ROADWAY AS BASE LINE.

DEAD AHEAD ST

DATE	TEST NO.	DEPTH	PRE-WET		TEST - 1" DROP		TIME
			START	STOP	START	STOP	
7/22/86	1S	3.5	225	227	227	231	4
	1D	7.5	225	227	227	231	4
7/22/86	1V	12	LOOKS OK				
	2S	3	228	231	231	235	4
	2V	12	LOOKS OK				
	3V	12	LOOKS OK				
	4S	3	239	240	240	243	3
	4V	11	LOOKS OK				
	5S	3.5	240	242	242	245	3
	5V	11	LOOKS OK				
	6S	3	248	249	249	256	7
	6V	11	LOOKS OK				

air
 Time
 4 min
 More
 Depth
 3 feet

EH-12-1079

REMARKS _____

TYPE OF SOIL _____

TESTED BY B. HODGES ALSO PRESENT 2 KETTERMAN S