


SITE INSPECTION SHEET

OWNER: _____ PHONE #: _____
ADDRESS: 7288 Sanner Rd CONTRACTOR: _____
SUBDIVISION: _____ LOT: _____ WELL TAG #: _____
PROPOSAL: 20' x 20', 2-car garage COUNTY #: _____

LOCATION DIAGRAM

reb 8/28/2007

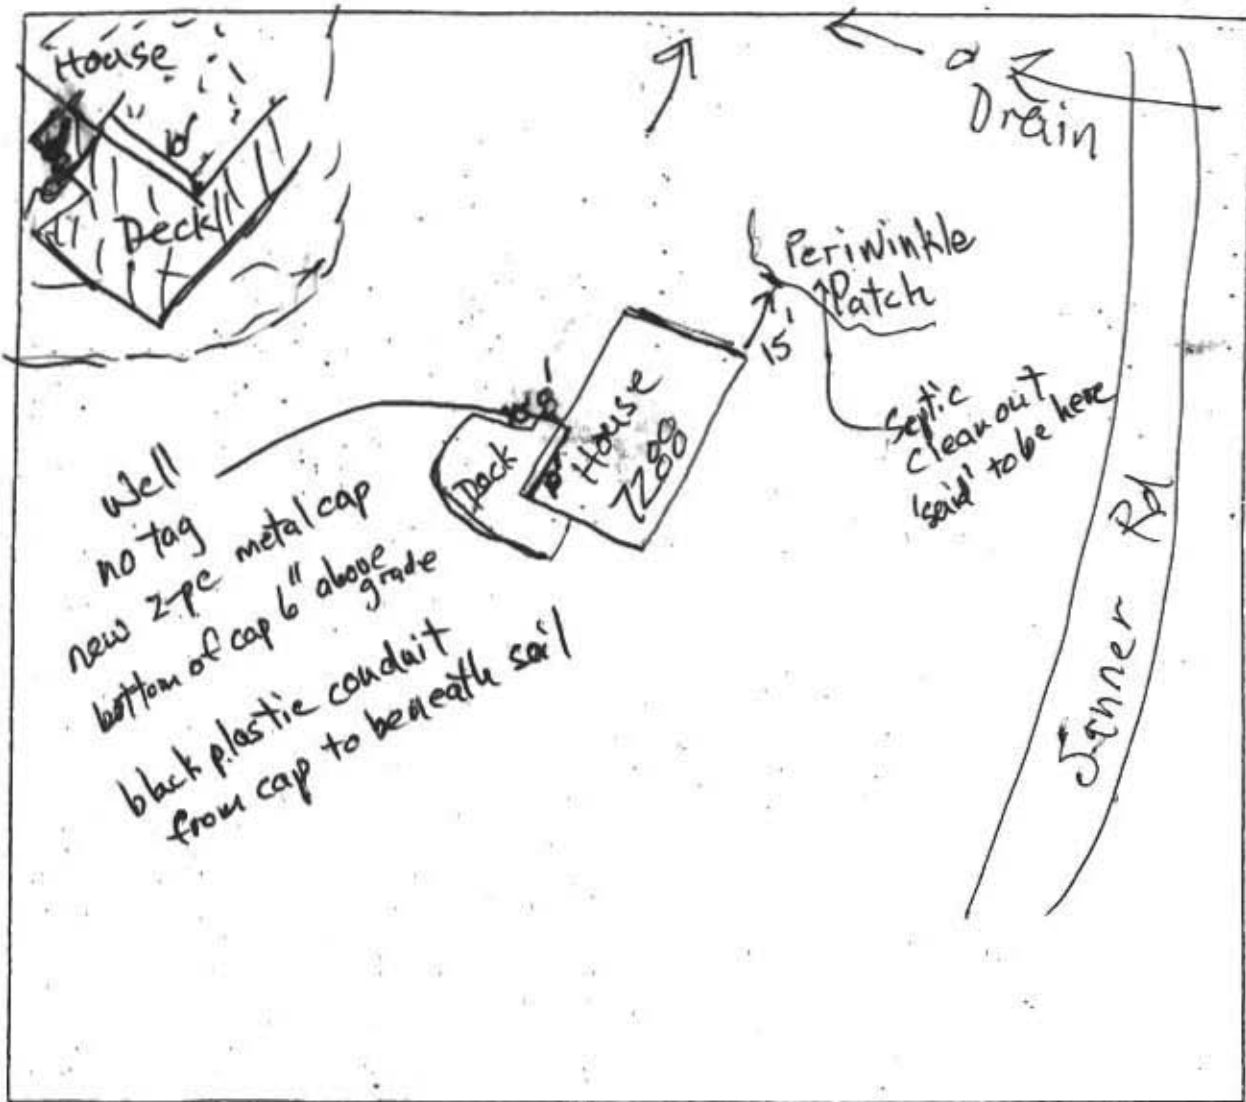

COMMENTS: Site insp. courtesy of Robert Bricker. Any Building Permits would require Perc Certification and (Wet Season) possibly percs. (GAC) Very little area due to well location, streams, & Road cut.