

PUB. SEWER STATUS VERIFIED BY \_\_\_\_\_

ISSUE DATE: \_\_\_\_\_

# PERMIT

P 534062

APPROVAL DATE: 11/3/10

A REPAIR

## Septic Repair ON-SITE SEWAGE DISPOSAL SYSTEM HOWARD COUNTY HEALTH DEPARTMENT BUREAU OF ENVIRONMENTAL HEALTH

Fogles Septic Clean Inc. IS PERMITTED TO INSTALL  ALTER

ADDRESS: 580 Obrecht Road Sykesville, MD 21784 PHONE NUMBER: 410-795-5670

SUBDIVISION: \_\_\_\_\_ LOT NUMBER: \_\_\_\_\_

ADDRESS: 13841 Russell Zepp Drive PROPERTY OWNER: Les Barker

SEPTIC TANK CAPACITY (GALLONS): N/A

PUMP CHAMBER CAPACITY (GALLONS): \_\_\_\_\_

NUMBER OF BEDROOMS: \_\_\_\_\_

SQUARE FEET OF HOUSE: \_\_\_\_\_

LINEAR FEET OF TRENCH REQUIRED: \_\_\_\_\_


TRENCHES:	
LOCATION:	
PURPOSE:	Replace pump in pump chamber and add an alarm to the system. Line between the septic tank and pump chamber needs to be repaired.

PLANS APPROVED: \_\_\_\_\_ DATE: \_\_\_\_\_

- NOTE: PERMIT VOID AFTER 2 YEARS
- NOTE: CONTRACTOR RESPONSIBLE FOR SCHEDULING A PRE-CONSTRUCTION INSPECTION FOR ALL INSTALLATIONS
- NOTE: WATERTIGHT SEPTIC TANKS REQUIRED
- NOTE: ALL PARTS OF SEPTIC SYSTEM SHALL BE 100 FEET FROM ANY WATER WELL
- NOTE: MANHOLE RISERS REQUIRED ON ALL SEPTIC TANKS AND PUMP CHAMBERS

**NEITHER THE HOWARD COUNTY COUNCIL OR THE HEALTH DEPARTMENT IS RESPONSIBLE FOR THE SUCCESSFUL OPERATION OF ANY SYSTEM PERMITTEE RESPONSIBLE FOR OBTAINING FINAL APPROVAL ON THIS PERMIT CALL 410-313-1771 FOR INSPECTION OF SEPTIC SYSTEM**

NOT TO SCALE

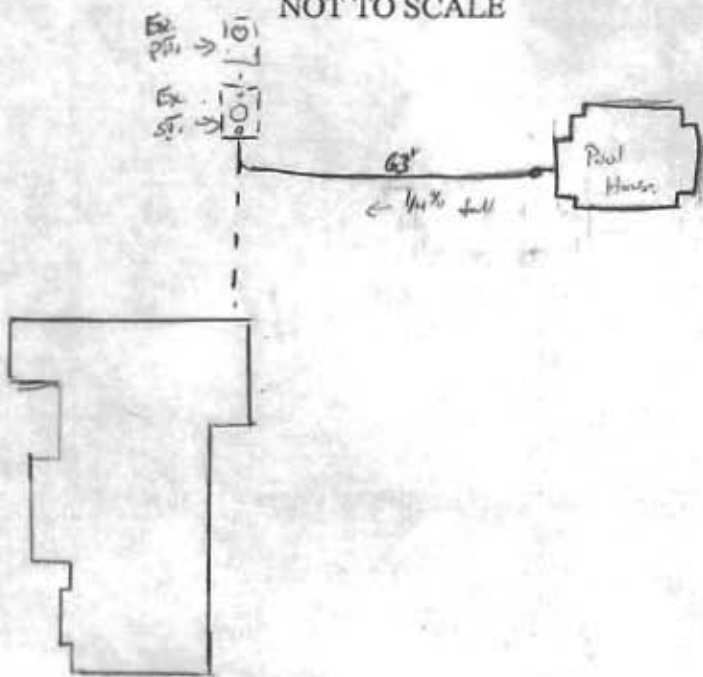

ROAD NAME

**TRENCH/DRAINFIELD DATA**

WIDTH \_\_\_\_\_ INLET \_\_\_\_\_ BOTTOM \_\_\_\_\_

NUMBER OF TRENCHES \_\_\_\_\_

TOTAL LENGTH \_\_\_\_\_

ABSORPTION AREA \_\_\_\_\_

DISTRIBUTION BOX LEVEL \_\_\_\_\_

DISTRIBUTION BOX BAFFLE \_\_\_\_\_

DISTRIBUTION BOX PORT \_\_\_\_\_

**SEPTIC TANK DATA**

SEPTIC TANK I LEVEL \_\_\_\_\_

MANUFACTURER \_\_\_\_\_

CAPACITY \_\_\_\_\_ GAL

SEAM LOC \_\_\_\_\_

TANK LID DEPTH \_\_\_\_\_

BAFFLES \_\_\_\_\_

BAFFLE FILTER \_\_\_\_\_

MANHOLE LOC \_\_\_\_\_

6" PORT LOC \_\_\_\_\_

WATERTIGHT TEST \_\_\_\_\_

SLOTTED \_\_\_\_\_

DATE ON LID \_\_\_\_\_

**PUMP/SEPTIC TANK LEVEL**

MANUFACTURER \_\_\_\_\_

CAPACITY \_\_\_\_\_ GAL

SEAM LOC \_\_\_\_\_

TANK LID DEPTH \_\_\_\_\_

BAFFLES \_\_\_\_\_

BAFFLE FILTER \_\_\_\_\_

MANHOLE LOC \_\_\_\_\_

6" PORT LOC \_\_\_\_\_

WATERTIGHT TEST \_\_\_\_\_

SLOTTED \_\_\_\_\_

DATE ON LID \_\_\_\_\_

PRE-CONSTRUCTION:

\_\_\_\_\_

\_\_\_\_\_

\_\_\_\_\_

\_\_\_\_\_

INSTALLATION: 11/3/10 4" gravity sewer line from pool house installed w/ 1/4" fall per foot as shown. OK to cover.

FINAL INSPECTOR

*J. Wolf*

DATE OF APPROVAL

11/3/10

PUB. SEWER STATUS VERIFIED BY \_\_\_\_\_

ISSUE DATE: \_\_\_\_\_

# PERMIT

P 534062

APPROVAL DATE: \_\_\_\_\_

A REPAIR

## Septic Repair ON-SITE SEWAGE DISPOSAL SYSTEM HOWARD COUNTY HEALTH DEPARTMENT BUREAU OF ENVIRONMENTAL HEALTH

Fogles Septic Clean Inc. IS PERMITTED TO INSTALL  ALTER

ADDRESS: 580 Obrecht Road Sykesville, MD 21784 PHONE NUMBER: 410-795-5670

SUBDIVISION: \_\_\_\_\_ LOT NUMBER: \_\_\_\_\_

ADDRESS: 13841 Russell Zepp Drive PROPERTY OWNER: Les Barker

SEPTIC TANK CAPACITY (GALLONS): N/A

PUMP CHAMBER CAPACITY (GALLONS): \_\_\_\_\_

NUMBER OF BEDROOMS: \_\_\_\_\_

SQUARE FEET OF HOUSE: \_\_\_\_\_

LINEAR FEET OF TRENCH REQUIRED: \_\_\_\_\_

TRENCHES:	
LOCATION:	
PURPOSE:	Replace pump in pump chamber and add an alarm to the system. Line between the septic tank and pump chamber needs to be repaired.

PLANS APPROVED: \_\_\_\_\_ DATE: \_\_\_\_\_

- NOTE: PERMIT VOID AFTER 2 YEARS
- NOTE: CONTRACTOR RESPONSIBLE FOR SCHEDULING A PRE-CONSTRUCTION INSPECTION FOR ALL INSTALLATIONS
- NOTE: WATERTIGHT SEPTIC TANKS REQUIRED
- NOTE: ALL PARTS OF SEPTIC SYSTEM SHALL BE 100 FEET FROM ANY WATER WELL
- NOTE: MANHOLE RISERS REQUIRED ON ALL SEPTIC TANKS AND PUMP CHAMBERS

**NEITHER THE HOWARD COUNTY COUNCIL OR THE HEALTH DEPARTMENT IS RESPONSIBLE FOR THE SUCCESSFUL OPERATION OF ANY SYSTEM PERMITTEE RESPONSIBLE FOR OBTAINING FINAL APPROVAL ON THIS PERMIT CALL 410-313-1771 FOR INSPECTION OF SEPTIC SYSTEM**

NOT TO SCALE

**TRENCH/DRAINFIELD DATA**

WIDTH \_\_\_\_\_ INLET \_\_\_\_\_ BOTTOM \_\_\_\_\_  
NUMBER OF TRENCHES \_\_\_\_\_  
TOTAL LENGTH \_\_\_\_\_  
ABSORPTION AREA \_\_\_\_\_  
DISTRIBUTION BOX LEVEL \_\_\_\_\_  
DISTRIBUTION BOX BAFFLE \_\_\_\_\_  
DISTRIBUTION BOX PORT \_\_\_\_\_

**SEPTIC TANK DATA**

SEPTIC TANK I LEVEL \_\_\_\_\_  
MANUFACTURER \_\_\_\_\_  
CAPACITY \_\_\_\_\_ GAL  
SEAM LOC \_\_\_\_\_  
TANK LID DEPTH \_\_\_\_\_  
BAFFLES \_\_\_\_\_  
BAFFLE FILTER \_\_\_\_\_  
MANHOLE LOC \_\_\_\_\_  
6" PORT LOC \_\_\_\_\_  
WATERTIGHT TEST \_\_\_\_\_  
SLOTTED \_\_\_\_\_  
DATE ON LID \_\_\_\_\_

**PUMP/SEPTIC TANK LEVEL**

MANUFACTURER \_\_\_\_\_  
CAPACITY \_\_\_\_\_ GAL  
SEAM LOC \_\_\_\_\_  
TANK LID DEPTH \_\_\_\_\_  
BAFFLES \_\_\_\_\_  
BAFFLE FILTER \_\_\_\_\_  
MANHOLE LOC \_\_\_\_\_  
6" PORT LOC \_\_\_\_\_  
WATERTIGHT TEST \_\_\_\_\_  
SLOTTED \_\_\_\_\_  
DATE ON LID \_\_\_\_\_

*ROAD NAME*

PRE-CONSTRUCTION:

---

---

INSTALLATION:

---

---

FINAL INSPECTOR \_\_\_\_\_, DATE OF APPROVAL \_\_\_\_\_

Maryland Department of Assessments and Taxation Real Property Data Search (svw3.1) HOWARD COUNTY	<a href="#">Go Back</a> <a href="#">View Map</a> <a href="#">New Search</a>
--	---

**Account Identifier:** District - 05 Account Number - 414687

Owner Information
-------------------

<b>Owner Name:</b>	BARKER LES TRUSTEE APPEL BARKER DEBORAH A TRUSTEE	<b>Use:</b>	RESIDENTIAL
<b>Mailing Address:</b>	13841 RUSSELL ZEPP DR CLARKSVILLE MD 21029-1443	<b>Principal Residence:</b>	YES
		<b>Deed Reference:</b>	1) /12684/ 42 2)

Location & Structure Information
----------------------------------

<b>Premises Address</b>	<b>Legal Description</b>
13841 E RUSSELL ZEPP DR CLARKSVILLE 21029	LOT 8 3.6254 A 13841 RUSSELL ZEPP DR BRIERLY

Map	Grid	Parcel	Sub District	Subdivision	Section	Block	Lot	Assessment Area	Plat No:	Plat Ref:	
34	3	7					8	2			10003

<b>Special Tax Areas</b>	<b>Town</b>	NO A/V, RURAL FIRE TAX
	<b>Ad Valorem Tax Class</b>	

<b>Primary Structure Built</b>	<b>Enclosed Area</b>	<b>Property Land Area</b>	<b>County Use</b>
1997	3,292 SF	3.62 AC	

<b>Stories</b>	<b>Basement</b>	<b>Type</b>	<b>Exterior</b>
2	YES	STANDARD UNIT SIDING	

Value Information
-------------------

	<u>Base Value</u>	<u>Value</u>	<u>Phase-in Assessments</u>	
			As Of	As Of
			01/01/2008	07/01/2010
				07/01/2011
<b>Land</b>	412,150	412,150		
<b>Improvements:</b>	444,270	444,270		
<b>Total:</b>	856,420	856,420	856,420	NOT AVAIL
<b>Preferential Land:</b>	0	0	0	NOT AVAIL

Transfer Information
----------------------

<b>Seller:</b>	BARKER LESLIE M	<b>Date:</b>	09/13/2010	<b>Price:</b>	\$0
<b>Type:</b>	NOT ARMS-LENGTH	<b>Deed1:</b>	/12684/ 42	<b>Deed2:</b>	
<b>Seller:</b>	CLARKSVILLE ASSOCIATES	<b>Date:</b>	05/14/1996	<b>Price:</b>	\$132,000
<b>Type:</b>	UNIMPROVED ARMS-LENGTH	<b>Deed1:</b>	/ 3726/ 665	<b>Deed2:</b>	
<b>Seller:</b>		<b>Date:</b>		<b>Price:</b>	
<b>Type:</b>		<b>Deed1:</b>		<b>Deed2:</b>	

Exemption Information
-----------------------

<b>Partial Exempt Assessments</b>	<b>Class</b>	07/01/2010	07/01/2011
<b>County</b>	000	0	0
<b>State</b>	000	0	0
<b>Municipal</b>	000	0	0

<b>Tax Exempt:</b> NO	<b>Special Tax Recapture:</b>
<b>Exempt Class:</b>	* NONE *

# Howard County Health Department

Bureau of Environmental Health, Ellicott City, Maryland 410-313-2640

**SEWAGE DISPOSAL PERMIT NO. A-** \_\_\_\_\_ **P-** \_\_\_\_\_

PERMITTEE \_\_\_\_\_

LOCATION

13841 Russell Zapp Drive

Do Not Cover Work Until Health Department Approval Appears On This Card

**POST THIS CARD WHERE IT CAN BE SEEN FROM ROAD**

STOP ALL CONSTRUCTION ON SEWAGE  
DISPOSAL SYSTEM AND CONTACT HEALTH  
DEPARTMENT BEFORE CONTINUING

WORK IS SATISFACTORY,  
CONTINUE

Inspector \_\_\_\_\_

Date \_\_\_\_\_

Inspector \_\_\_\_\_

Date \_\_\_\_\_

FINAL INSPECTION MADE,  
COVER ALL WORK

Inspector \_\_\_\_\_

Date \_\_\_\_\_



# HOWARD COUNTY HEALTH DEPARTMENT

34062

DATE  
10 / 14 / 10

25

Received From Fogles: Septa Clean, Inc. PHONE # 410-715-3670

For Repair 13841 Russell Zapp Dr

CASH

CHECK

NO.

33724

Fifty five Dollars <sup>00/100</sup> Dollars

\$

55 | 00

Received By [Signature]