



HOWARD COUNTY HEALTH DEPARTMENT

57404

A5

10/8/15 DATE

Received From

Eugene + Lorraine Mason

PHONE #

For

Peric App + Repair ~ 13504 Argo Drive

LOT # 7, Linden Chapel

Hills

CASH

CHECK

NO.

7932

Three hundred thirty

30/100


Dollars

\$

330 | 00

Received By

M Curry

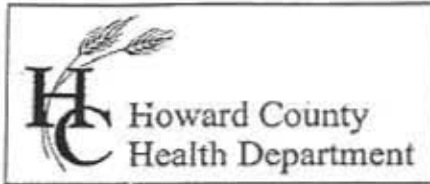

Bureau of Environmental Health
 7178 Gateway Drive Columbia, MD 21046
 (410) 313-2640 Fax (410) 313-2648
 TDD (410) 313-2323 Toll Free 1-866-313-6300
 website: www.hchealth.org

Maura J. Rossinan, M.D., Acting Health Officer

APPLICATION

FOR PERCOLATION TESTING AND SITE EVALUATION

557404

PROPERTY LOCATION

SUBDIVISION/PROPERTY NAME Lorraine Mason (LINDEN CHAPEL HILLS) LOT # 9

PROPERTY ADDRESS 13504 Argo Dr. DAYTON 21036
STREET TOWN ZIP

TAX ACCOUNT # _____ TAX MAP _____ GRID _____ PARCEL _____ ZONING DESIGNATION _____

PROPERTY OWNER(S) Lorraine Mason

DAYTIME PHONE _____ CELL _____ EMAIL mfamily86@verizon.net

MAILING ADDRESS Same _____
STREET CITY, STATE ZIP

APPLICANT Eck Zepp RELATIONSHIP TO OWNER: plumber/contractor

DAYTIME PHONE _____ CELL 443-864- EMAIL eddy@zeppplumbing.com

MAILING ADDRESS 5820 CLARKSVILLE PIKE³¹⁰¹ CLARKSVILLE MD 21039
STREET CITY, STATE ZIP

I HEREBY APPLY FOR THE NECESSARY TESTING/EVALUATION PRIOR TO ISSUANCE OF SEWAGE DISPOSAL SYSTEM PERMIT(S):

- BUILDING:**
- RESIDENTIAL WITH 4 EXISTING OR PROPOSED BEDROOMS IN THE COMPLETED STRUCTURE
 - COMMERCIAL (PROVIDE DETAIL OF TYPE OF USE AND NUMBERS OF EMPLOYEES/CUSTOMERS ON ACCOMPANYING PLAN)
- PROPERTY:**
- SUBDIVISION: NUMBER OF LOTS INCLUDING RESIDUE: _____
 - CONSTRUCT NEW OSDS ON UNDEVELOPED LOT
 - REPAIR OR REPLACE FAILING OSDS
 - UPGRADE EXISTING OSDS
- IS THE PROPERTY WITHIN 2500 FEET OF ANY RESERVOIR?
- YES
 - NO

AS APPLICANT, I UNDERSTAND THE FOLLOWING:

- THIS APPLICATION IS VALID FOR TWO(2) YEARS FROM DATE OF FEE PAYMENT AND APPROVAL IS BASED UPON HEALTH OFFICER SIGNATURE OF A PERC CERTIFICATION PLAN PRIOR TO EXPIRATION OF THIS PERMIT.
- THE APPLICATION FEE IS NON-REFUNDABLE
- THIS APPLICATION MUST BE ACCOMPANIED BY ALL APPLICABLE FEES AND A SUITABLE SITE PLAN IN ORDER TO BE PROCESSED
- THIS IS A PUBLIC DOCUMENT

I declare and affirm that to the best of my knowledge, the information contained herein is correct. I declare that I am the owner of the property or duly authorized to make this application on behalf of the owner. I agree to comply with all applicable state and county regulations.

By signature of this application, I hereby grant Howard County Health Department officials the right to enter onto the property for the purpose of inspecting the property as directly related to the requested permit/service.

Edgar W. Zepp, IV 10/8/15
 SIGNATURE OF APPLICANT DATE

HO-94-0633

• ?

AP _____


(A)

Red Br
Moderately
Dense Sa
Cl Loam

3.5'-4'

Moderately
Dense
Med Fine
Beige Sa
~10%
Rock
Dry

14.5'

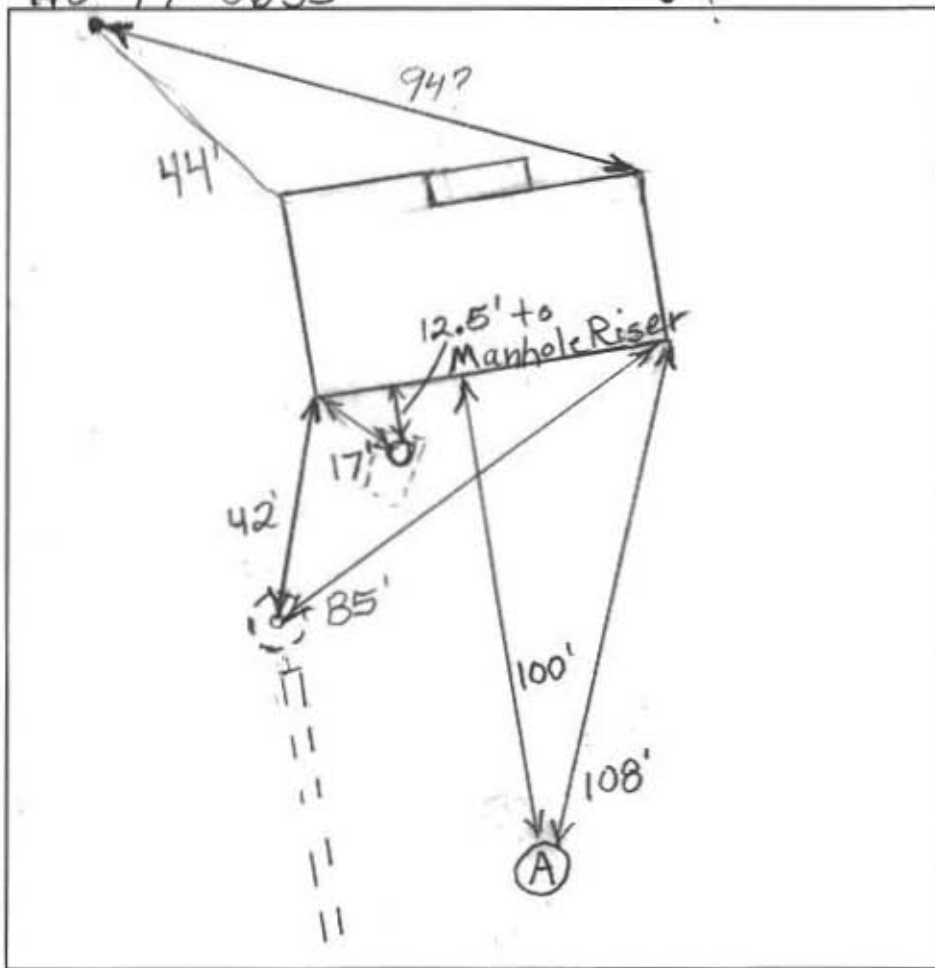

DATE	TEST #	DEPTH	START	BREAK 1" DROP	STOP 2" DROP	TIME OF 2ND INCH	P/F/H
10/14/2015	A	55'/14.5'	10:59:30	11:02	11:05:30	3 1/2	P

REMARKS Water Poured in Bottom of Hole - Rate a Little Fast
 SANITARIAN B. Baker BACKHOE Zepp Plumbing OTHERS Homeowners
 TEST HOLES USED IN SDA A AVG. PERC TIME _____ SQ. FT/BR _____
 TRENCH WIDTH _____ INLET DEPTH _____ MAX. BOT DEPTH _____ EFFECTIVE S/W _____



Bureau of Environmental Health

8930 Stanford Boulevard, Columbia, MD 21045
Main: 410-313-2640 | Fax: 410-313-2648
TDD 410-313-2323 | Toll Free 1-866-313-6300
www.hchealth.org

Facebook: www.facebook.com/hchohealth
Twitter: HowardCoHealthDep

Dr. Maura J. Rossman, M.D., Health Officer

INFORMATION FORM - SEPTIC SYSTEM REPAIR/UPGRADE

Reason for Request:

- Failing System
System relocation for proposed addition
System upgrade for proposed addition
Inadequate treatment zone
Collapsed septic tank
Collapsed drywell

Has the septic tank been pumped within the last month?

- Yes Date pumped: 10/5/15 + 10/8/15
No

Was a visual inspection of the septic tank and/or drain fields conducted?

- Yes Explain observations: septic tank exit baffle clogged and CI pipe clogged, drywell full, trench piped too high from drywell.
No

Was a visual inspection of the sewage line conducted?

- Yes Blockage leading to the tank
Yes Explain: CI clogged to drywell
No

Blockage leading to the field

- Yes Explain: pipe was too high to receive water from drywell thus clogging septic tank.
No

Additional Comments: 40' trench gravel is still clean.

Existing system design

- Drywell
Trench
Mound
Unknown
Other: 1250 gal septic tank

Is discharge surfacing on the ground?

- Yes
No

*For REPAIRS, are the owners proposing, or do they plan to add in the future, any additions or modifications to the property, i.e. pools, living space additions, garages, etc? This information must be disclosed at the time of this application. The Health Department will not be able to accommodate requests in the field for property modifications unrelated to the repair request. Such requests may require an additional fee, testing, and submittal of a Percolation Certification Plan, if the property does not meet current Code and Regulation.

Septic Contractor: Zopp Plumbing Contractor's Phone: C 443-864-3101
Contractor's Address: 5820 CLARKSVILLE AVE 21029

Property Address: 13504 Argo Dr. County file:
Subdivision: Lot: 9 Year Built: 1976
Owner's Name: LORRAINE MASON Owner's Phone:

Name of previous owners: Miller Existing bedrooms: 4
Proposed bedrooms: 0

Has this request been previously discussed with a Sanitarian? (Name): Robert Bricker
Public Sewer available/nearby: NO

*A Sanitarian will be in contact within three business days, depending upon the urgency of the situation, to coordinate the scheduling/review of the repair or upgrade.

Prior to scheduling inspections, scaled plans should be submitted to clarify the nature of the addition.

Print out a copy of Real Property Data via Dept. of Taxation website Indexed file found

If public sewer may be nearby, verify whether sewer is technically "available" through the Bureau of Engineering.

If sewer is available and the property is within the Metropolitan District, connection to sewer is required. If the owner believes reason for exemption exists, the owner should justify the request in writing.

If soil/site conditions are limited and sewer and/or Metro District status is not conducive to connection, the Sanitarian may recommend pursuit of Emergency Sewer Extension or Emergency Metro District Inclusion. The Owner should contact the Bureau of Utilities for details.

No permit is to be issued nor inspection to be scheduled without prior fee collection at the office unless an emergency situation exists. The contractor is to notify office of the emergency situation as soon as possible.

* Repland fee from tank to appeal