



# HOWARD COUNTY HEALTH DEPARTMENT

63043

DATE 7/12/10

p5

Received From

Jonathan River

PHONE #

443-226-5745

For

SHC 3226 Huntersworth Way

CASH

CHECK

NO.

00

one hundred sixty four


Dollars

\$

105.00

Received By

J. L. [Signature]

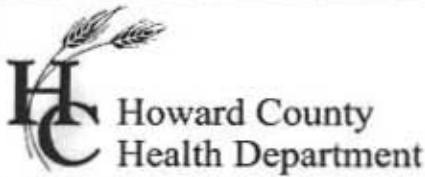

**Bureau of Environmental Health**  
 8930 Stanford Boulevard, Columbia, MD 21045  
 Main: 410-313-2640 | Fax: 410-313-2648  
 TDD 410-313-2323 | Toll Free 1-866-313-6300  
[www.hchealth.org](http://www.hchealth.org)  
 Facebook: [www.facebook.com/hocohealth](http://www.facebook.com/hocohealth)

Maura J. Rossman, M.D., Health Officer

RECEIPT DATE: 7/2/18      **ONSITE SEWAGE DISPOSAL SYSTEM**      P 563043

INSTALLATION APPROVAL DATE: 7/17/2018 RJE      **PERMIT**      A \_\_\_\_\_

**SEWER HOUSE CONNECTION**

PROPERTY ADDRESS: <sup>3226</sup>~~3326~~ Huntersworth Way

SUBDIVISION: Woods @ Wellington      LOT: 11      TAX ID: 05-368243

CONTRACTOR: ~~Jonathan Rivera~~ Timothy Chrobak      EMAIL: ~~jrivera@jonathanrivera.com~~

CONTRACTOR ADDRESS: ~~3326 Huntersworth Way~~ TC Plumbing      PHONE: 301 343 8924

PROPERTY OWNER: Jonathan Rivera      EMAIL: jrivera@jonathanrivera.com

OWNER ADDRESS: 3226 Huntersworth Way, Glenwood, MD 21798      PHONE: 443-226-5745

↓  
15727 Millbrook Ln, Laurel, MD 20707

NUMBER OF BEDROOMS: N/A      CONNECTED TO PUBLIC WATER:  YES  NO


LOCATION:	INSTALL 4" SEWER LINE PER APPROVED SITE PLAN
NOTES:	Call for inspection prior to covering. 410 313 1771

ISSUED BY: Robert Freemon      ISSUE DATE: 7/2/18      EXPIRATION DATE: 7/2/19

- NOTE: HOWARD COUNTY BUREAU OF UTILITIES APPROVAL OF GRINDER PUMP INSTALLATION IS REQUIRED PRIOR TO SEPTIC PERMIT APPROVAL
- NOTE: CONTRACTOR MUST SCHEDULE AN INSPECTION AND GAIN APPROVAL OF ALL COMPONENTS PRIOR TO COVERING
- NOTE: AN ELECTRICAL PERMIT IS REQUIRED FOR INSTALLATION OF ANY ELECTRICAL COMPONENTS OF THE SYSTEM

**NEITHER THE HOWARD COUNTY COUNCIL NOR THE HEALTH DEPARTMENT IS RESPONSIBLE FOR THE SUCCESSFUL OPERATION OF ANY SYSTEM. PERMITTEE RESPONSIBLE FOR OBTAINING FINAL APPROVAL ON THIS PERMIT. CALL 410-313-1771 FOR INSPECTION OF SEPTIC SYSTEM.**

NOT TO SCALE

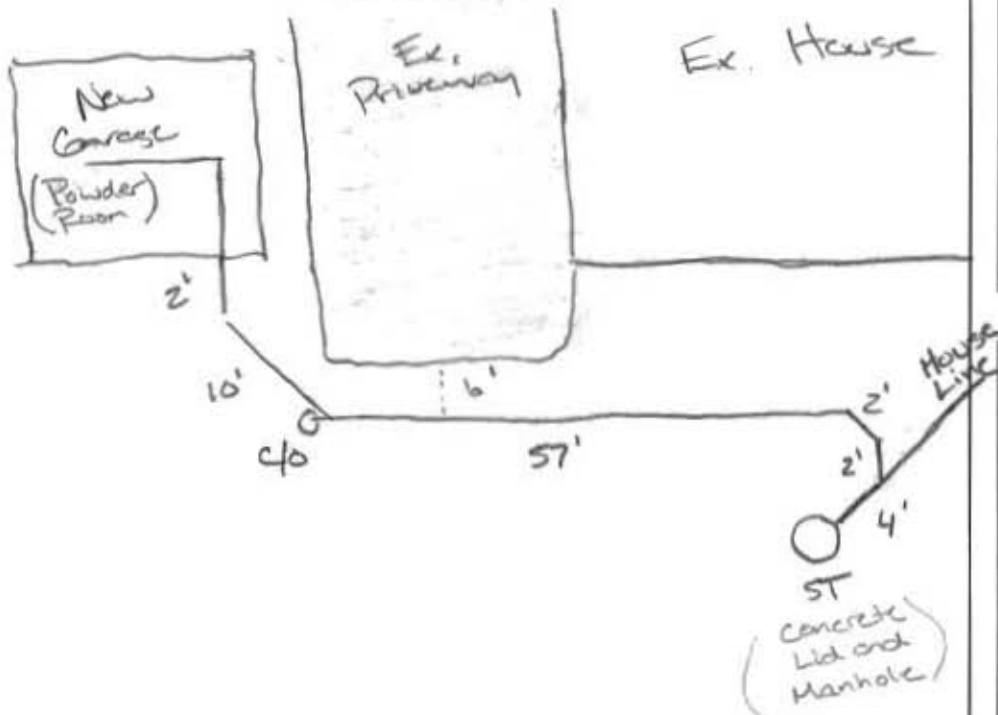

**TRENCH/DRAINFIELD DATA**

WIDTH \_\_\_\_\_ INLET \_\_\_\_\_ BOTTOM \_\_\_\_\_

NUMBER OF TRENCHES \_\_\_\_\_

TOTAL LENGTH \_\_\_\_\_

ABSORPTION AREA \_\_\_\_\_

DISTRIBUTION BOX LEVEL \_\_\_\_\_

DISTRIBUTION BOX BAFFLE \_\_\_\_\_

DISTRIBUTION BOX PORT \_\_\_\_\_

**SEPTIC TANK DATA**

**SEPTIC TANK I LEVEL** \_\_\_\_\_

MANUFACTURER \_\_\_\_\_

CAPACITY \_\_\_\_\_ GAL

SEAM LOC \_\_\_\_\_

TANK LID DEPTH \_\_\_\_\_

BAFFLES \_\_\_\_\_

BAFFLE FILTER \_\_\_\_\_

MANHOLE LOC \_\_\_\_\_

6" PORT LOC \_\_\_\_\_

WATERTIGHT TEST \_\_\_\_\_

SLOTTED \_\_\_\_\_

DATE ON LID \_\_\_\_\_

**PUMP/SEPTIC TANK LEVEL** \_\_\_\_\_

MANUFACTURER \_\_\_\_\_

CAPACITY \_\_\_\_\_ GAL

SEAM LOC \_\_\_\_\_

TANK LID DEPTH \_\_\_\_\_

BAFFLES \_\_\_\_\_

BAFFLE FILTER \_\_\_\_\_

MANHOLE LOC \_\_\_\_\_

6" PORT LOC \_\_\_\_\_

WATERTIGHT TEST \_\_\_\_\_

SLOTTED \_\_\_\_\_

DATE ON LID \_\_\_\_\_

ROAD NAME

**PRE-CONSTRUCTION:**

\_\_\_\_\_

\_\_\_\_\_


\_\_\_\_\_

\_\_\_\_\_

**INSTALLATION:** Visited the site to inspect installation of a STK from a powder room in a newly built detached garage. Jonathan Rivera (Homeowner) was home and was aware I was performing the inspection. Septic line was exposed for me to take measurements. Cleanout was installed and 45° elbows were used unlike what the site plan shows (90°). Called Timothy with TC Plumbing and asked if he could confirm there was fall to the tank. He informed me fall was verified. Gave the ok to cover the work. RIF 7/17/2018

FINAL INSPECTOR Robert Freeman DATE OF APPROVAL 7/17/2018

3226 HUNTERSWORTH WAY

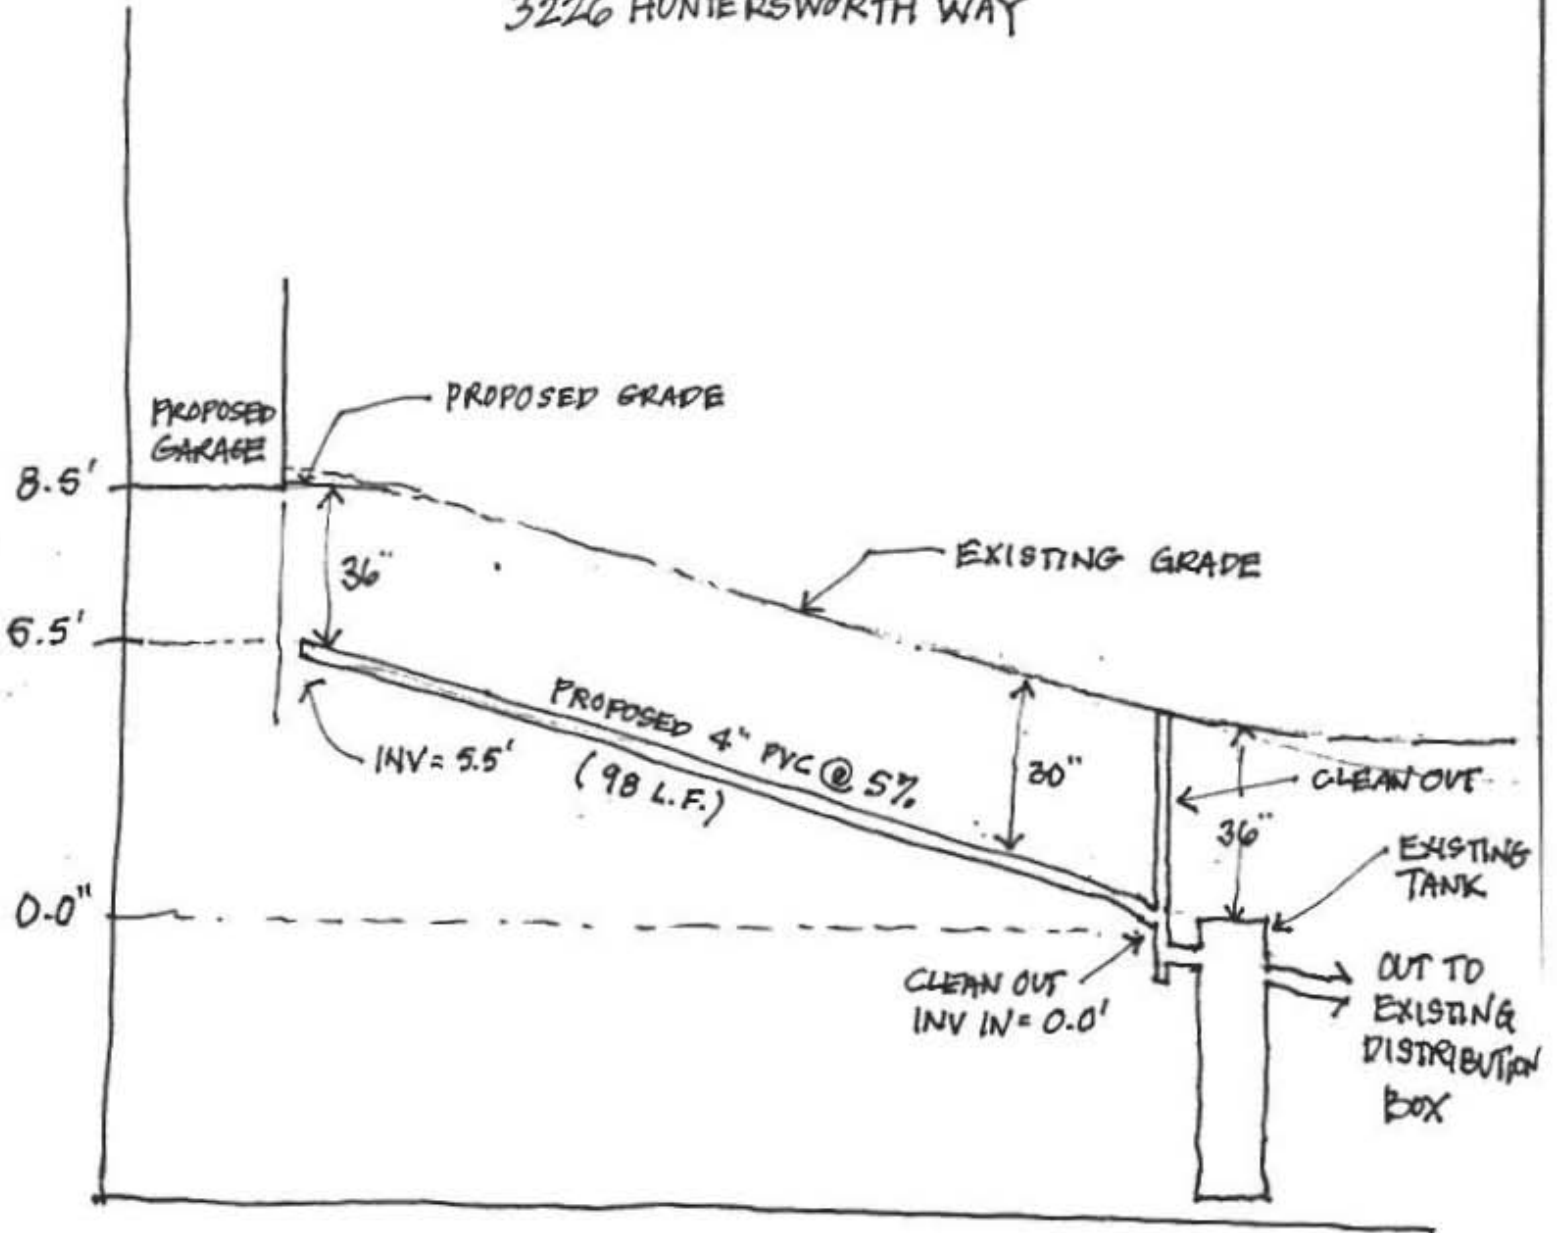

SEPTIC PROFILE VIEW

-NOT TO SCALE-

6/29/18 FIELD MEASURED