

Menu Save Reset Cancel Help

Record Detail \* (This section is required.)

Permit Type	Permit Number	Opened Date
Building/Residential/Misc/Porch	B18002185	06/25/2018
Description of Work		
SFD/ CONSTRUCT 16' X 18' IRREGULAR SHAPED OPEN PORCH WITH STEPS		

check spelling

Address \* (This section is required.)

Search Reset Clear Get Parcel & Owner

Street #	Street Name	Street Type	
13511	MITCHELLS	WAY	
Unit Type	Unit #	X Coordinate	Y Coordinate
--Select--		-76.9877	39.30423
City	State	Zip Code	Primary
WEST FRIENDSHIP	MD	21794	Yes

Parcel \* (This section is required.)

Search Reset Clear Get Address & Owner

GIS ID *	Parcel	Parcel Area	Land Value	Improved Value	Exemption Value	Plan Area
923982	4	1.1	201800	769300	567500	RURAL
Legal Description						
IMPSLOT 20 1.106 A [ 13511 MITCHELLS WAY ] CLOVERFIELD						

check spelling

Block	Lot	Census Tract	Council Dist	Supervisor Dist	Map #	DAP Zone	Primary
	20	603000	5				Yes
Plan Area	State Tax Id	Subdivision Name					
	1403348970	Cloverfield					
Section	Area	Tax Map					
		15					
Grid	Zoning District	ADC Map					
15-8	RC-DEQ	4813-B2					
SDP No.	Final Plan No.	WP File No.					
	E-06-110						
Record Plat No.	WS Contract No.	FDP No.					
18853-1885							
Owner Occupied	Year Built	Historic District					
<input type="radio"/> Yes <input type="radio"/> No	2010	<input type="radio"/> Yes <input checked="" type="radio"/> No					
Historic District Registry No.	Stat Area	Flood Plain					
	3-04	<input type="radio"/> Yes <input checked="" type="radio"/> No					
Building No							

Owner \* (This section is required.)

Search Reset Clear

Name *
PROPHET JEFFREY W
Address Line 1
13511 MITCHELLS WAY
Address Line 2

Address Line 3

Mail City  Mail State  Mail Zip Code

Phone  Primary

E-mail

Cell Number  Fax Number

Professionals (This section is not required)

Search Reset Clear

License # \*  Business Name

License Type \*  First Name  Middle Name  Last Name

Primary  Address Line 1

Address Line 2

City  State  ZIP Code

Phone 1  Phone 2  Fax

E-mail

Applicant (This section is not required)

Search As Owner As Lic. Prof As Contact

Type \*  First Name  Mi  Last Name

Relationship  Full Name

Primary  Organization Name

Street Address

Address Line 2

City  State  Zip Code

Phone  Cell  Fax

E-mail \*

Addl Info

Est Construction Cost  \*Housing Units \*  Number of Buildings  \*Public Owned

Construction Type

PORCH INFORMATION

PORCH INFORMATION

Capital Project-No Fee \*  Yes  No Capital Project Number  Fee Exempt \*  Yes  No Roadside Tree Project Permit \*  Roadside Tree Project Permit #

Existing Use \*  Type of Porch \*  Type of Porch Foundation \*  Total Square Footage \*  SQFT

Water Supply  Sewage Disposal  Expiration Date


PAYMENT INFORMATION

Check 1	Payee 1	Check 2	Payee 2	SAP Doc No	SAP Entered
N/A	ONLINE PAYMENT				

Submit Cancel

**GENERAL NOTES:**

- 1) THIS LOCATION DRAWING IS PREPARED FOR THE BENEFIT OF THE CLIENT SIGNING THE HOUSE LOCATION SURVEY APPROVAL FORM INsofar AS IT IS REQUIRED BY A LENDER OR TITLE INSURANCE COMPANY OR ITS AGENTS IN CONNECTION WITH THE CONTEMPLATED TRANSFER, FINANCING OR REFINANCING OF THE PROPERTY SHOWN HEREON. UNLESS INDICATED AS BEING A BOUNDARY SURVEY, THIS LOCATION DRAWING IS NOT INTENDED FOR USE IN THE ESTABLISHMENT OF PROPERTY LINES AND IS NOT TO BE RELIED UPON FOR THE ESTABLISHMENT OR LOCATIONS OF FENCES, GARAGES, BUILDINGS OR OTHER EXISTING OR FUTURE IMPROVEMENTS. AS A RESULT, THIS LOCATION DRAWING DOES NOT PROVIDE FOR ACCURATE IDENTIFICATION OF PROPERTY LINES, BUT SUCH IDENTIFICATION MAY NOT BE REQUIRED FOR THE TRANSFER OF TITLE OR SECURING FINANCING FOR RE-FINANCING.
- 2) SUBJECT PROPERTY IS SHOWN IN ZONE C ON THE NATIONAL FLOOD INSURANCE PROGRAM FLOOD INSURANCE RATE MAP OF HOWARD COUNTY, MARYLAND, COMMUNITY PANEL No. 2400440015 & EFFECTIVE DEC. 4, 1986.
- 3) THE OFFSETS FROM BUILDING LINE TO PROPERTY LINE AS SHOWN ON THE PLAT HEREON ARE TO AN ACCURACY OF PLUS OR MINUS 1.0' (+)
- 4) NO TITLE REPORT FURNISHED. SUBJECT TO ALL EASEMENTS, RIGHTS OF WAY AND CONDITIONS OF RECORD.
- 5) THE EXISTING WELL(S) SHOWN ON THIS PLAN (IDENTIFIED WITH THE ATTACHED WELL TAG NUMBER HO-95-0380) HAS BEEN FIELD LOCATED BY FISHER, COLLINS AND CARTER, INC. PROFESSIONAL LAND SURVEYORS AND IS ACCURATELY SHOWN.

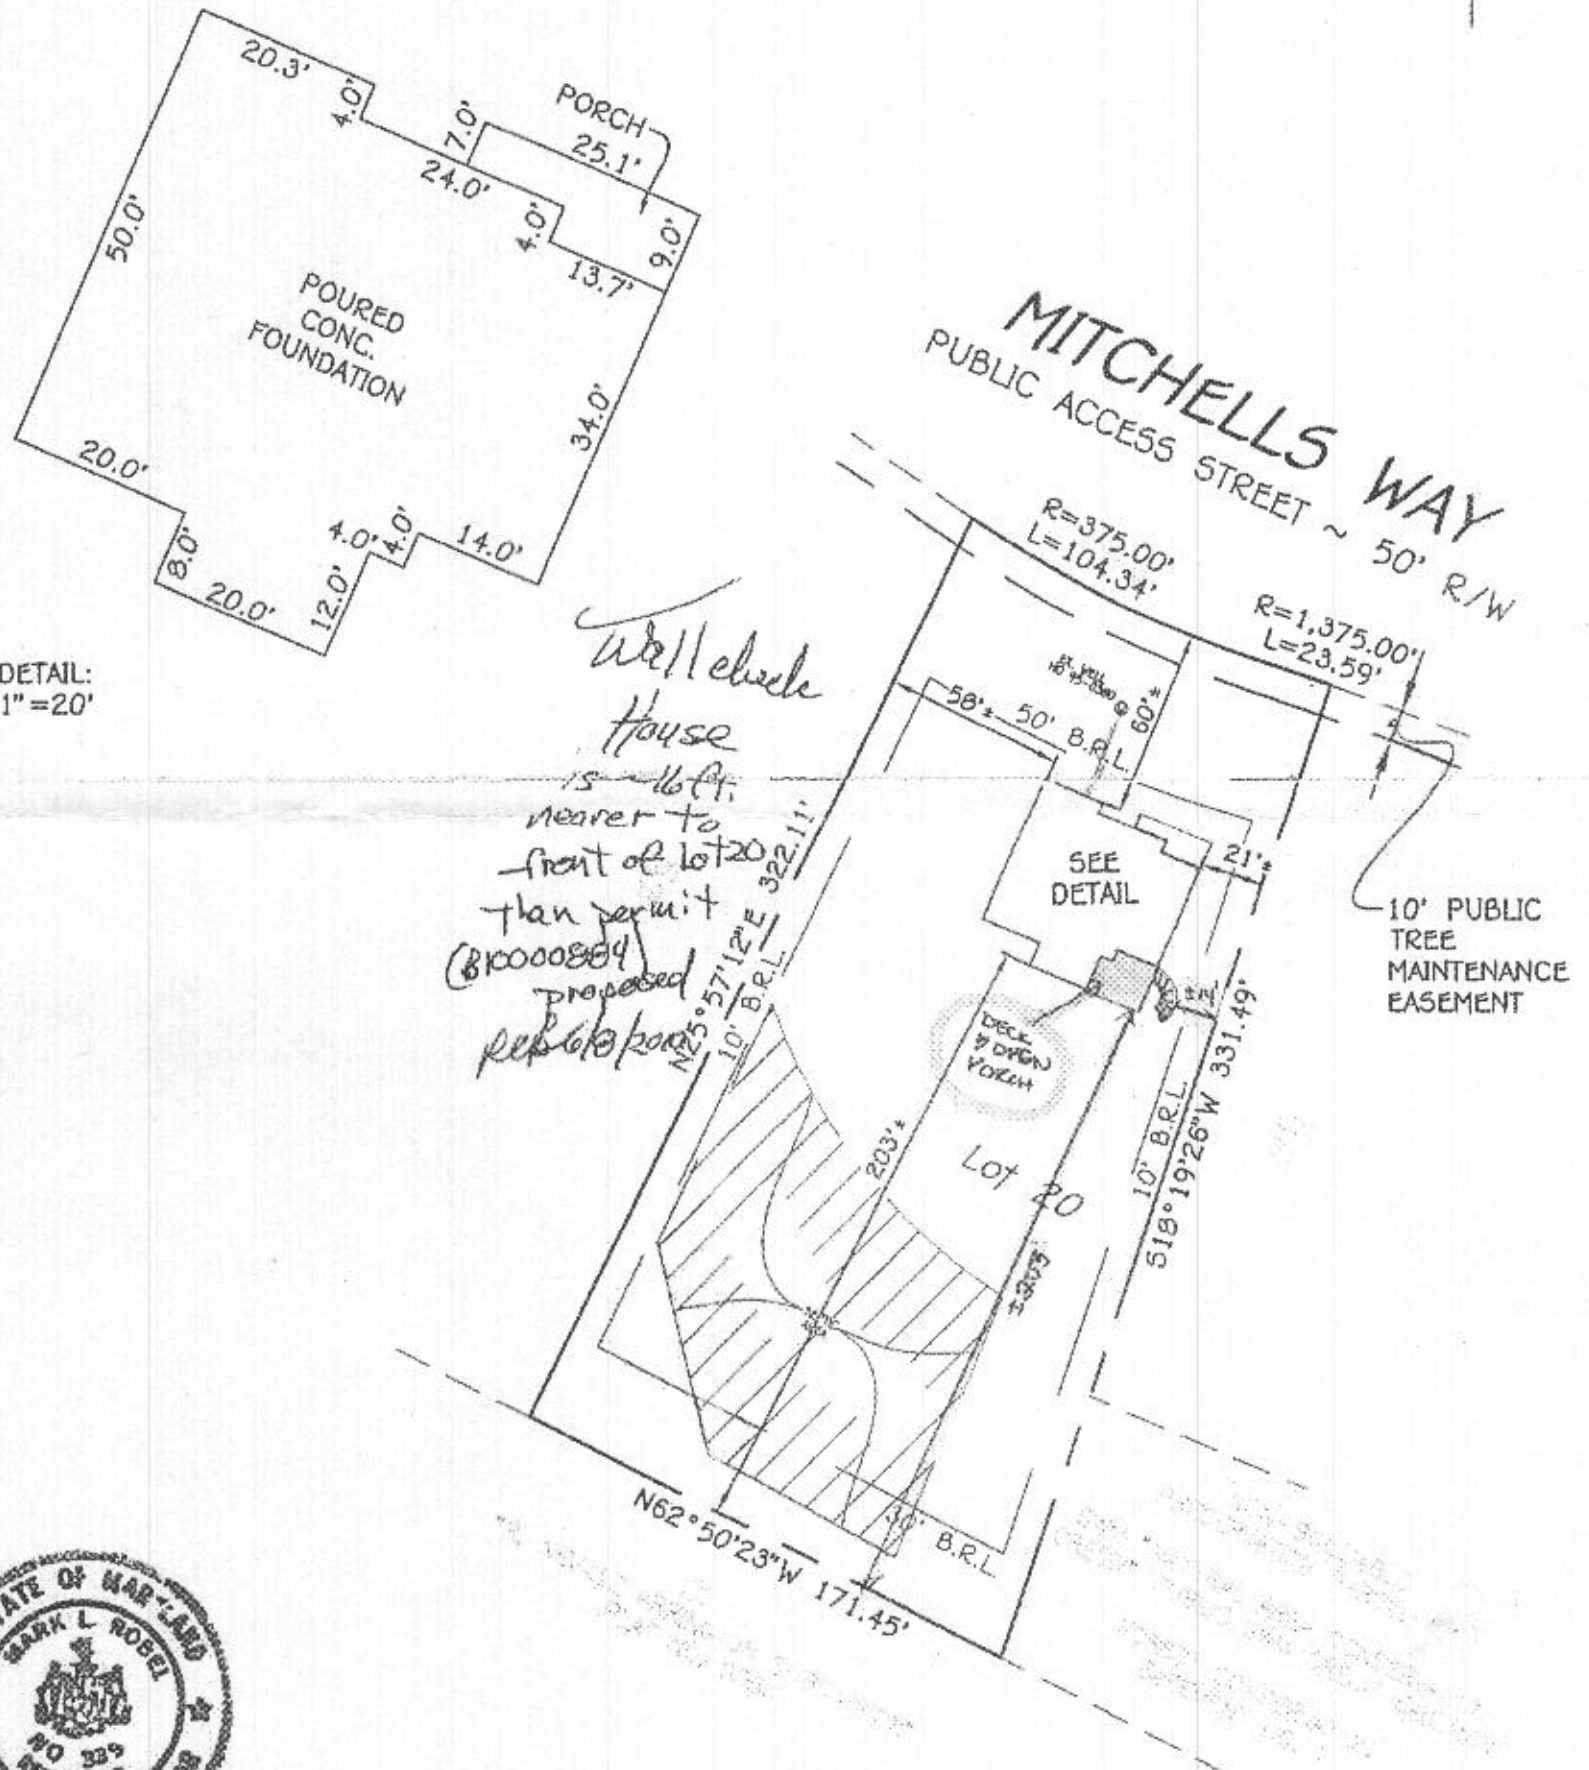

*Mark L. Roebel* 6/07/10  
PROFESSIONAL LAND SURVEYOR DATE  
REG. # 339

**FISHER, COLLINS & CARTER, INC.**  
CIVIL ENGINEERING CONSULTANTS & LAND SURVEYORS  
CENTENNIAL SQUARE OFFICE PARK - 10272 BALTIMORE NATIONAL PIKE  
BELLICOTT CITY, MARYLAND 21042

LOT 20  
CLOVERFIELD  
LOTS 1-21, BUILDABLE  
PRESERVATION PARCEL A,  
NON-BUILDABLE PRESERVATION  
PARCELS B-E & NON-BUILDABLE  
BULK PARCEL F  
3RD ELECTION DISTRICT  
HOWARD COUNTY, MARYLAND  
PLAT #18953-18959  
#13511 MITCHELLS WAY  
B.R.L.= BUILDING RESTRICTION LINE  
TOP OF FOUNDATION ELEV.= 556.1'  
BUILDING PERMIT #B10000884

**HOUSE LOCATION  
DRAWING**

FOUNDATION LOCATION: 6/2/10  
FINAL LOCATION: \_\_\_\_\_  
BOUNDARY SURVEY: \_\_\_\_\_

SCALE: 1"=60'  
DATE: 6/7/10  
DRAWN BY: *V.J.*  
CHECKED BY: *MLR*  
PROJECT No.: 30757-1001