

Fogle's Septic Clean Inc.

Fogle's Portable Toilets • Fogle's Well Drilling LLC • Fogle's Excavating, LLC



November 6, 2017

Howard Co Dept of Environmental Health
8930 Stanford Blvd
Columbia, Md 21045

To Whom it may concern,

On October 25th 2017 Fogle's Septic Clean Inc, has pumped, crushed and filled in to abandon the septic tank and drywell located at 7831 Harriett Tubman Lane in Columbia for Bryan Pass.

If you have any questions please call me at the office 410-795-5670.

Sincerely,

A handwritten signature in black ink that reads "Kurt Cassell". The signature is written in a cursive style with a large, sweeping "K" and "C".

Kurt Cassell
Fogle's Septic Clean, Inc.

WATER WELL ABANDONMENT-SEALING REPORT FORM

SUBMIT COPIES OF COMPLETED FORM TO:

- * COUNTY ENVIRONMENTAL AGENCY (contact MDE, WMA if address needed)
- * WELL OWNER
- * MDE, WATER MANAGEMENT ADMINISTRATION, WELL PROGRAM

DATE WELL ABANDONED: 10-12-17 (month/day/year)

* PERMIT NUMBER OF ABANDONED WELL (if any)

HA 73-4397

* PERMIT NUMBER OF REPLACEMENT WELL:

- N/A -


* PERSON ABANDONING WELL: Andrew Houseman WELL DRILLER'S LICENSE NUMBER: 224

CIRCLE: MWD / MSD / MGD

* OWNER'S NAME: Bryan Pass

SITE LOCATION MAP

* WELL LOCATION:
COUNTY: Howard
NEAREST TOWN: Columbia
TAX MAP 0035 BLOCK 0023 PARCEL 0117
SUBDIVISION:
SECTION: LOT:
STREET ADDRESS: 7831 Harriett Tubgen Ln

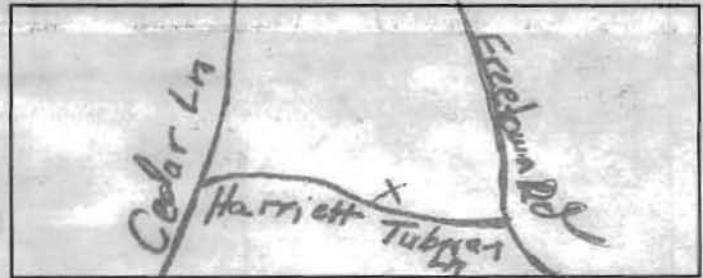

LATITUDE 3 9.187732

LONGITUDE 7 6.889015

LOG OF SEALING MATERIAL

MATERIAL	FEET	
	FROM	TO
<u>Bentonite</u>	<u>260</u>	<u>0</u>
VOLUME OF MATERIAL USED		
<u>2750 lb. Bentonite</u>		

* TYPE OF WELL BEING ABANDONED:
 DRILLED JETTED
 BORED HAND DUG
 OTHER (specify) _____

* USE CODE:
 DOMESTIC MUNICIPAL/PUBLIC
 IRRIGATION INDUSTRIAL
 TEST/OBSERVATION GEOTHERMAL

* TYPE OF CASING:
 STEEL PLASTIC
 CONCRETE OTHER (specify) _____

SIZE OF CASING: 6" INCHES IN DIAMETER

DEPTH OF WELL: 260' FEET DEEP

WAS ANY CASING REMOVED? YES NO
If yes, length removed, in feet: 2

WAS CASING RIPPED OR PERFORATED? YES NO

SIGNATURE-MASTER WELL DRILLER OR SUPERVISING SANITARIAN: Andrew Houseman

224

MWD MSD MGS

10-12-17

CIRCLE ONE

DATE

COUNTY

COUNTY

Pursuant to § 10-624 of the State Govt. Article of the Maryland Code, personal info requested on this form is used in processing this form pursuant to COMAR 26.04.04. Failure to provide the info may result in this form not being processed. You have the right to inspect, amend, or correct this form. The Maryland Department of the Environment is subject to the Maryland Public Information Act. This form may be made available on the Internet via MDE's website and is subject to inspection or copying, in whole or in part, by the public and other governmental agencies, if not protected by federal or State Law.