


SITE INSPECTION SHEET

OWNER: Michael & Janet Mastroianni PHONE #: _____

ADDRESS: 2868 Glenwood Springs CONTRACTOR: A & S Pools
Glenwood MD 21738 WELL TAG #: HO-81-2744

SUBDIVISION: Glenwood Springs LOT: 19 COUNTY #: _____

PROPOSAL: Pool contractor (Anthony & Sylvan) claim
that well location is inaccurately illustrated
in Health Dept. records. LOCATION DIAGRAM

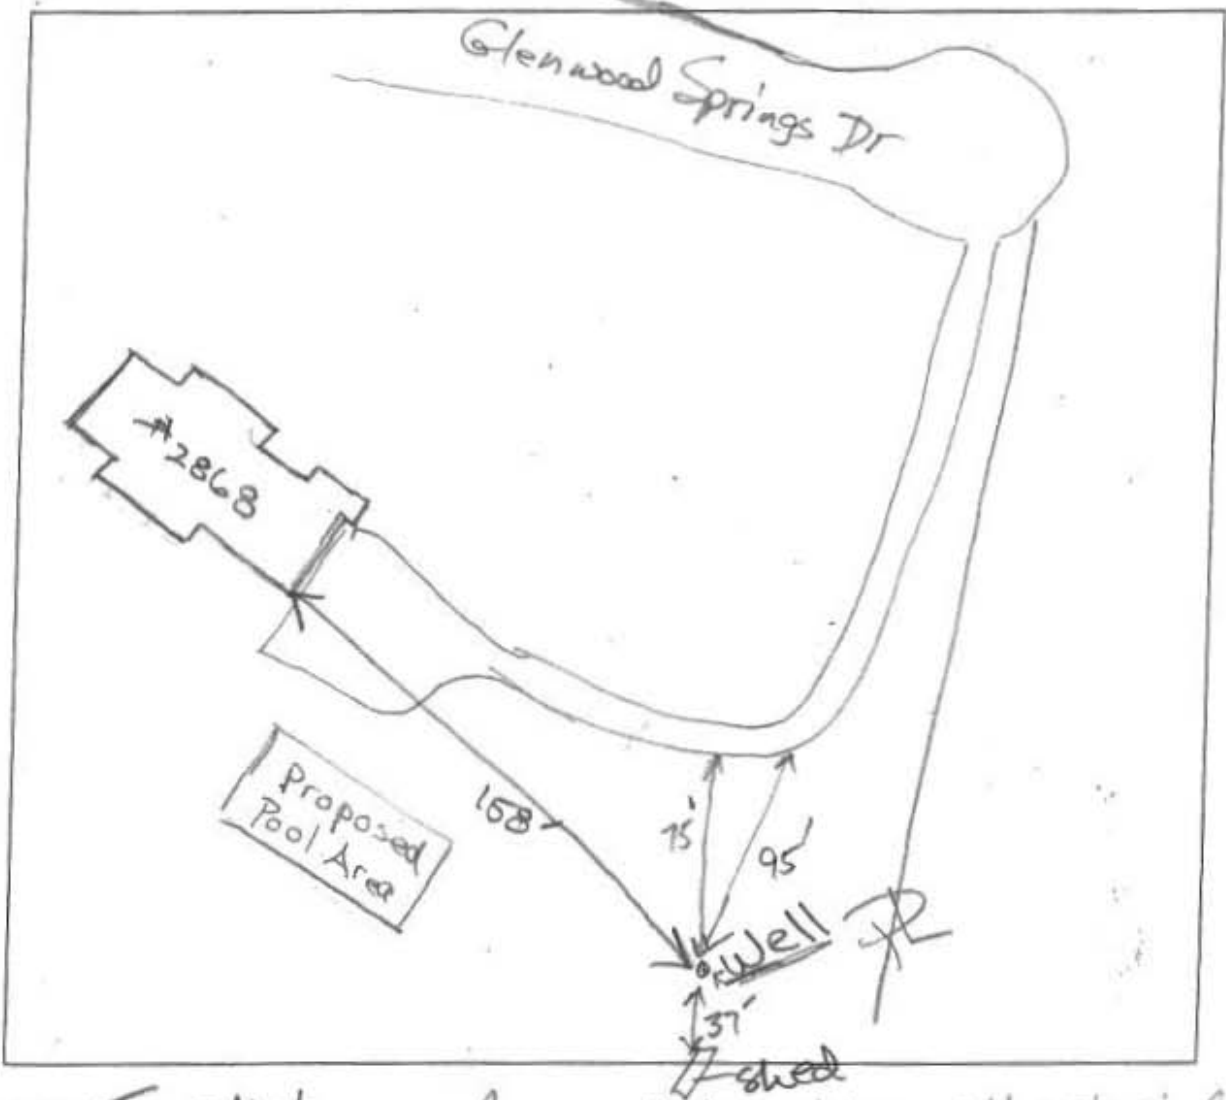

COMMENTS: Tape distances for well location illustrated.
Steel casing to 8" above grade, 1-pc metal cap broken,
electrical wiring exposed.

DATE: 9/20/2010 INSPECTOR: R Bricker