

APPLICATION

HOWARD COUNTY

SERIAL NUMBER

PERMIT APPLICATION

DEPARTMENT OF INSPECTIONS, LICENSES & PERMIT
3430 COURT HOUSE DRIVE, ELLICOTT CITY, MARYLAND 21043

61609

BUILDING ADDRESS (HOUSE NO., STREET, TOWN OR AREA)

18150 Sun Drop Rd
Md. Bldg. Wd. 21771

GRADING/SEDIMENT CONTROL YES NO

SDP#

DESCRIPTION OF WORK AUTHORIZED

1 story Single Family Home
on slab, 2 Bedrooms, 1 Bath

LOT NO. PARCEL NO. SEC. AREA BLOCK NO. LIBER FOLIO

10

SUB DIVISION ZONE ZONE MAP ELEC. DIST. CENSUS TR.

R 6 4 6040

OWNER NAME AND ADDRESS PHONE NO.

Richard Burroughs 301-829-5035
5209 Green Valley Rd
Monrovia MD 21770

SIZE OF BLDG. FRONT DEPTH HEIGHT

24x40' 40' 24' 14'

OCCUPANT'S NAME AND ADDRESS PHONE NO.

Mr. Owner

TYPE OF BLDG. AREA VOLUME ROOF

B. ROOMS 2
ROOMS 6
BATHS 1
FIREPLACES 0

ARCHITECT OR ENGINEER'S NAME AND ADDRESS PHONE NO.

owner

FOOTINGS* FOUNDATION S. WALLS

Concrete

CONTRACTOR'S NAME AND ADDRESS PHONE NO.

Owner acting as general contractor 301-829-5035

UTILITIES

WATER/WELL SEWER/SEPTIC GAS ELECTRICITY TYPE OF HEAT AC
X X X FHW

EXISTING USE PROPOSED USE

vacant lot New Dwelling Single Family Home

I have carefully examined and read this application and know the same is true and correct, and that in doing this work, all provisions of Howard County Ordinances and the State Laws of Maryland will be complied with, whether specified or not; and I will notify the Department of Inspections, and Permits twenty-four hours in advance when I am ready for the inspections called for elsewhere in the application; and that no work will be covered up until such inspections have been completed with.

EST. CONSTRUCTION COST LICENSE NUMBER PERMIT FEE

\$30,000

SIGNATURE DATE

Owner 4-5-75

FOR OFFICE USE ONLY

DISTANCE IN FEET FROM R/W LINE TO FRONT BUILDING LINE

SIDE YARD (DISTANCE IN FEET FROM SIDE BLDG. LINE TO SIDE PROPERTY LINE)

TO SIDE BUILDING LINE (DISTANCE IN FEET, REAR YD. REQUIRING SET

BACK (CORNER LOT ONLY) SDP#

Check payable to: DIRECTOR OF FINANCE OF HOWARD COUNTY


CAUTION
To begin construction before a permit placard has been issued and displayed on the job is a violation of the law.
Use and occupancy permit must be applied for two weeks before it will be issued.

FUNCTION DATE SIGNATURE APPROVAL

ZONING/PLANNING		
SHA		
SEDIMENT/GRADING		
BUILDING OFFICIAL		
WATER & SEWER		
HEALTH DEPT.	X 9-26-75	Del. Boyer
FIRE PROTECTION		
STORM WATER MGMT.		


IMPORTANT: PLEASE SHOW ZIP CODES AND AREA CODES WHEREVER REQUIRED.

APPROVED DATE

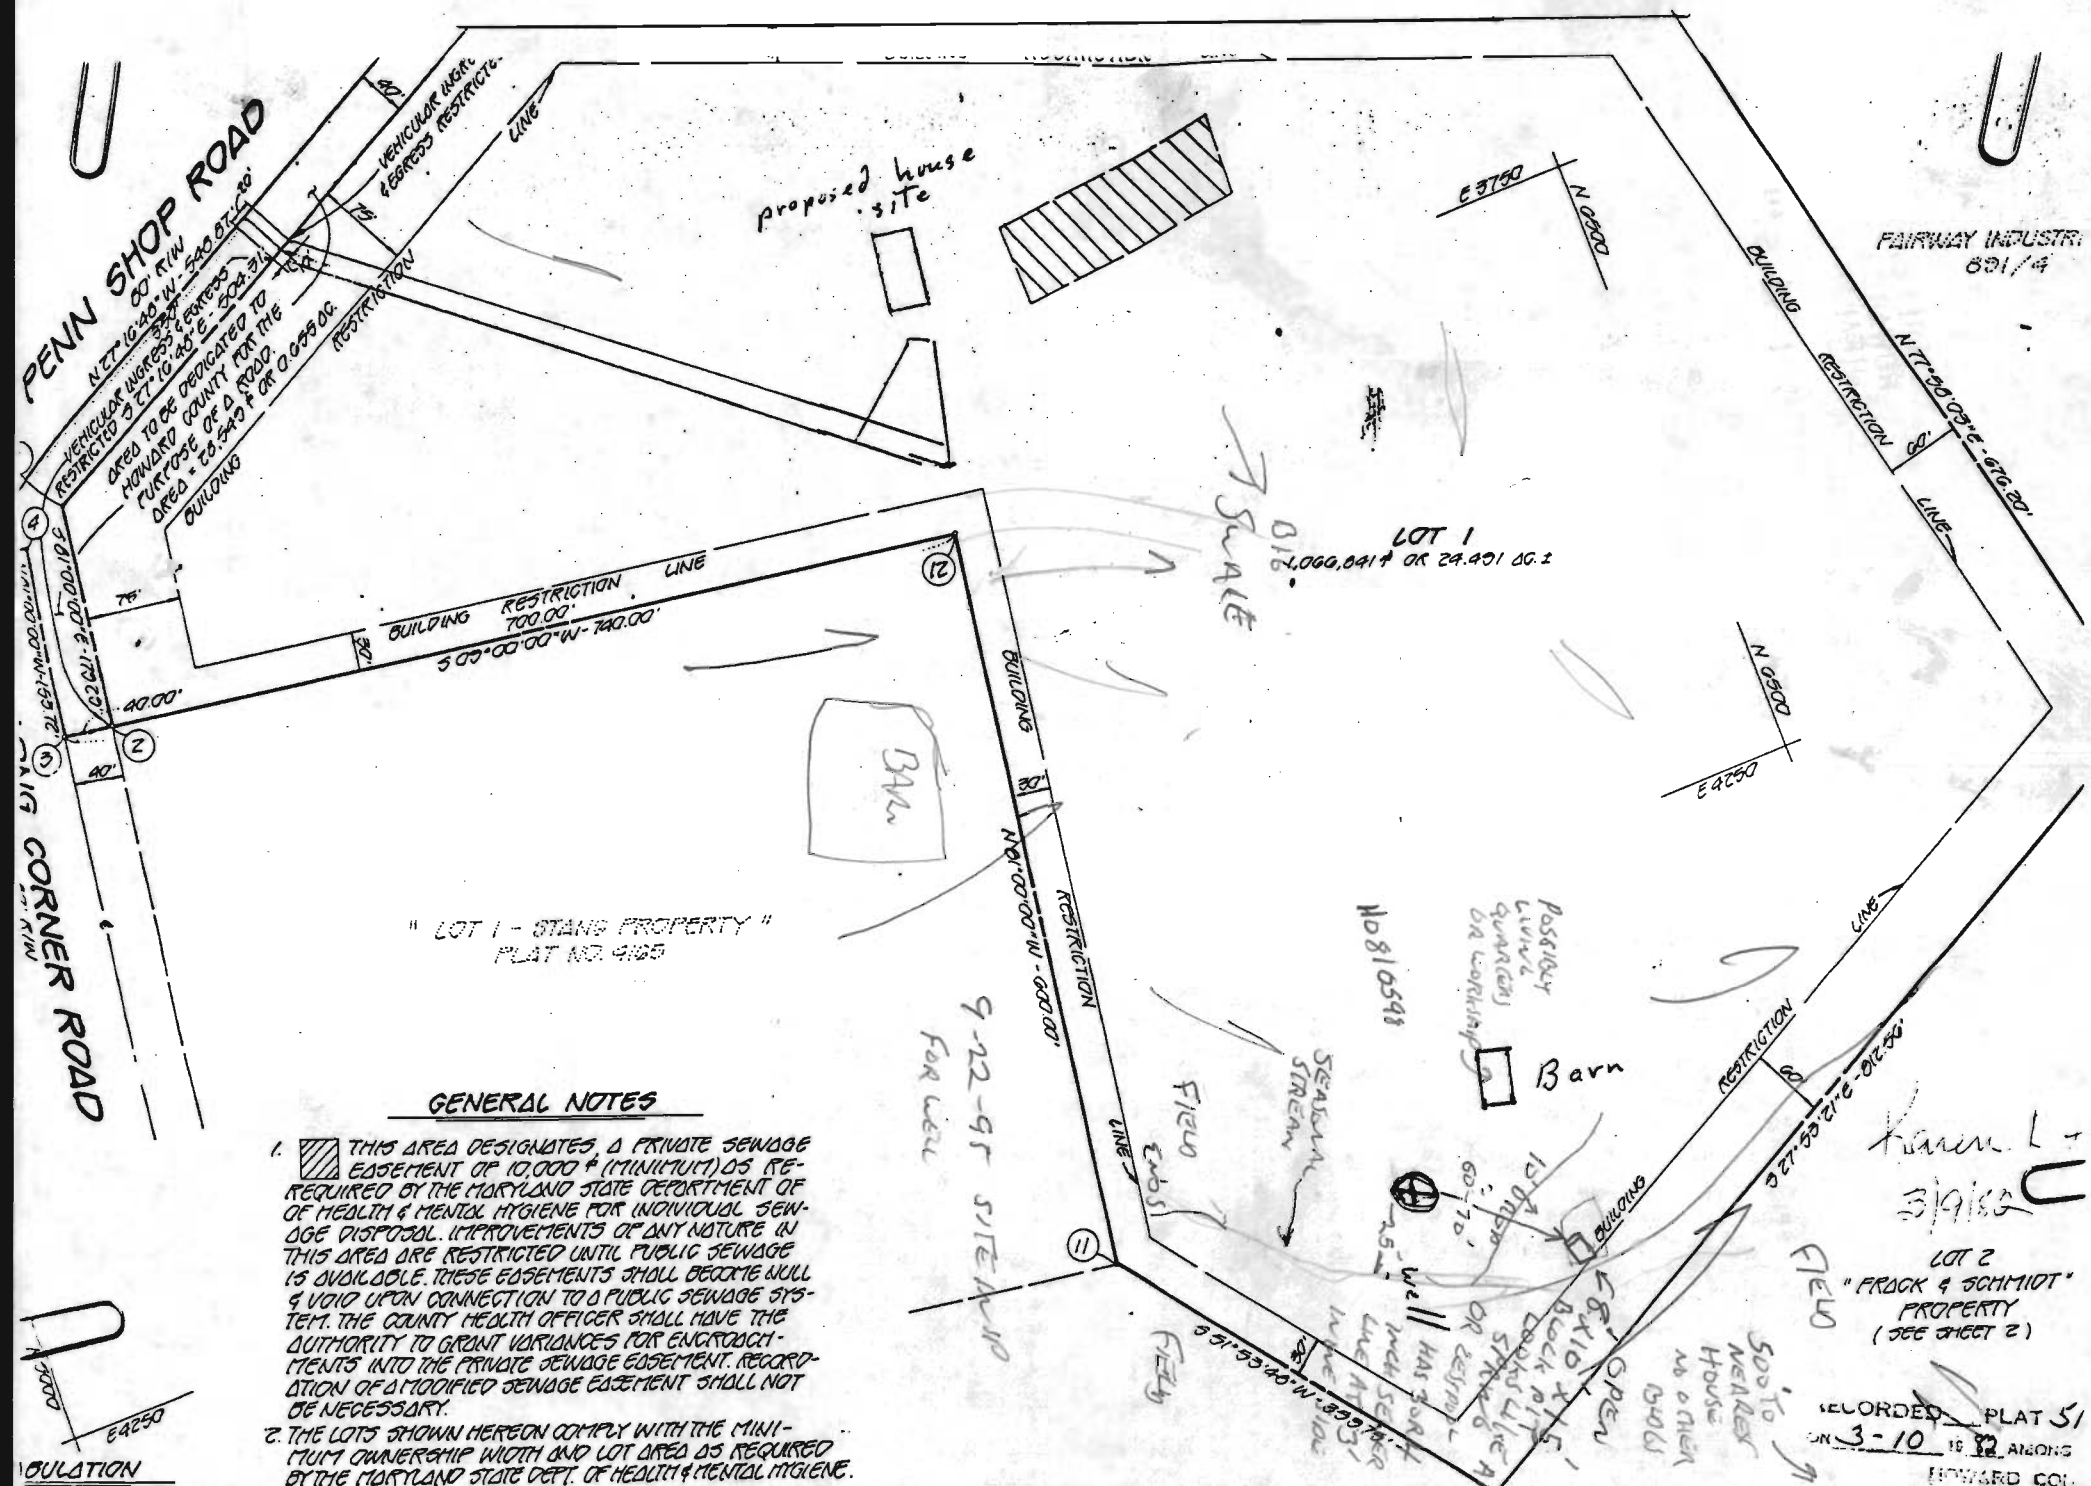


" LOT 1 - STANG PROPERTY " PLAT NO. 9185

GENERAL NOTES

-  THIS AREA DESIGNATES A PRIVATE SEWAGE EDGEMENT OF 10,000 # (MINIMUM) AS REQUIRED BY THE MARYLAND STATE DEPARTMENT OF HEALTH & MENTAL HYGIENE FOR INDIVIDUAL SEWAGE DISPOSAL. IMPROVEMENTS OF ANY NATURE IN THIS AREA ARE RESTRICTED UNTIL PUBLIC SEWAGE IS AVAILABLE. THESE EDGEMENTS SHALL BECOME NULL & VOID UPON CONNECTION TO A PUBLIC SEWAGE SYSTEM. THE COUNTY HEALTH OFFICER SHALL HAVE THE AUTHORITY TO GRANT VARIANCES FOR ENCROACHMENTS INTO THE PRIVATE SEWAGE EDGEMENT. RECORDATION OF A MODIFIED SEWAGE EDGEMENT SHALL NOT BE NECESSARY.
- THE LOTS SHOWN HEREON COMPLY WITH THE MINIMUM OWNERSHIP WIDTH AND LOT AREA AS REQUIRED BY THE MARYLAND STATE DEPT. OF HEALTH & MENTAL HYGIENE.

Karen L +
 3/9/02
 LOT 2
 "FRACK & SCHMIDT"
 PROPERTY
 (SEE SHEET 2)
 RECORDED PLAT 51
 ON 3-10 19 82 ALONG
 HOWARD CO.

1 in = 100 ft

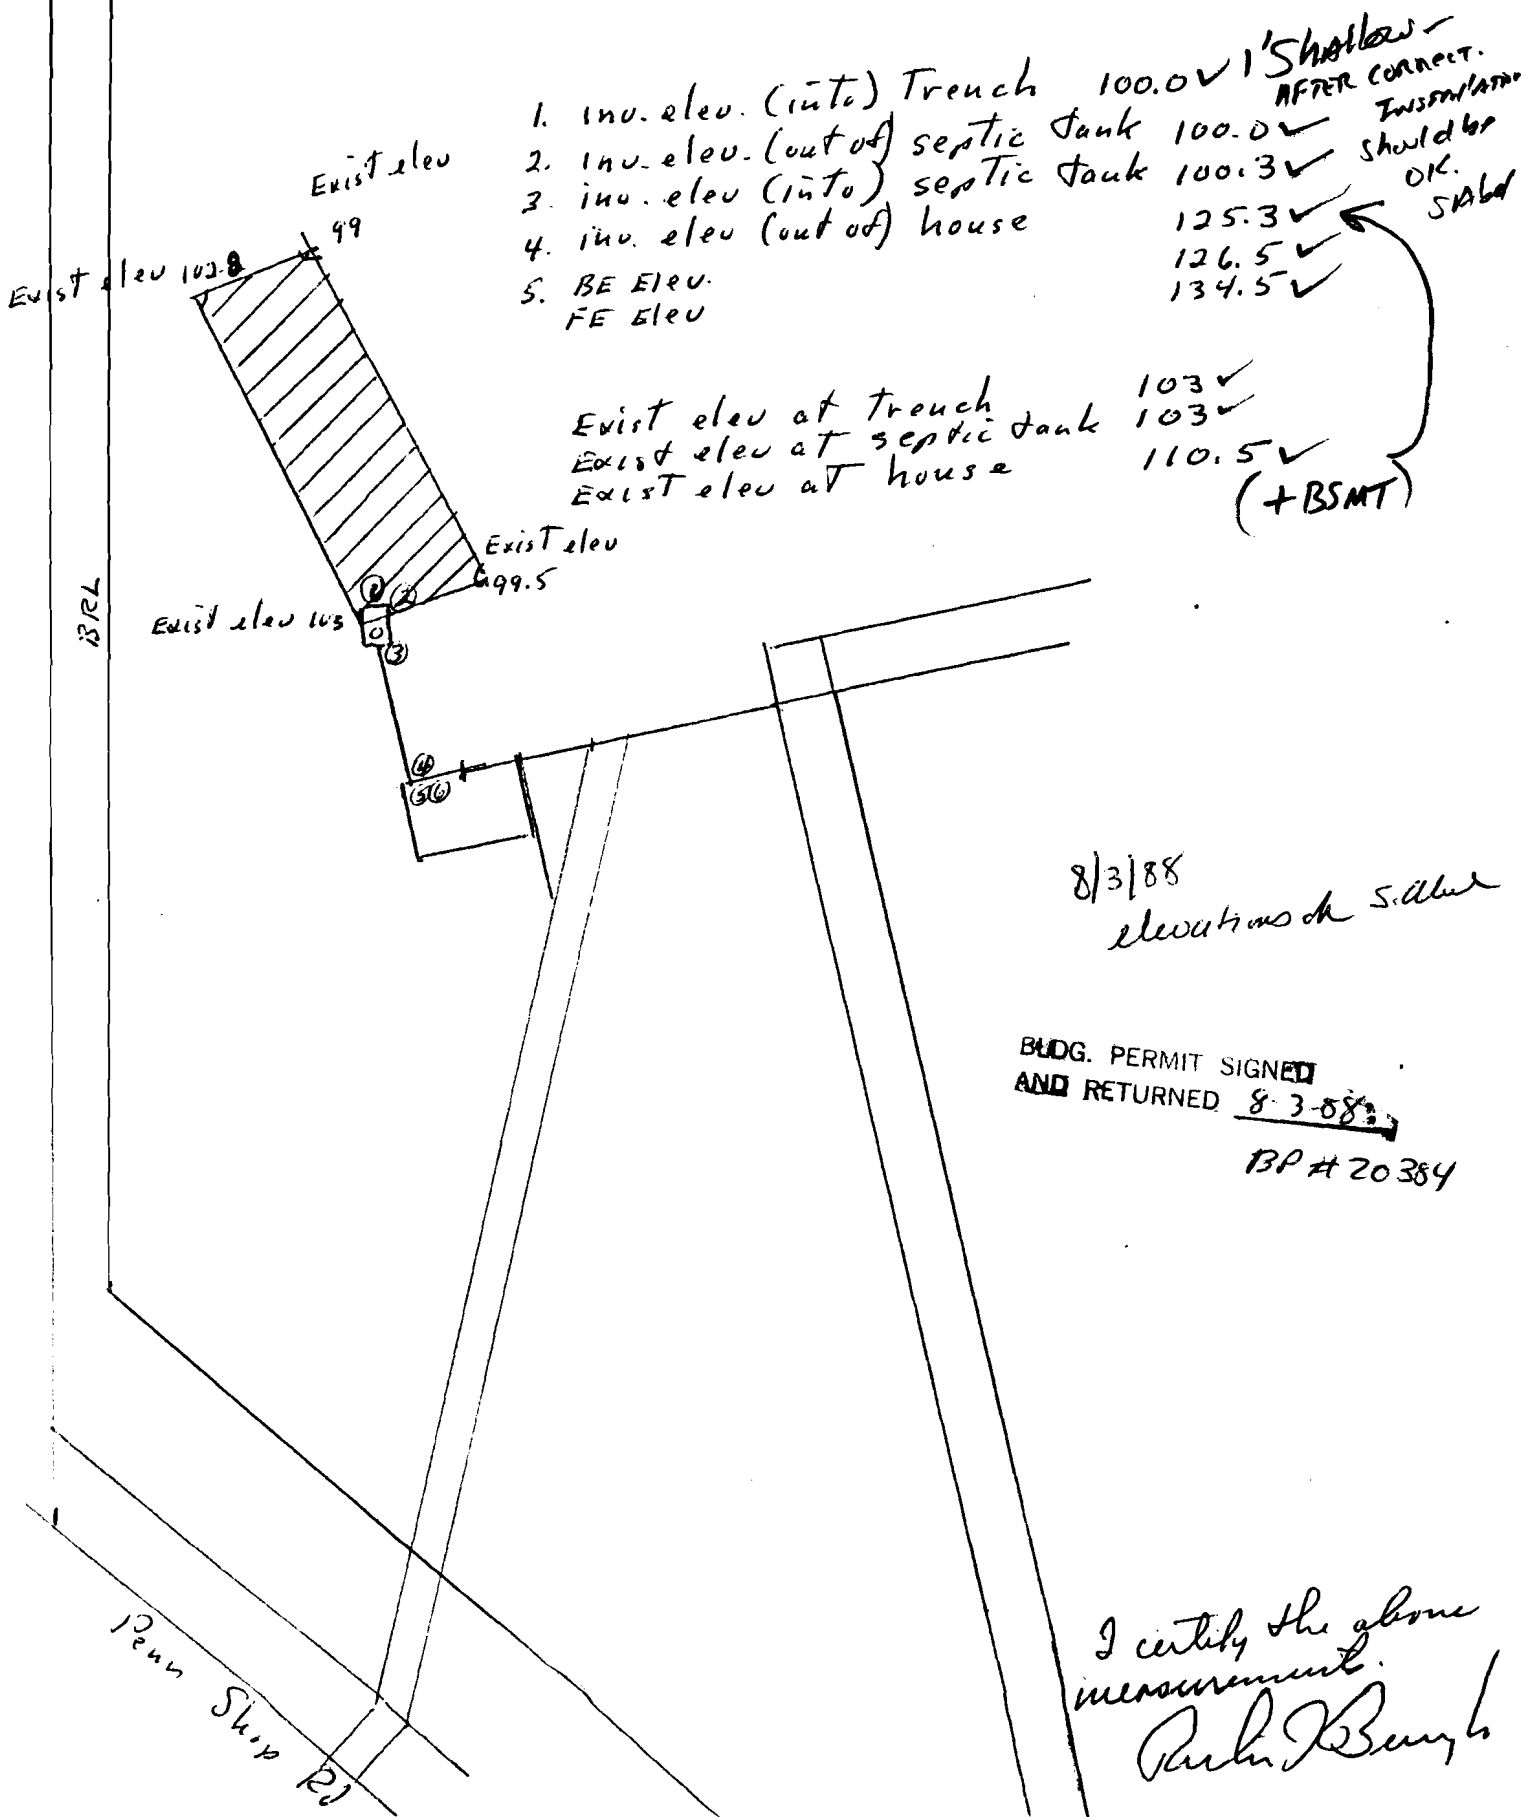

1. inv. elev. (into) Trench 100.0 ✓ 1' Shallow - AFTER CORRECT. INSULATION
2. inv. elev. (out of) septic tank 100.0 ✓
3. inv. elev (into) septic tank 100.3 ✓ Should be OK.
4. inv. elev (out of) house 125.3 ✓
5. BE ELEV. 126.5 ✓
- FE ELEV 134.5 ✓

Exist elev at Trench 103 ✓
 Exist elev at septic tank 103 ✓
 Exist elev at house 110.5 ✓
 (+BSMT)

8/3/88
 elevations ok S. Allen

BUDG. PERMIT SIGNED
 AND RETURNED 8-3-88
 BP # 20384

I certify the above
 measurement.
 Paul Bunch

PENN SHOP ROAD, BP 61609

Howard County Health Department

To: FILE HOLD

- DISTANCES: HOUSE TO TANK?
HOUSE TO SDA?
- ELEVATIONS FOR S.S. INCORRECT
- ~~LETTER REQUESTED~~ WELL
WAS DRILLED FOR FARM USE
CHECK W/ MR ON PROCEDURES

OWNER NOT NOTIFIED - DISCUSS W/ STACEE FIRST

From: GS

Date: 9/15/95

HD-170

IMPORTANT MESSAGE

OWNER
TO DISCUSS 9/26 1PM

CONVERT AG WELL TO
DOMESTIC - ADD LETTER
GEN HAS
9 26 95

REFINE ELEU DRAWING
OK (SEATTLE PLANS)

~~6871 MANUFACTURED ROAD BP 61485~~

BP 61609 PENN SHOP LOT 1

- perc notes match file
- specs match BP plan
- septic system 100' from well
- ST 10' off house
- SDA 20' off house
- well location OK
- completion report in file
- completion reoprt checked
- location of SDA OK
- elevations OK
- manhole c/o required? ^{16'} 7'3' COVER ^{NOTE} _{on plan}
- inv. out of house 18'' below grade
- invert into trench OK _{from ground level}
- length of trench to be determined statement
- write linear ft of trench required on spec sheet
- approval stamp on BP plan
- BP pink sheet signed
- written in log book